

WOOD GUARD RAIL REQUIRED.

Left
Sta. 926+95 to 927+15 Length 24 ft

Right
Sta. 926+55 to 927+15 Length 24 ft

NEW CULVERTS REQUIRED

Sta 927+07 18" Reinf. Concrete Pipe Culvert 40 ft
Concrete Class B (1-2 1/2-5) 1.9 cu yds.
Reinforcing Steel 33 pounds.

NEW DRIVEWAY CULVERTS REQUIRED

Sta 920+12 Left: New 12" Ditt. Oak Metal Pipe Length: 20 ft
Concrete Class B (1-2 1/2-5) 1.1 cu yds.



DRIVEWAY CULVERTS TO BE RETAINED

Sta 921+70 Left 12" Concrete Pipe
To be retained
Build New Headwalls
Concrete Class B (1-2 1/2-5) 1.1 cu yds.
Sta 924+50 Left 18" C.M.P. Tube retained
Build New Headwalls
Concrete Class B (1-2 1/2-5) 1.1 cu yds.

SUB-BASE OF GRAVEL REQUIRED

Sta. 916+00 to 927+00 6" Sub-base of gravel 1100 ft.

FED. ROAD DIST. NO.	STATE	FED. AID PROJ. NO.	FISCAL YEAR	SHEET NO.	TOTAL SHEETS
9	I.V.T.	718	1928	33	104

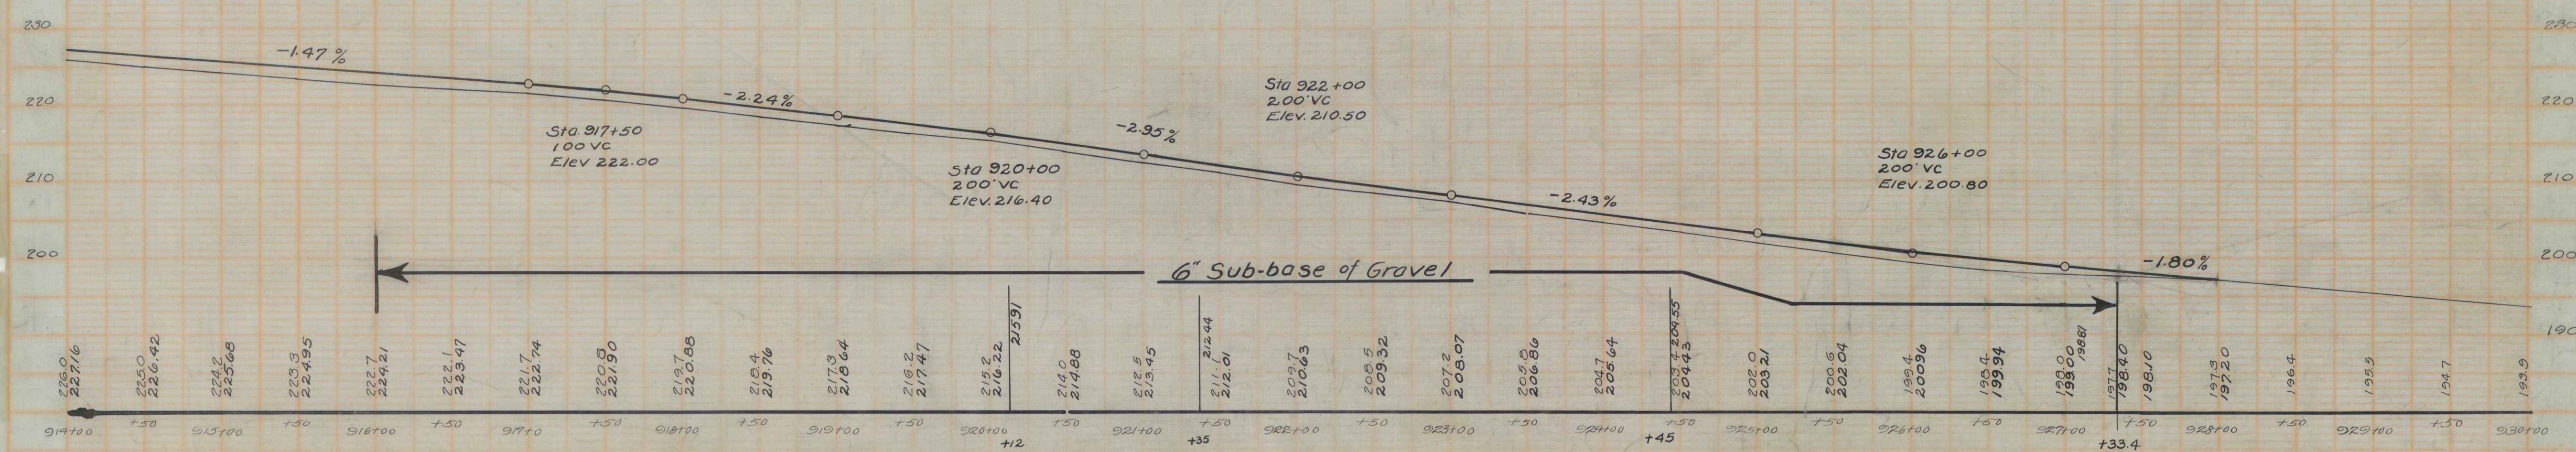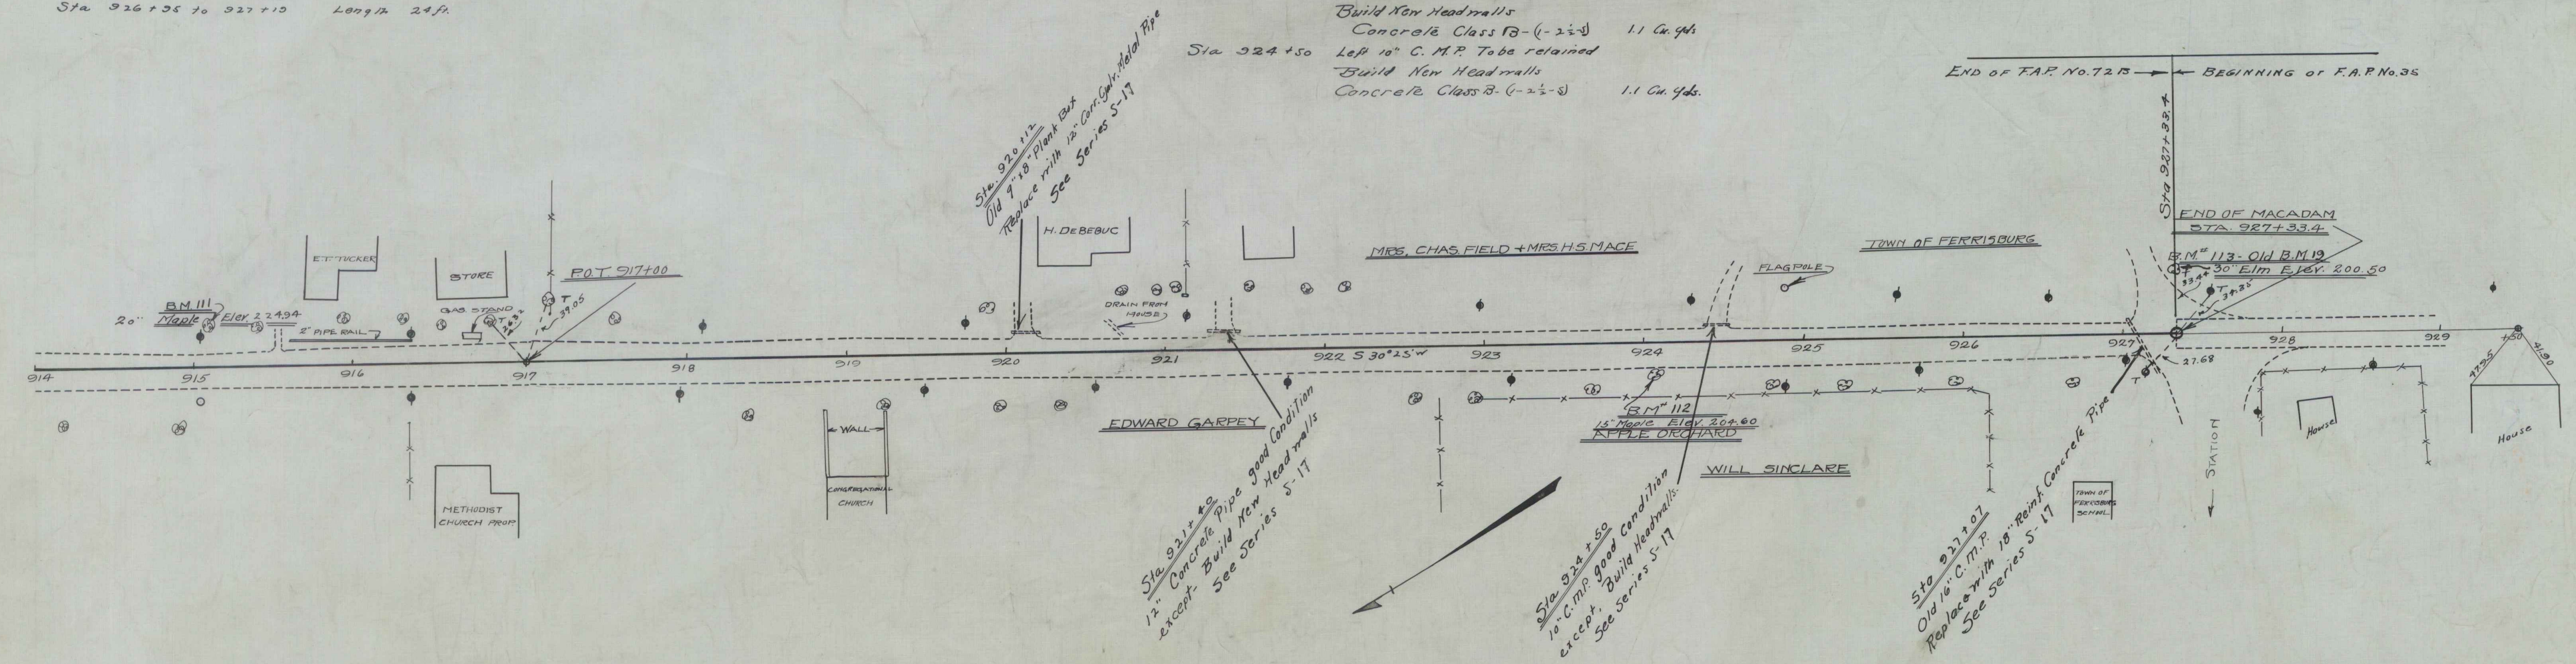

B.M. No. 111 Spike in 20" Maple Left of Sta. 915+11 Elev. 224.34
B.M. No. 112 " 18" Elm Right " 924+06 " 204.60
B.M. No. 113 Old B.M. No. 10 Spike in 30" Elm Left of Sta. 927+33 Elev. 200.50

Series F No. 72.8
Sheet 33 of 104