


INDEX OF SHEETS

SHEET NO.	TITLE PAGE
" 2	TYPICAL CROSS-SECTION OF IMPROVEMENT (CONCRETE-PAVE
" 3	" " " " " " (BITUMINOUS MAC
" 4	PLAN AND PROFILE STA. 474+00 TO STA. 485+00
" 5	" " " " " " 485+00 " " 500+00
" 6	" " " " " " 500+00 " " 515+00
" 7	" " " " " " 515+00 " " 530+00
" 8	" " " " " " 530+00 " " 545+00
" 9	" " " " " " 545+00 " " 560+00
" 10	" " " " " " 560+00 " " 575+00
" 11	" " " " " " 575+00 " " 590+00
" 12	" " " " " " 590+00 " " 605+00
" 13	" " " " " " 605+00 " " 621+00
" 14	" " " " " " 621+00 " " 637+00
" 15	" " " " " " 637+00 " " 652+00
" 16	" " " " " " 652+00 " " 668+00
" 17	" " " " " " 668+00 " " 682+00
" 18	" " " " " " 682+00 " " 698+00
" 19	" " " " " " 698+00 " " 713+00
" 20	" " " " " " 713+00 " " 726+00
" 21	" " " " " " 726+00 " " 740+00
" 22	" " " " " " 740+00 " " 754+00
" 23	" " " " " " 754+00 " " 770+00
" 24	" " " " " " 770+00 " " 786+00
" 25	" " " " " " 786+00 " " 802+00
" 26	" " " " " " 802+00 " " 818+00
" 27	" " " " " " 818+00 " " 834+00
" 28	" " " " " " 834+00 " " 850+00
" 29	" " " " " " 850+00 " " 866+00
" 30	" " " " " " 866+00 " " 882+00
" 31	" " " " " " 882+00 " " 898+00
" 32	" " " " " " 898+00 " " 914+00
" 33	" " " " " " 914+00 " " 927+33.4

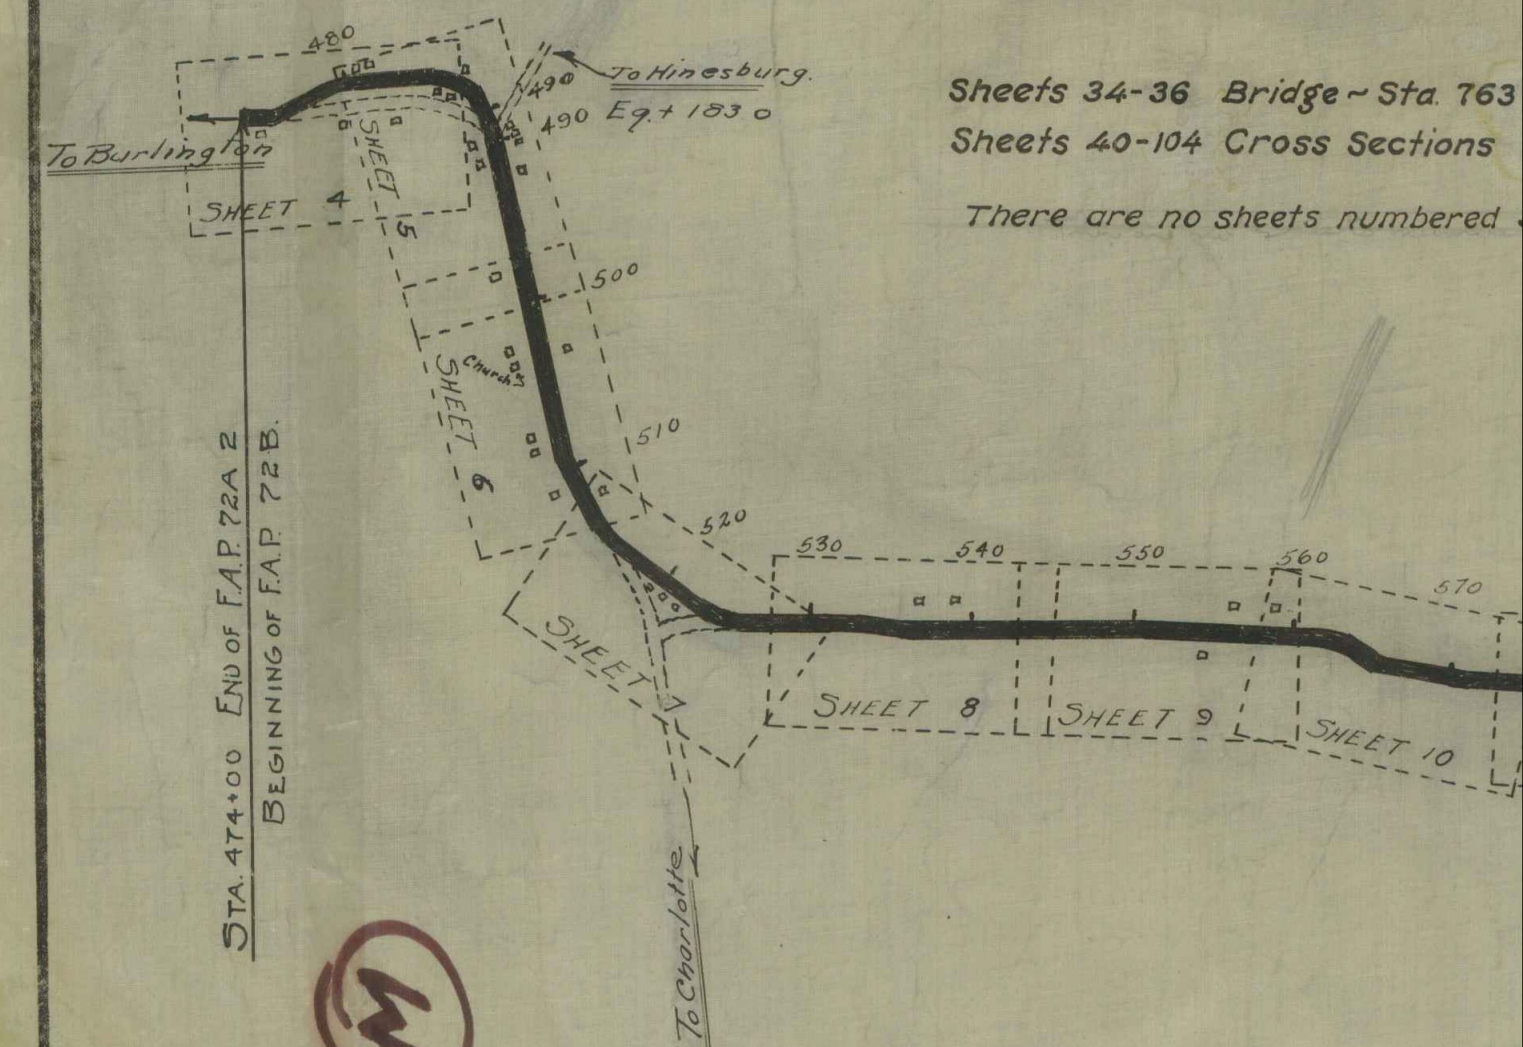


Sheets 34-36 Bridge - Sta. 763

Sheets 40-104 Cross Sections

There are no sheets numbered

CONVENTIONAL SIGNS

COUNTY LINE
TOWN LINE
FENCE LINE
STONE WALL
UNFENCED PROPERTY
GUARD RAIL
TRAVELED WAY
RAILROAD
RETAINING WALL
CENTER LINE
SURVEY LINE
CULVERT
DROP INLET
TROLLEY POLE
POWER POLE
TELEPHONE POLE
TREES
HEDGE

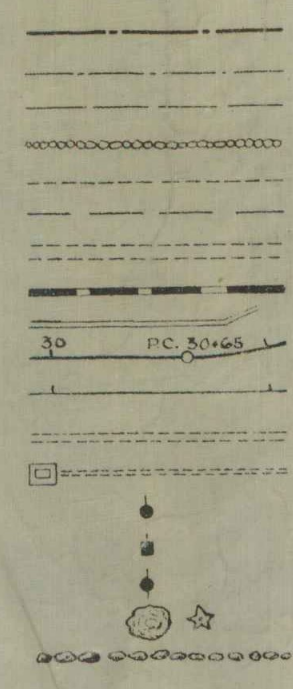

CHARLOTTE - FERRISBURG F 72 B
RECORD PLANS
CONTR. CARLO BLANCHI CO., INC.
FISCAL YEAR 1928

GROUND ELEVATION DATUM
GRADE ELEVATION DATUM
CURVE DATA
DEFLECTION ANGLE
DEGREE OF CURVE
RADIUS OF CURVE
TANGENT DISTANCE
LENGTH OF CURVE
EXTERNAL DISTANCE
POINT OF INTERSECTION
POINT OF CURVE
POINT OF TANGENT