



WOOD GUARD RAIL REQUIRED

LEFT
Sta. 529+76 to 530+00 Length 24 ft.
" 517+10 - 517+42 " 24 "
" 523+90 - 524+22 " 24 "
RIGHT
Sta. 529+76 to 530+00 Length 24 ft.

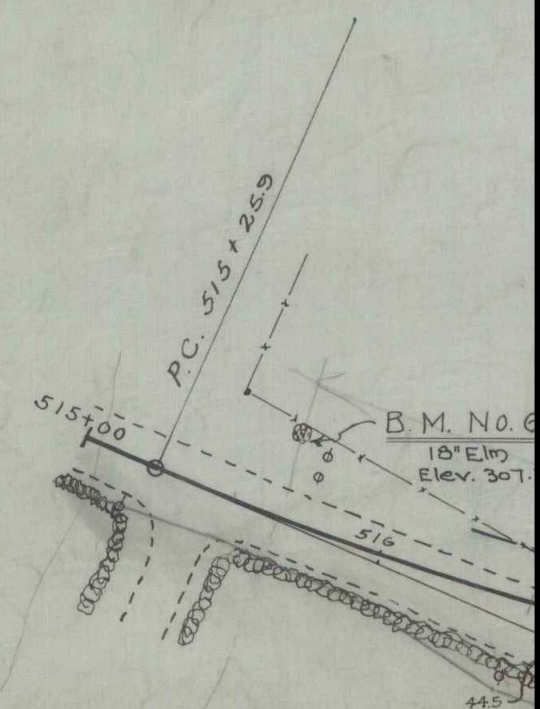

Sta. 515+00
Elev. 305.34
150' V.C.

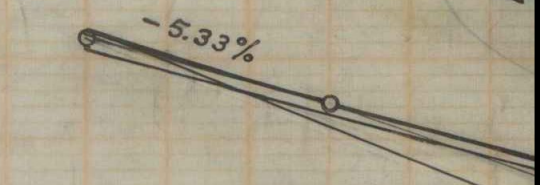

FOR ESTIMATE
ON "B" LINE

ELEVATIONS ON			
"B" LINE			
305.3	305.01	302.79	302.2
306.92	305.13	302.79	298.79
515	510	510	510

B.M. No. 69 Spike in 18" Elm. Left of Sta.
B.M. No. 70 Boulder in field. Left of
B.M. No. 71 Spike in 18" Elm. Right of