

WOOD GUARD RAIL REQUIRED.



LEFT
Sta. 532+88 to 533+12 Length 24 ft
" 535+38 " 535+62 " 24"
RIGHT
Sta. 532+88 to 533+12 Length 24 ft
" 535+38 " 535+62 " 24"

NEW CULVERTS REQUIRED.

Sta. 533+00 18" Reinf. Concrete Pipe Culvert 32 lin. ft
Concrete Class B (1-2-4) 2.7 Cu yds 2.5'
Reinforcing Steel 54 lbs
Sta. 535+50 15" Reinf. Conc. Pipe Culvert 32 lin. ft
Concrete Class B (1-2-4) 2.5 Cu yds
Reinforcing Steel 54 lbs

SUB-BASE OF GRAVEL REQUIRED.

Sta. 530+00 to 533+00 - 6" Sub-base of gravel 300
545+00 1500
Driveway Culverts
Sta. 537+16 - kept - Relay 25 ft of pipe
Concrete Class B (1-2-4) 1.4
Sta. 538+00 kept - Relay 20 ft of pipe
Concrete class B (1-2-4) 1.4

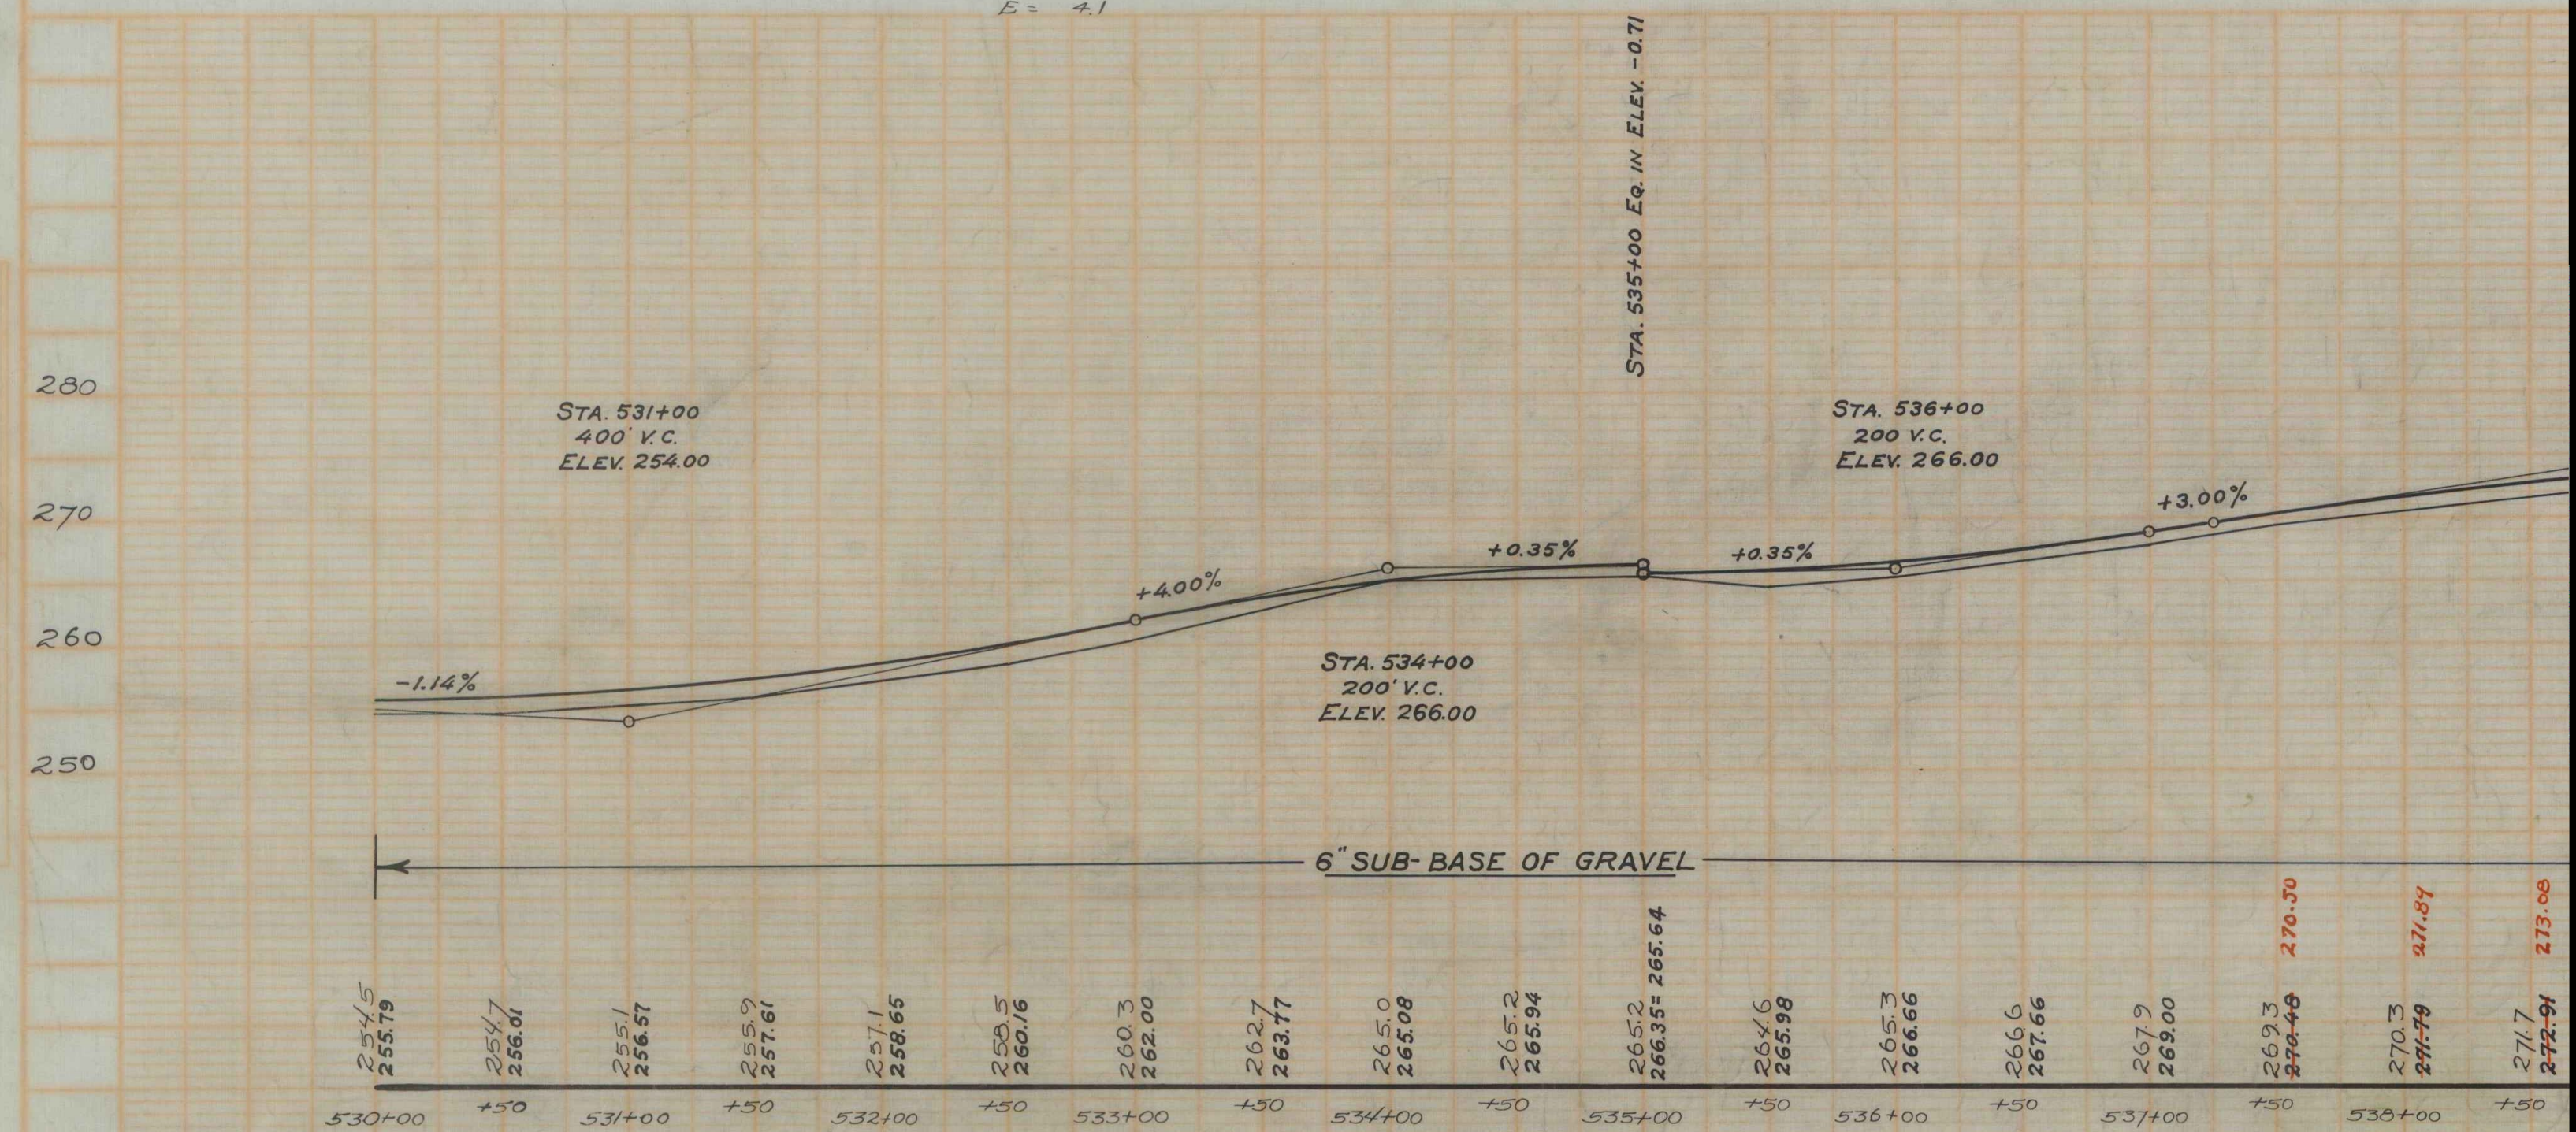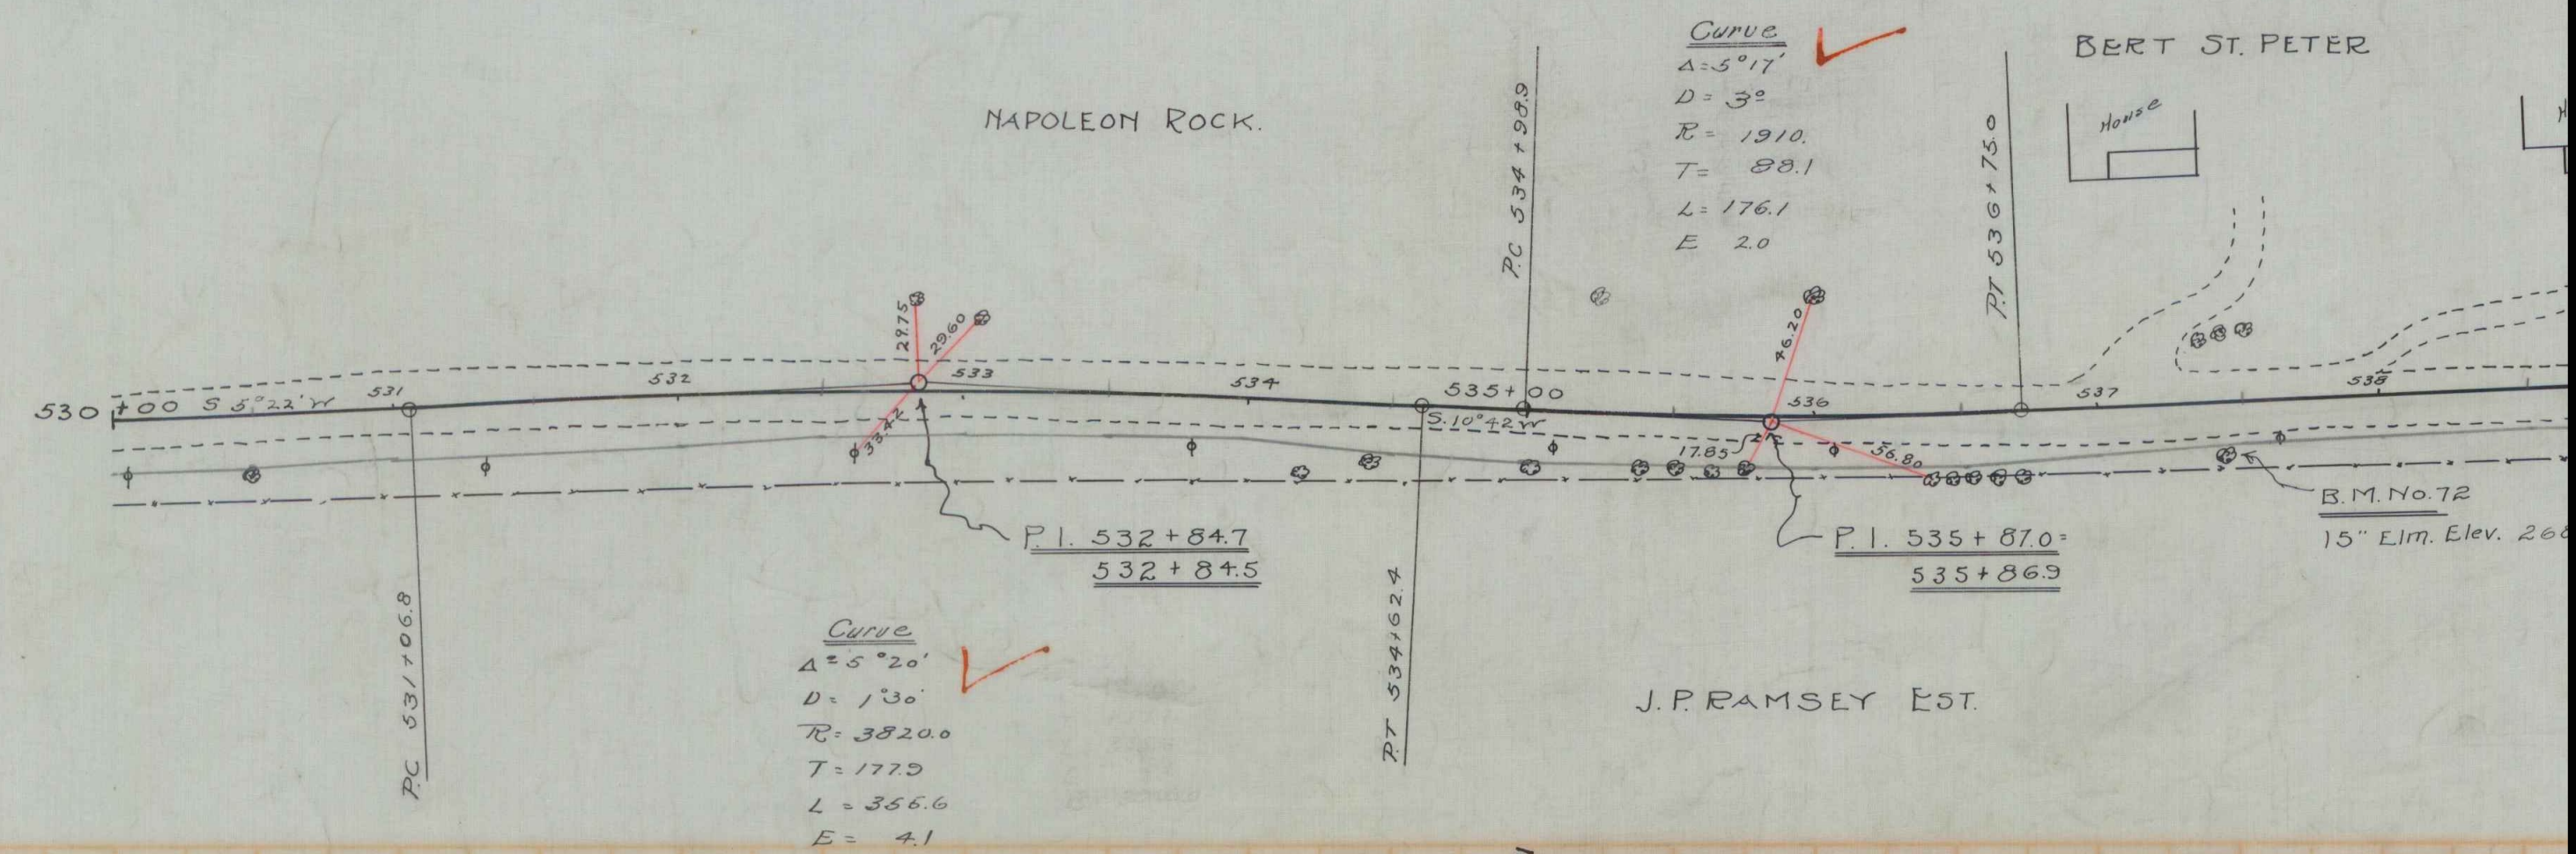

B.M. No. 72. Spike in 15' Elm. Right of Sta. 537+45, Elev. 268.39