



WOOD GUARD RAIL REQUIRED

LEFT				
Sta	550+36 to	550+60	Length	24 ft. ✓
"	554+38 "	555+22 "	"	24 " ✓
"	558+26 "	558+50 "	"	24 " ✓
"	559+80 "	560+00 "	"	20 " ✓

RIGHT				
Sta	550+36 to	550+60	Length	24 ft. ✓
"	554+38 "	555+22 "	"	24 " ✓
"	558+26 "	558+50 "	"	24 " ✓
"	559+80 "	560+00 "	"	20 " ✓

NEW CULVERTS REQUIRED.

Sta. 550+48 -	18" Rein. Concrete Pipe Culvert	33
	Concrete Class $\frac{3}{4}$ (1-2) ✓	33
	Reinforcing Steel	33
Sta. 555+10 -	24" Rein. Concrete Pipe Culvert	33
	Concrete Class A (1-2-3) ✓	33
	Reinforcing Steel	33
Sta. 558+38	18" Rein. Concrete Pipe Culvert	33
	Concrete Class $\frac{3}{4}$ (1-2) ✓	33
	Reinforcing Steel	33
Sta. 559+32	18" Rein. Concrete Pipe Culvert	33
	Concrete Class $\frac{3}{4}$ (1-2) ✓	33
	Reinforcing Steel	33

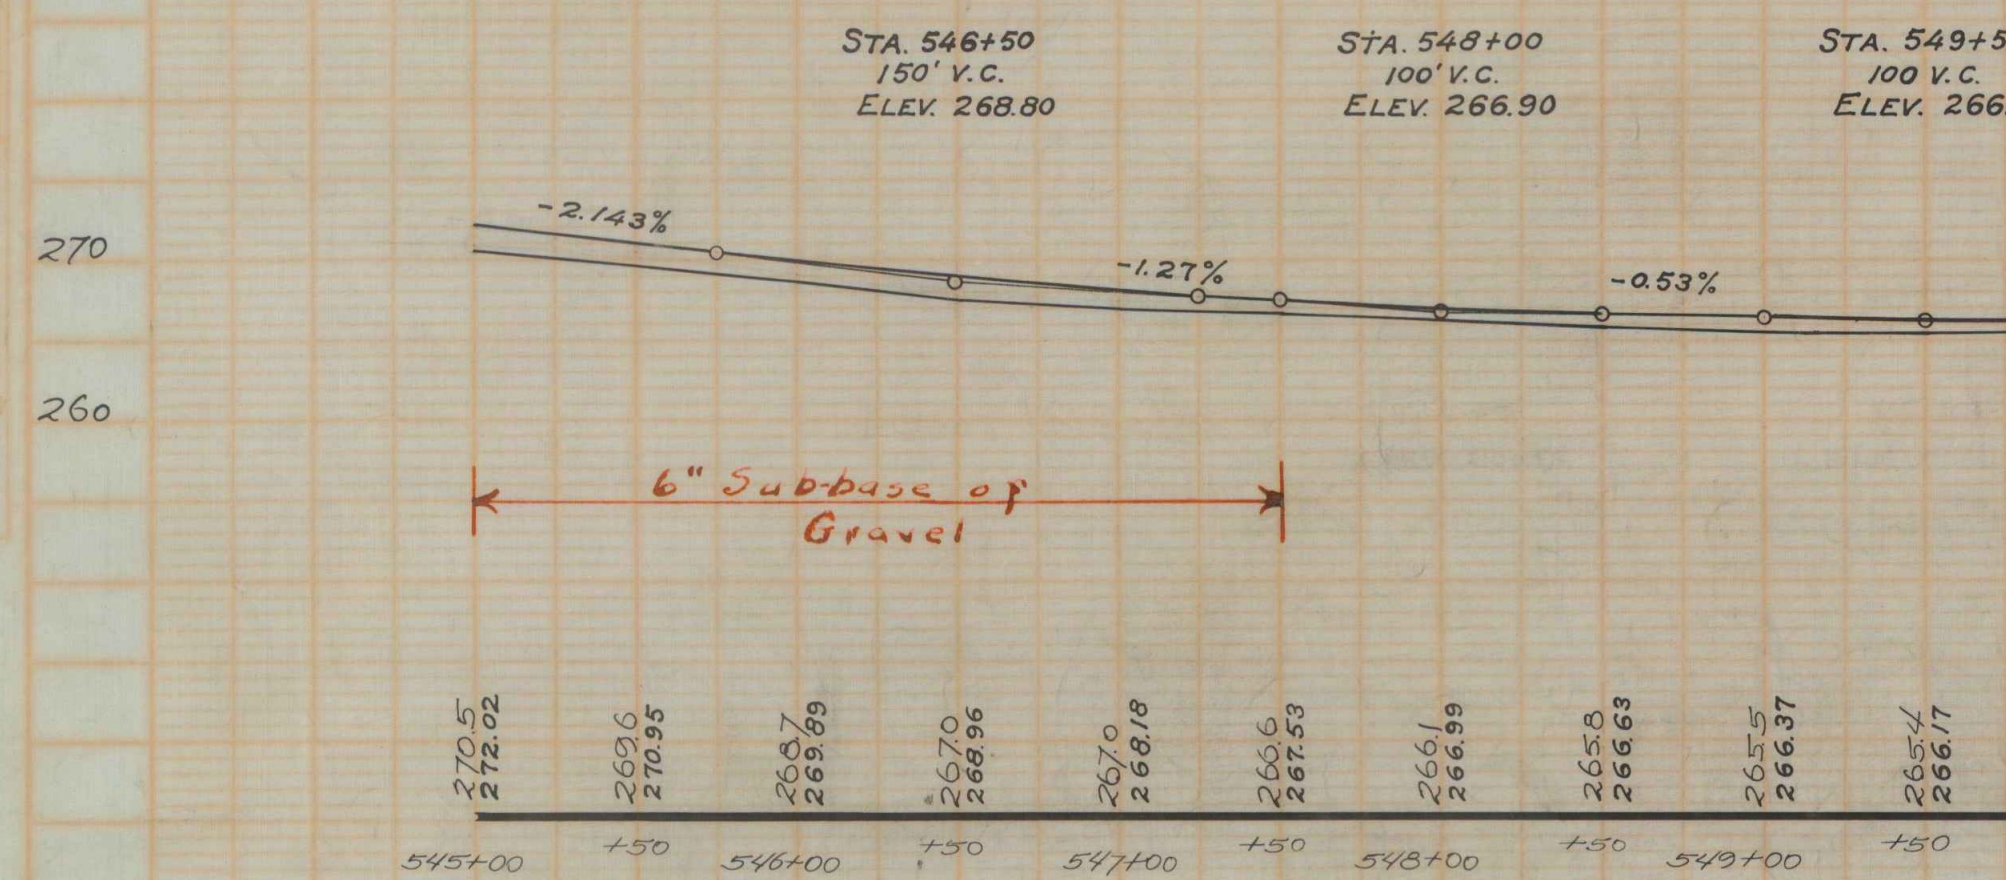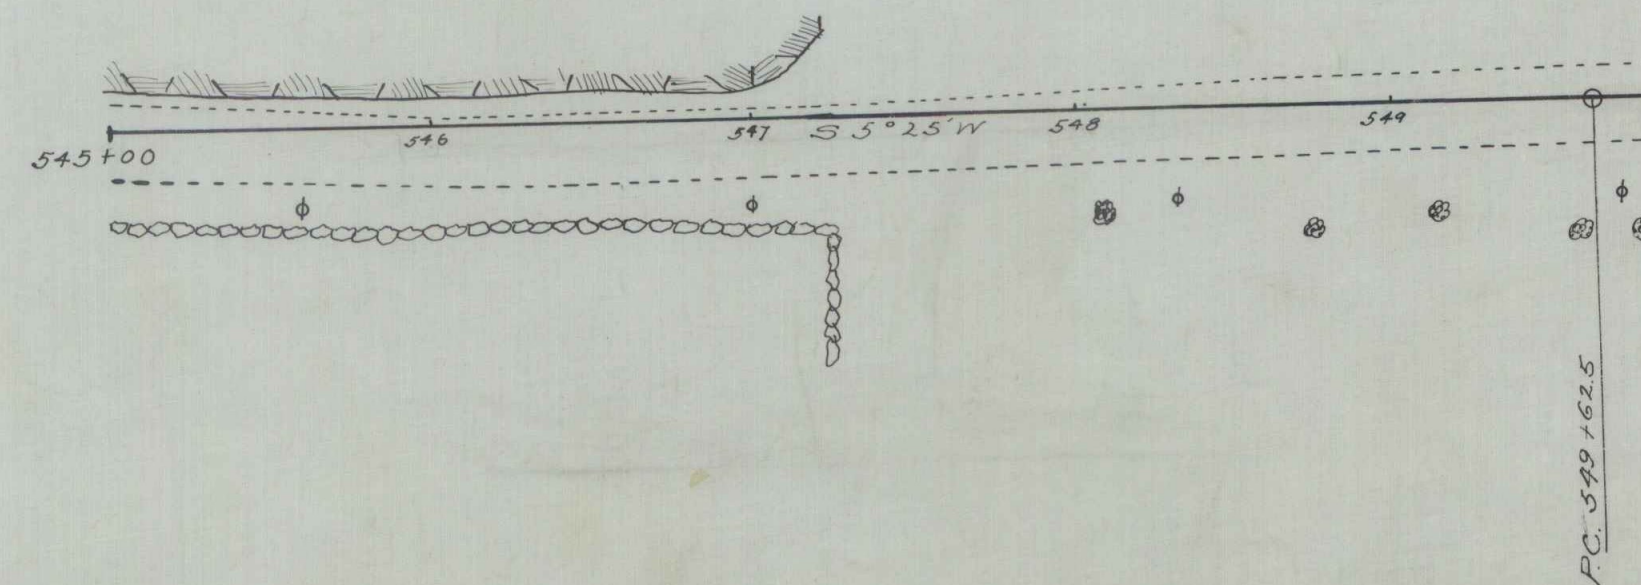

B.M. No. 73. Spike in 24" Elm. Right of Sta. 552+15 Elev. 262.00