


CABLE GUARD RAIL REQUIRED.

LEFT
Sta 606+75 to 607+25 Length 50 ft
" 618+02 " 618+50 " 48 ft

RIGHT
Sta 606+75 to 607+25 Length 50 ft
" 618+02 " 618+50 48 ft


DRIVEWAY CURVE

Sta 618+25 Length 75 ft
Concrete

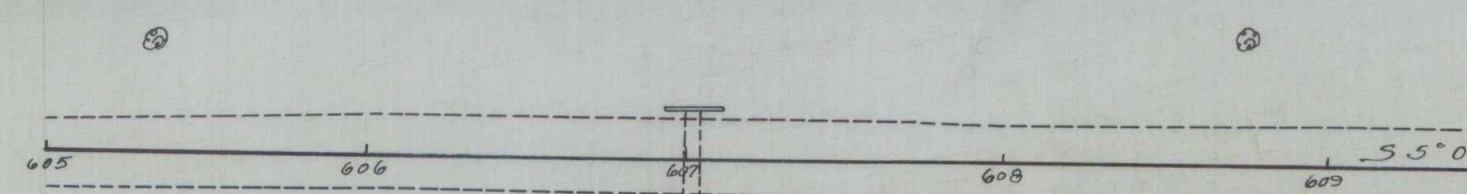

Sta 606+75
5' Concrete Curb
in good condition except
New 24' wide roadway
Roadway Width 24 ft

JOHN WILLIAMS

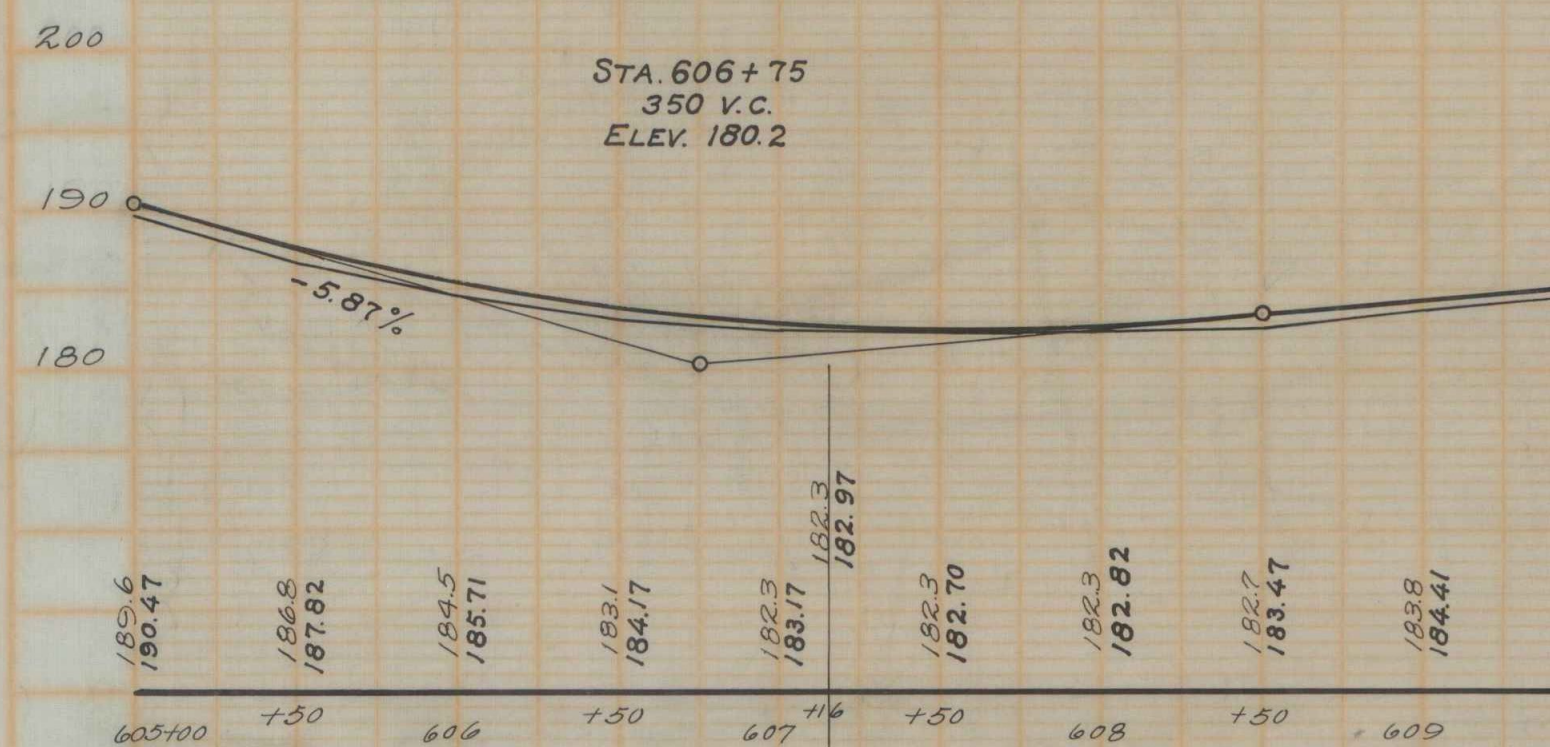

B.M. NO. 79 - SPIKE IN 20" ELM, 38' RIGHT OF STA 606+75, ELEV. 182.75
B.M. NO. 80 - SPIKE IN 24" ELM, 45' LEFT OF STA 618+07, ELEV. 193.48