


WOOD GUARD RAIL REQUIRED.

LEFT
Sta. 636+34 to 636+58 Length 24 ft. ✓

RIGHT
Sta. 636+34 to 636+58 Length 24 ft. ✓

NEW CULVERTS REQUIRED ✓

Sta. 636+40 - 30" Reinf. Concrete Pipe Culvert 32 Lvs. ft.
Concrete Class B (1-2-4) 3.9 Cu. yds.
Reinforcing Steel 54 66 pounds.

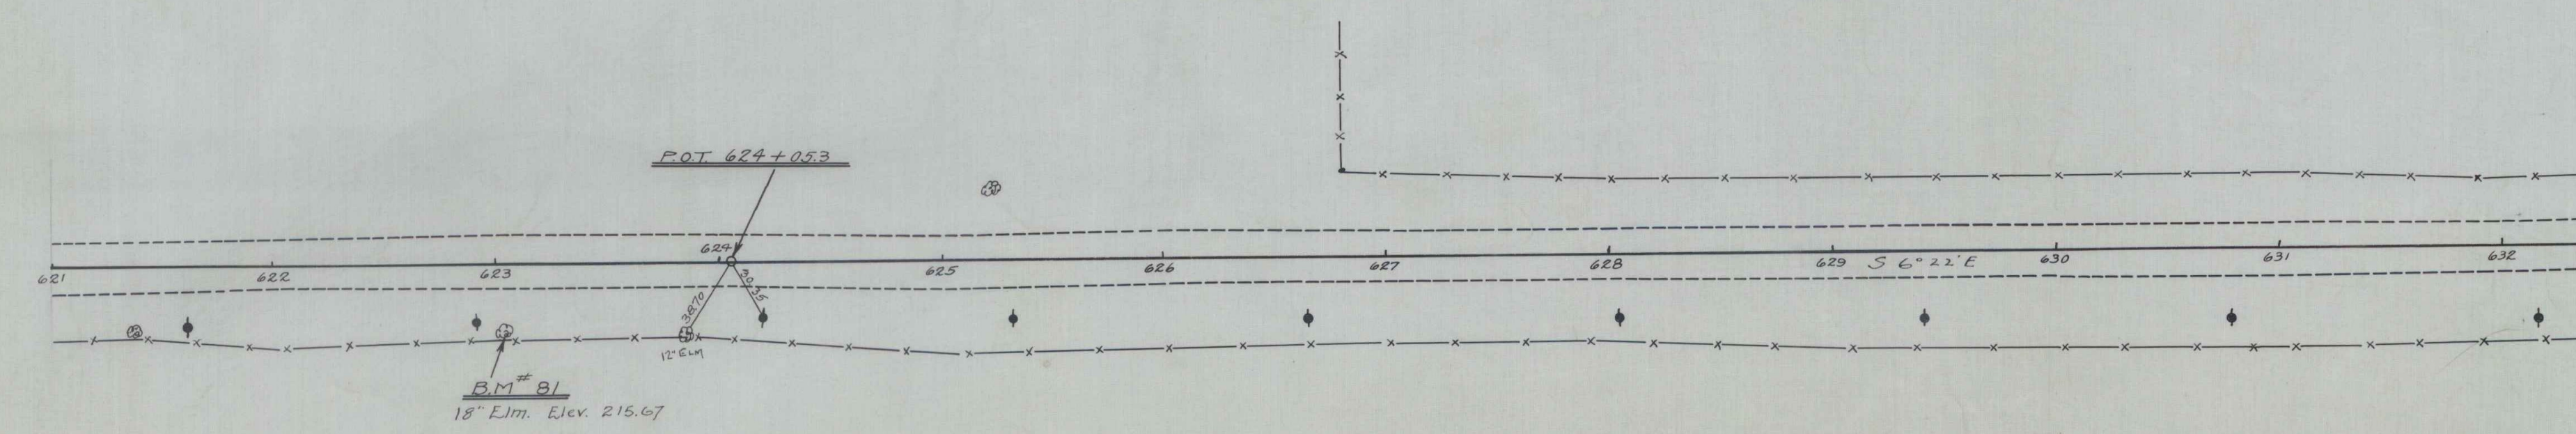

C. J. PHILLIPS

