
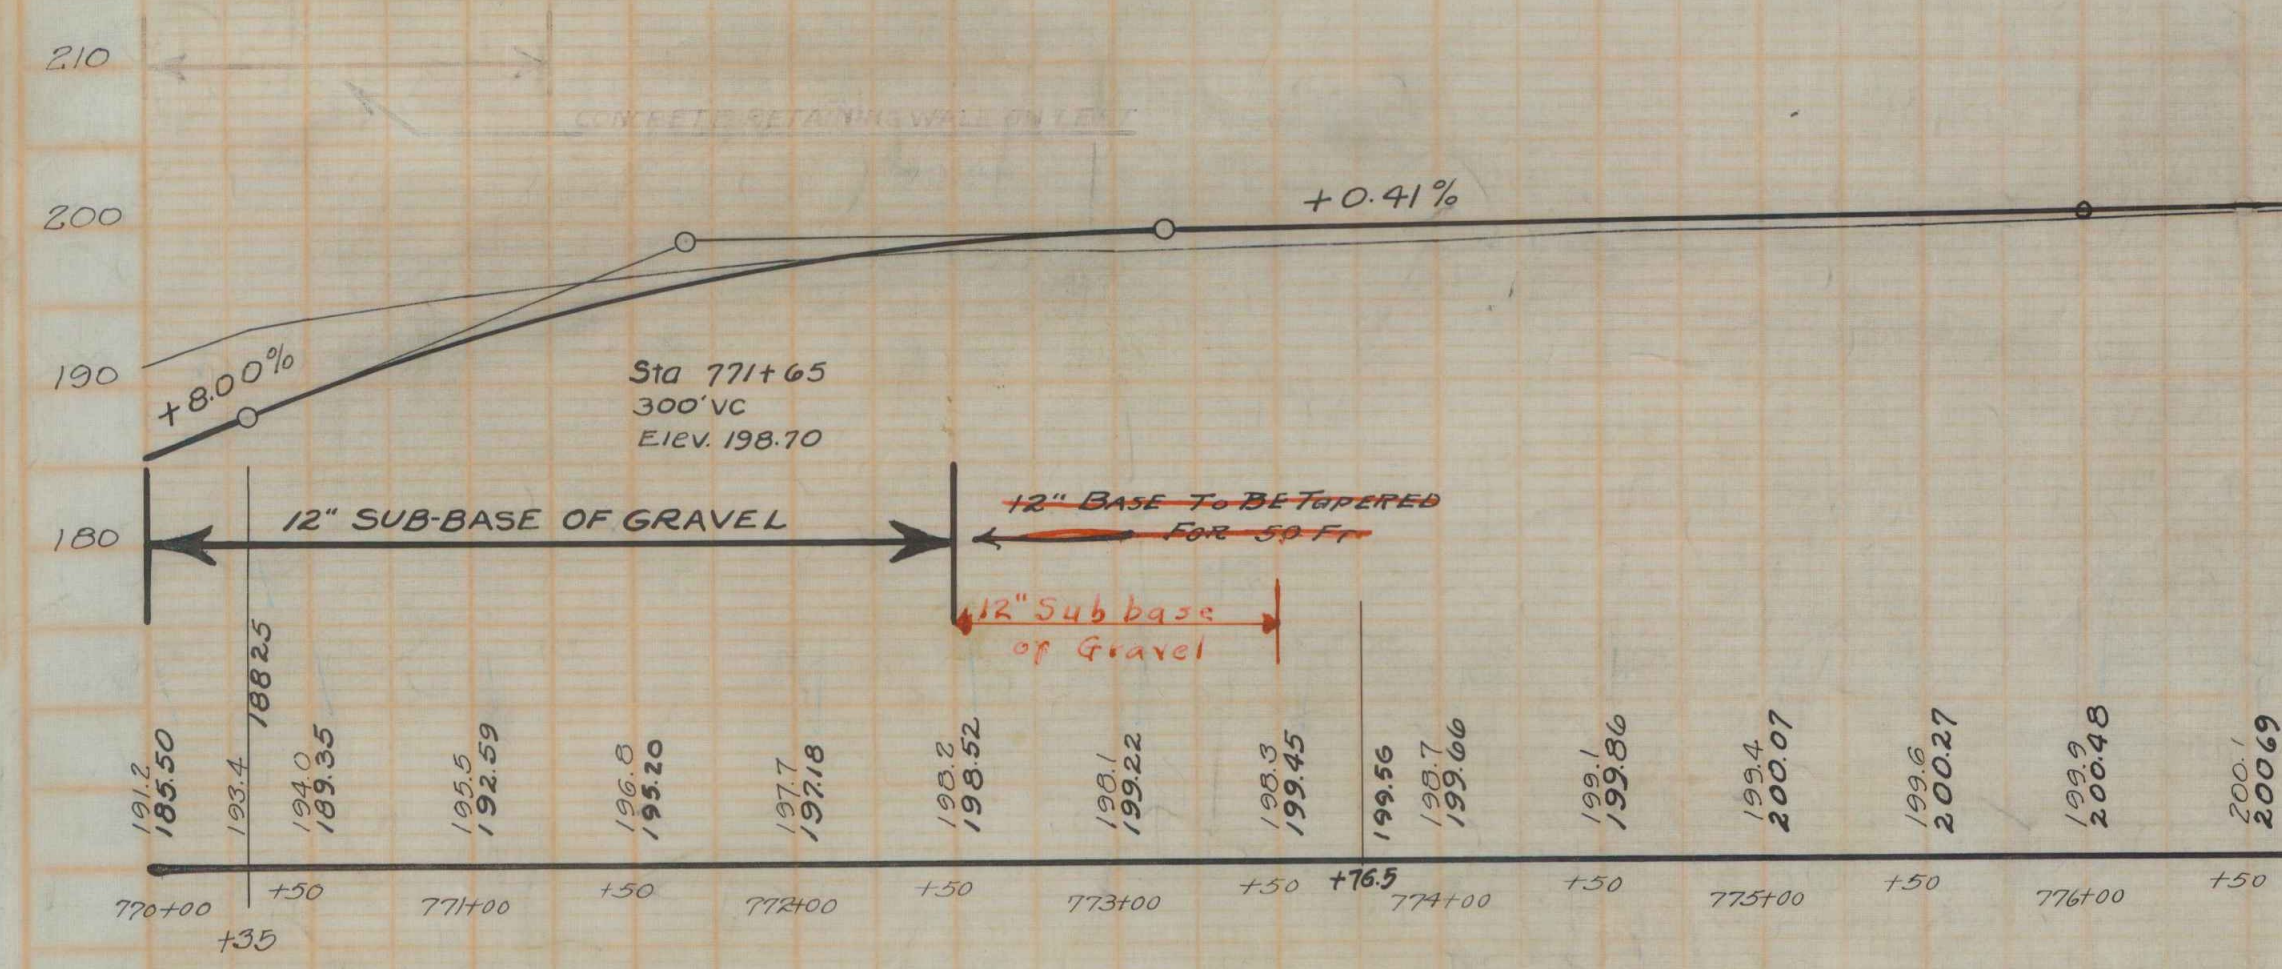


SUB-BASE OF GRAVEL REQUIRED. 350
 Sta. 770+00 772+00 - 12" Sub-base of Gravel 200 Lf. ft.
 " 773+00 785+00 " " " " " 100 " "

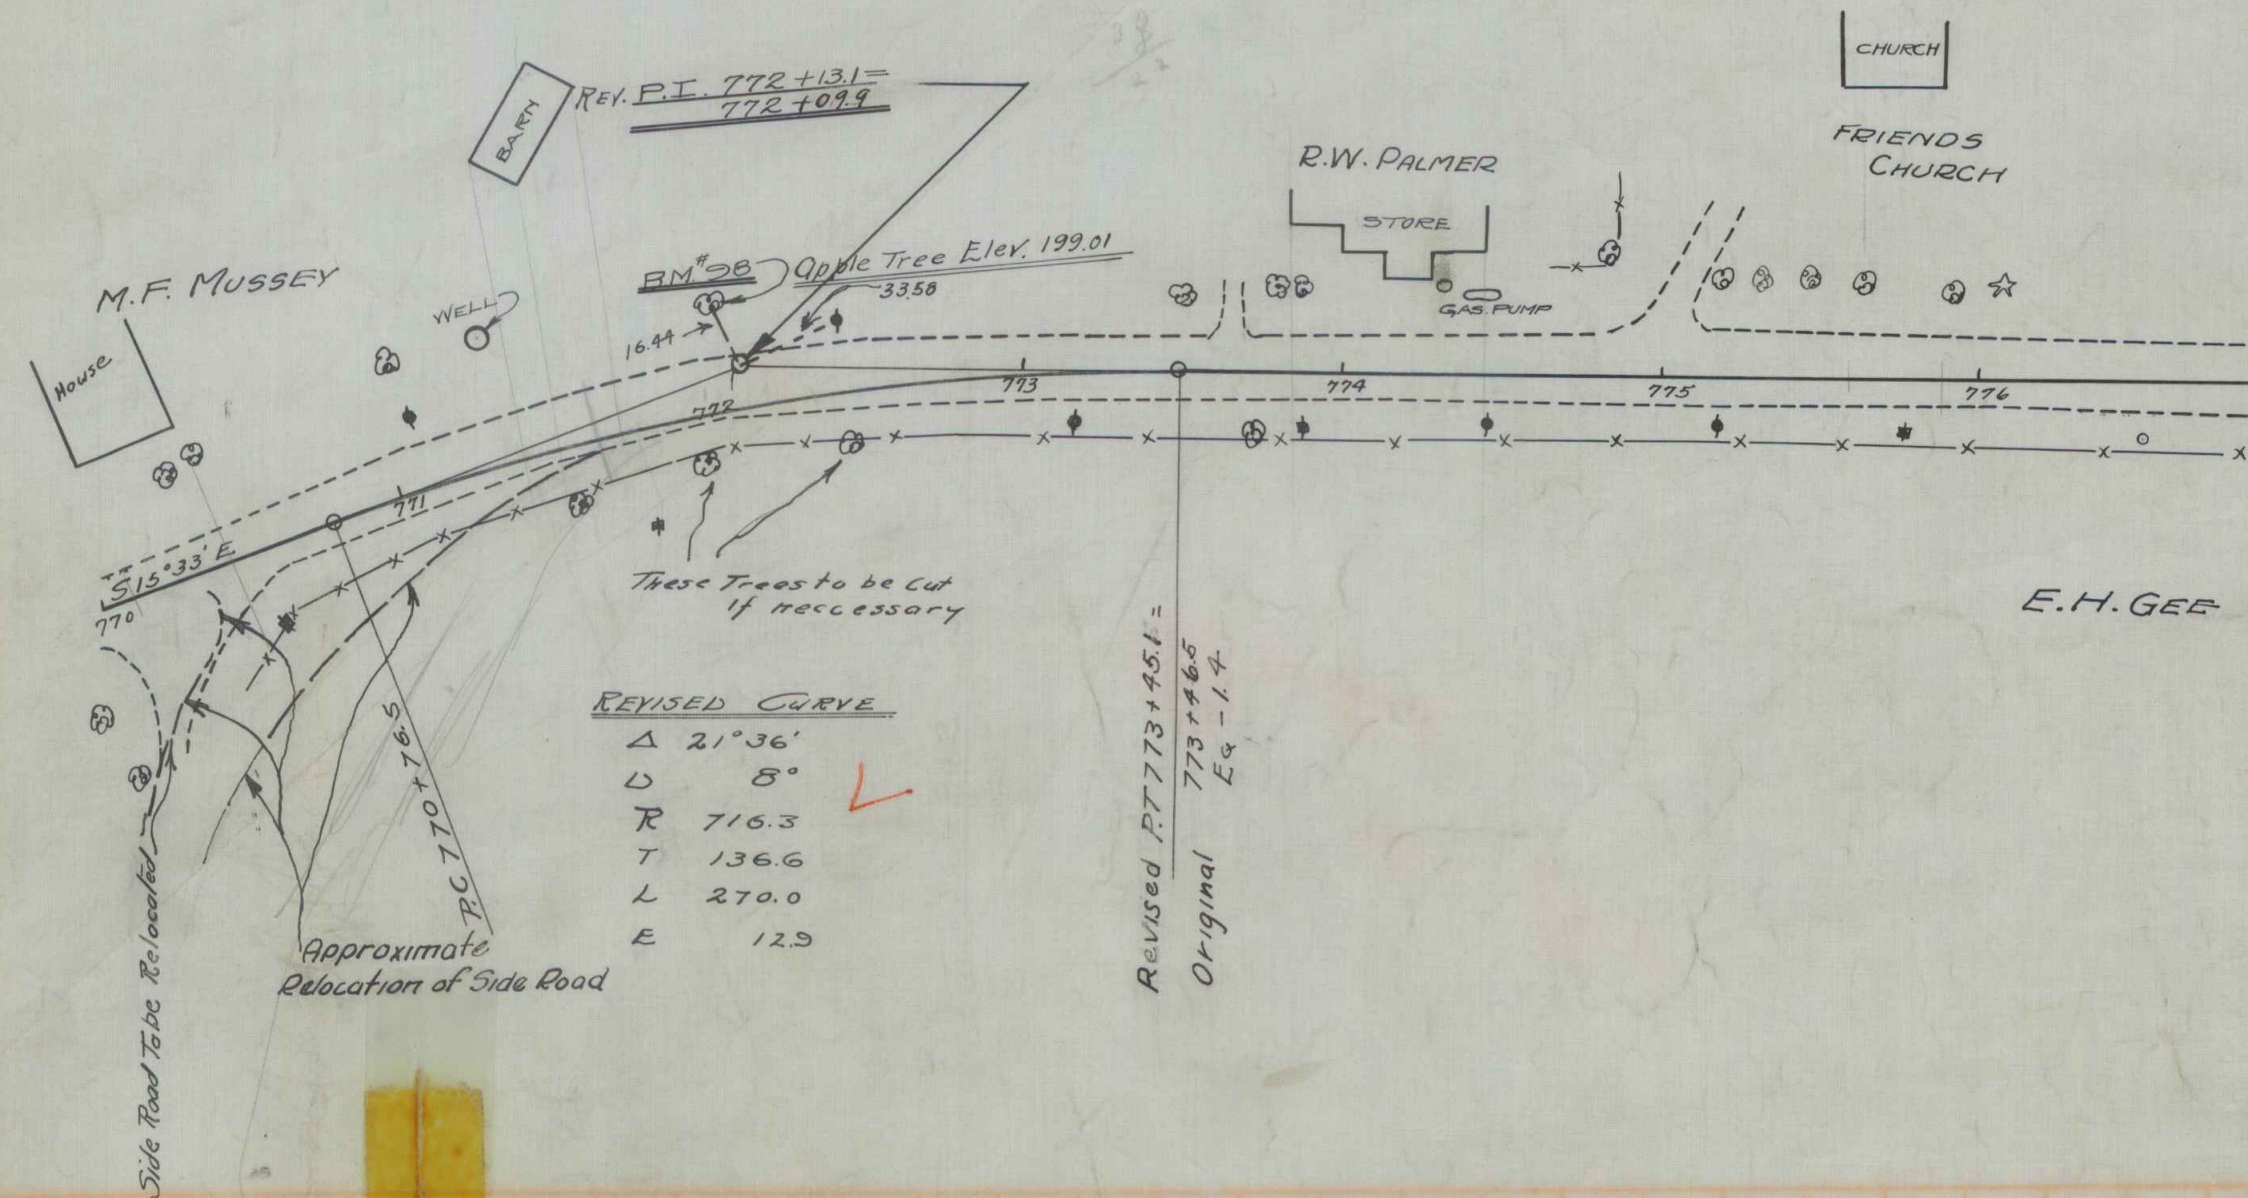

B.M. No. 98. Spike in Maple Tree Left of Sta. 772+00 Elev. 199.01
 B.M. No. 99. " " 24' Pole Left " " 773+30 Elev. 205.10