

WOOD GUARD RAIL REQUIRED

LEFT
Sta 871+49 to 871+73 Length 24 ft.

RIGHT
Sta 871+49 to 871+73 Length 24 ft.

NEW CULVERTS REQUIRED

Sta 871+61 - 18" Reinf. Concrete Pipe Culvert 32 ft.
Concrete Class B (1-2 1/2-3) 27 Cu. Yds.
Reinforcing Steel 33 pounds



Record Plan Addition =

Stop at Sta 866+00

August 9, 1954

F. W. Ayler

Sta 871+61
Old 18" C.P. P.
Reinforced with 18"
See S

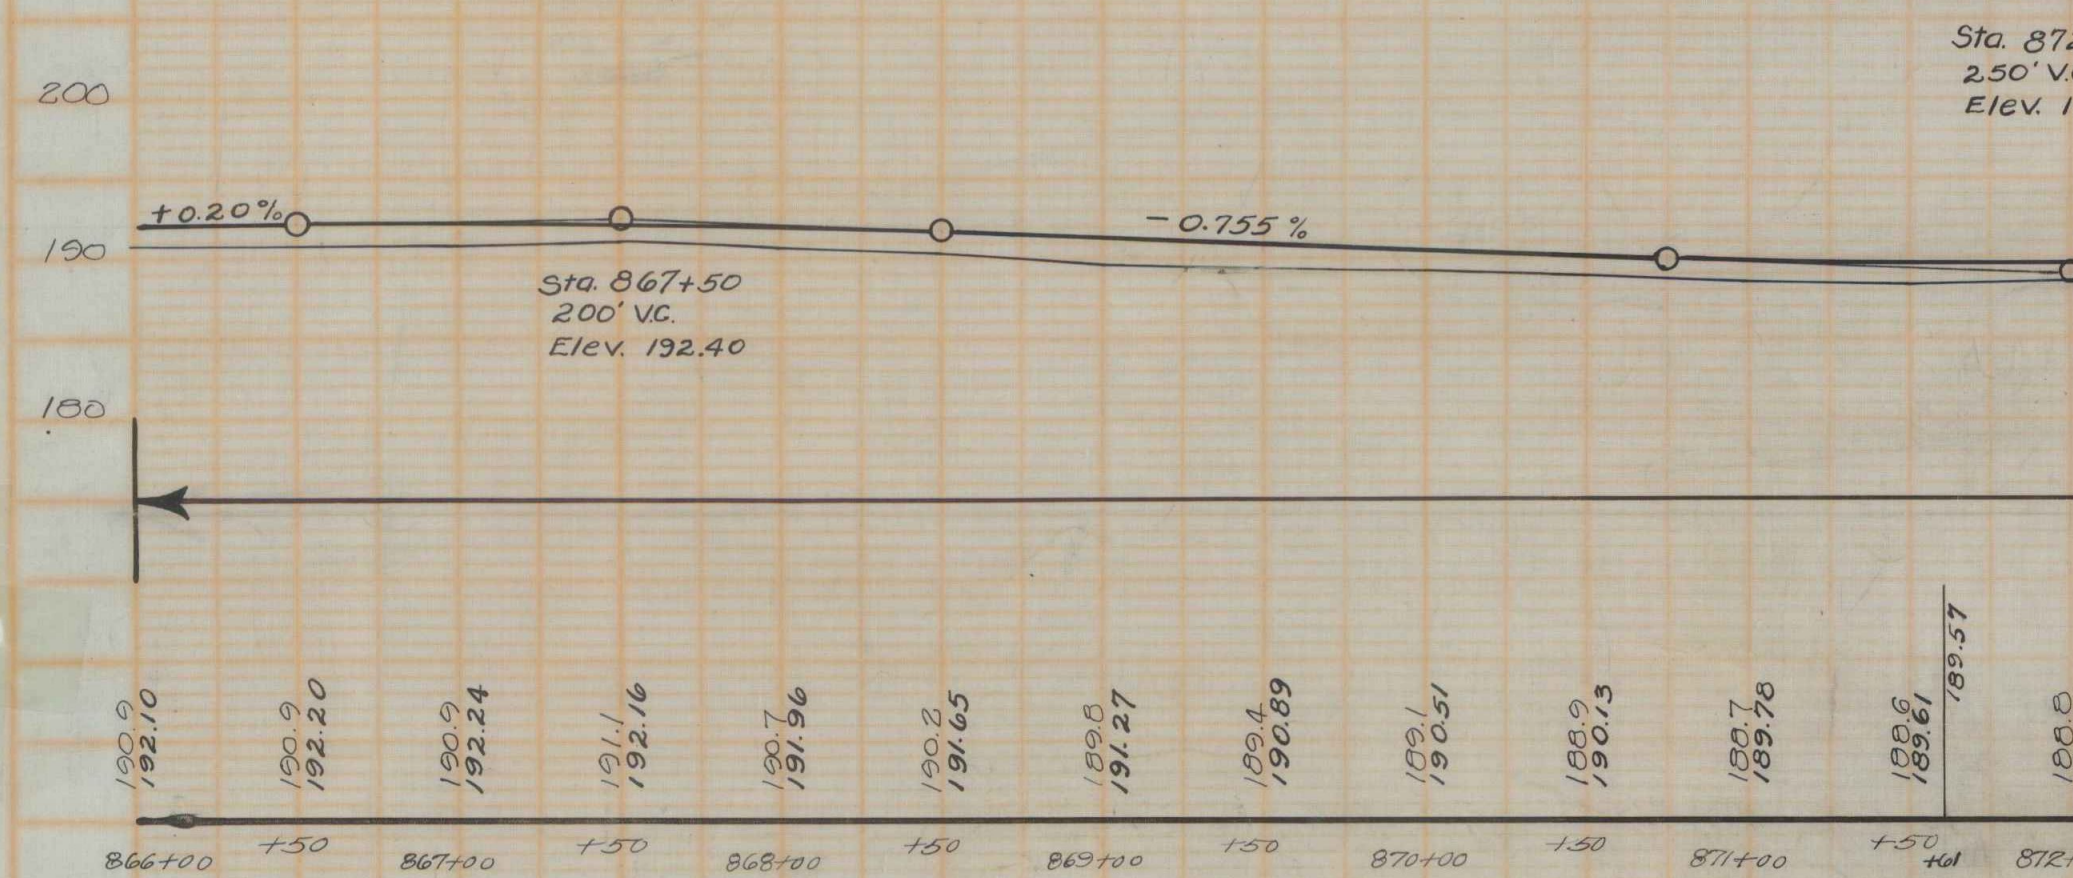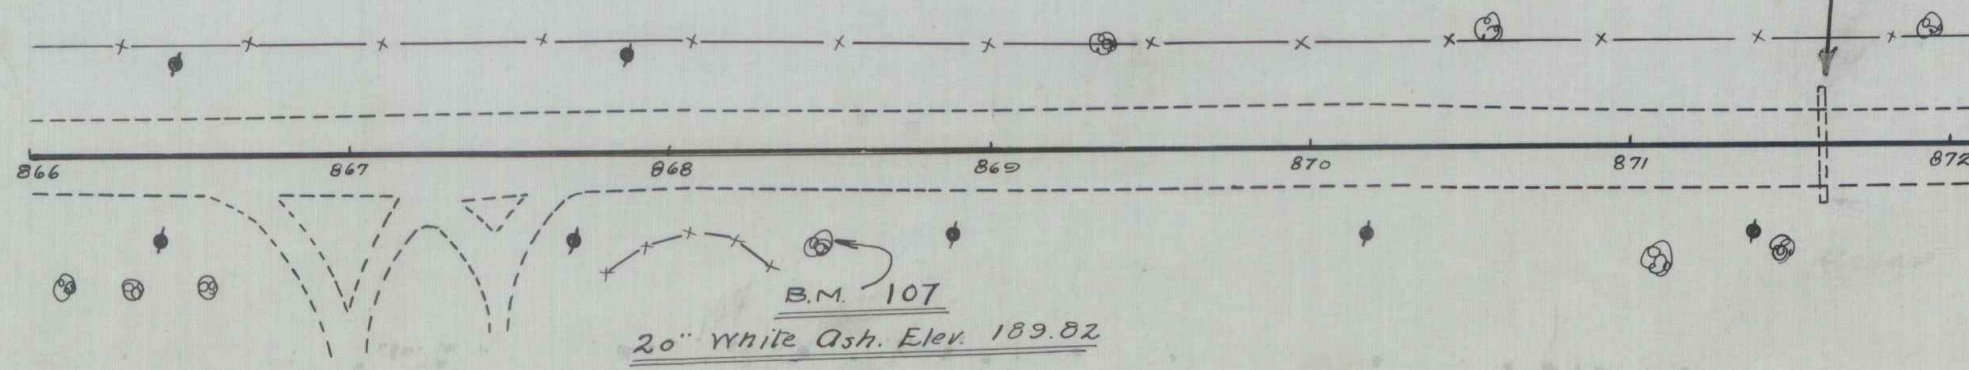

B.M. No. 107 Spike in 20' White Oak Right of Sta. 868+46 Elev. 189.82

Sta. 872
250' V.C.
Elev. 192.40