
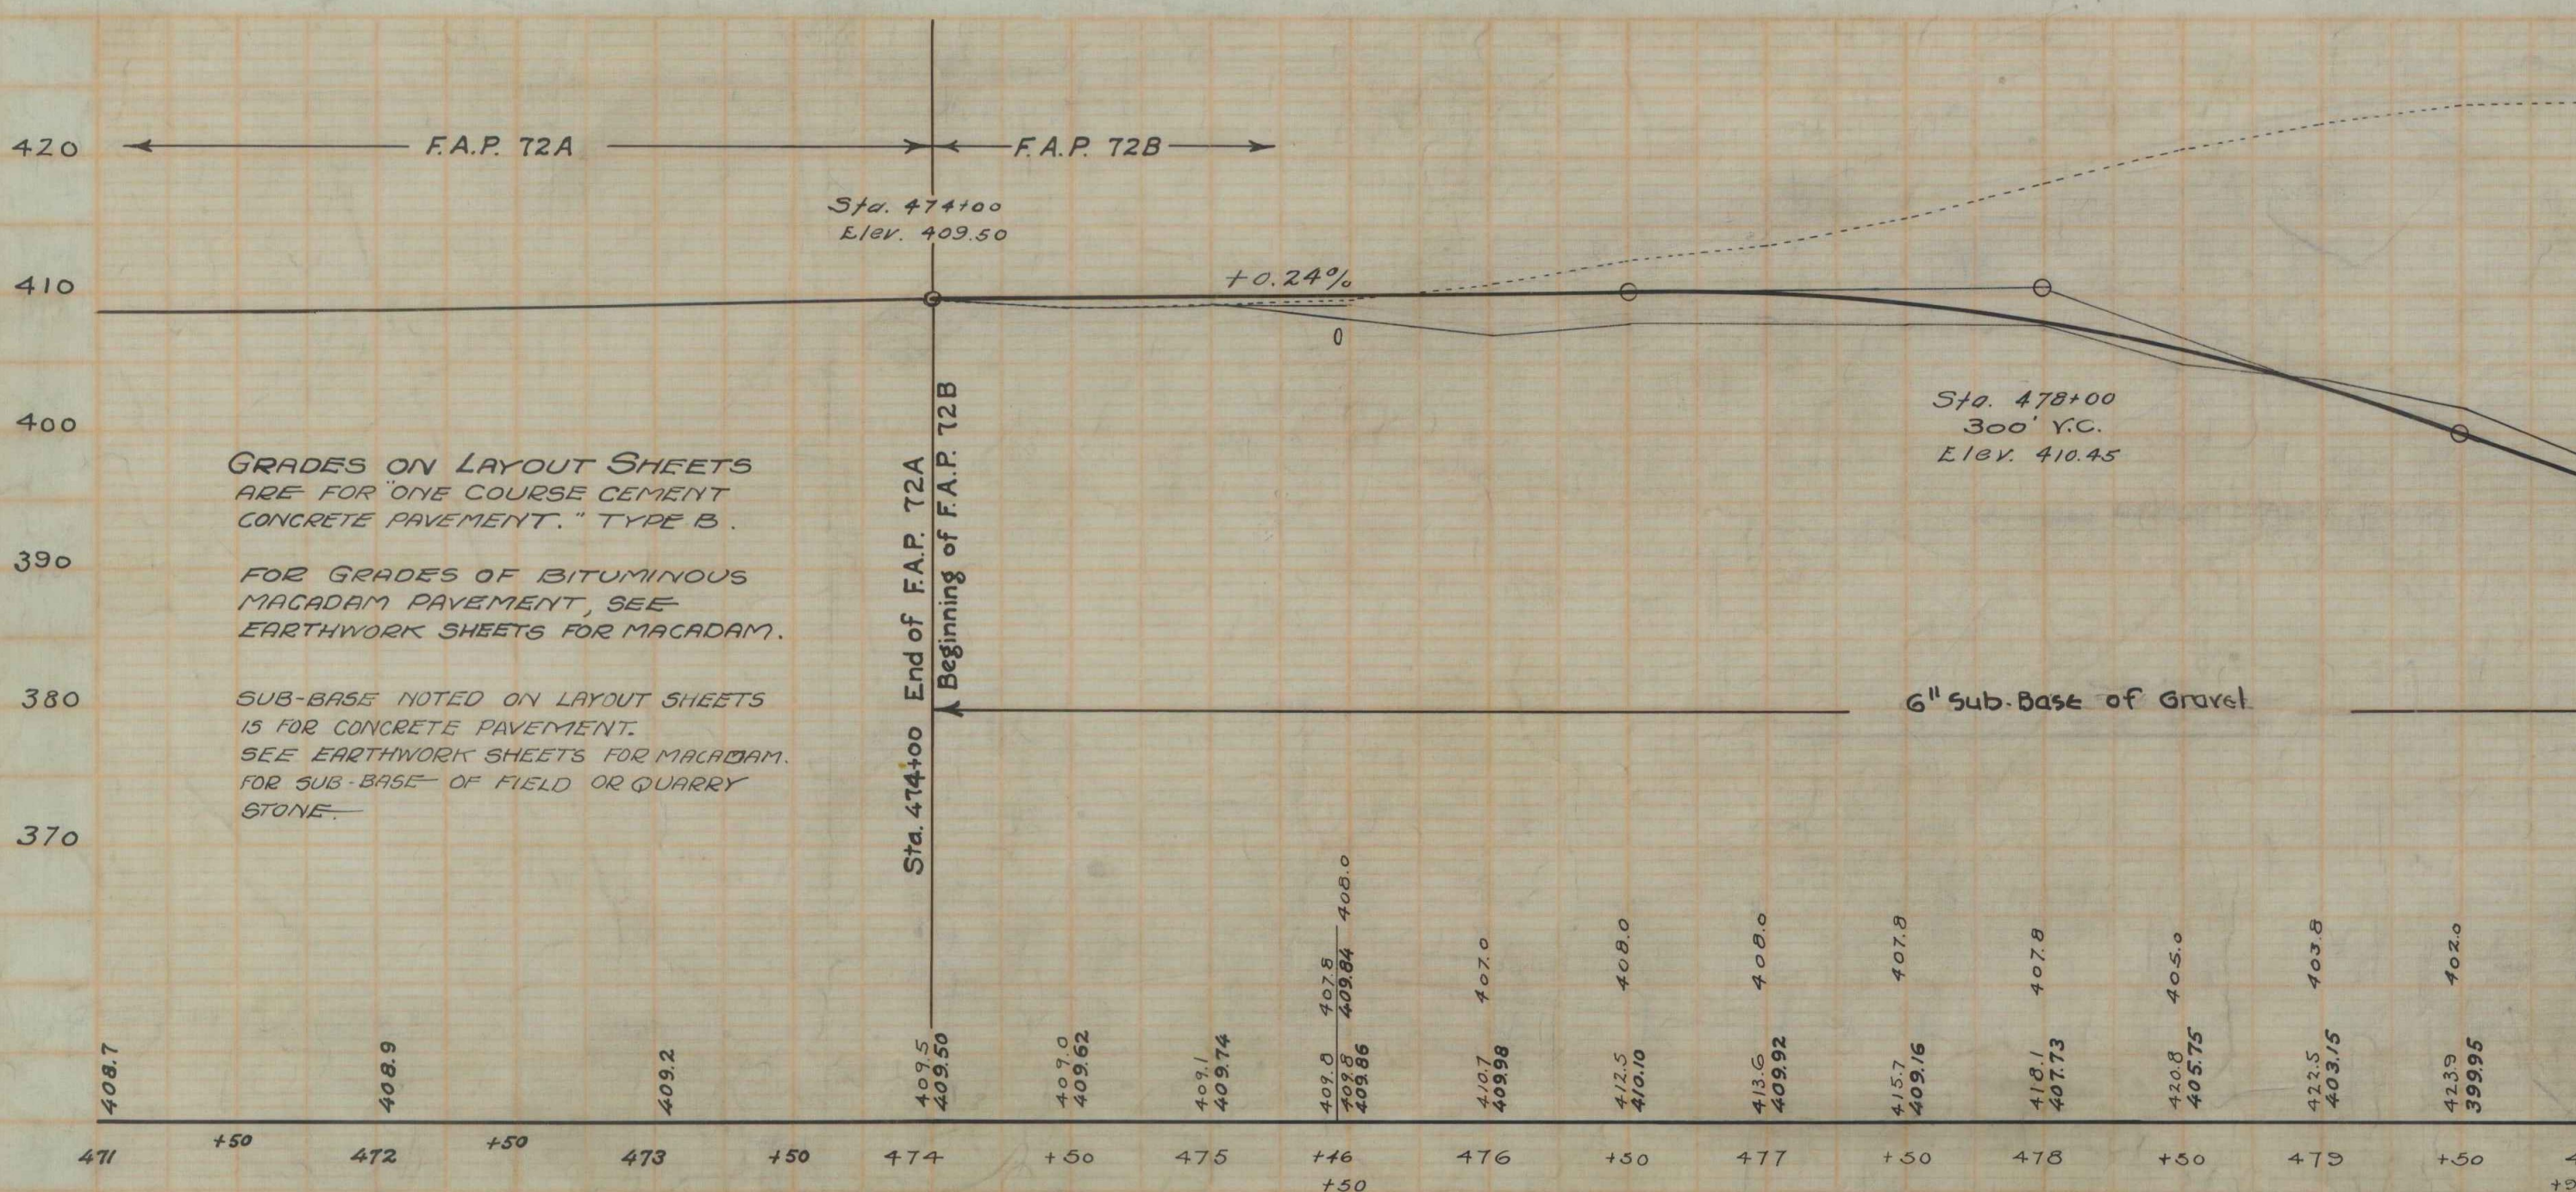


CABLE GUARD RAIL REQUIRED
LEFT
Sta. 474+34 to 475+58 Length 224 ft.
" 481+16 " 483+40 " 224 ft.
" 484+50 " 485+00 " 50 ft.

WOOD GUARD RAIL REQUIRED
RIGHT
Sta. 475+34 to Sta. 475+58 Length 24 ft.
" 482+88 " 483+12 " 24 ft.
Left
" 475+34 " 475+58 " 24 ft.

NEW CULVERTS REQUIRED.
Sta. 475+46 - 30" Reinf. Concrete Pipe Culvert 40 Lin. ft.
Concrete Class A (1-2-4) 35 cu. yds.
Reinforcing Steel 66 pounds.
" 483+00 - 18" Reinf. Concrete Pipe Culvert 32 Lin. ft.
Concrete Class A (1-2-4) 1.07 cu. yds.
" " B (1-2 1/2-5) 0.82 " "
Reinforcing Steel 45 lbs

SUB-BASE OF GRAVEL REQUIRED
Sta. 477+00 to 485+00. 6" Sub-base of Gravel. 11

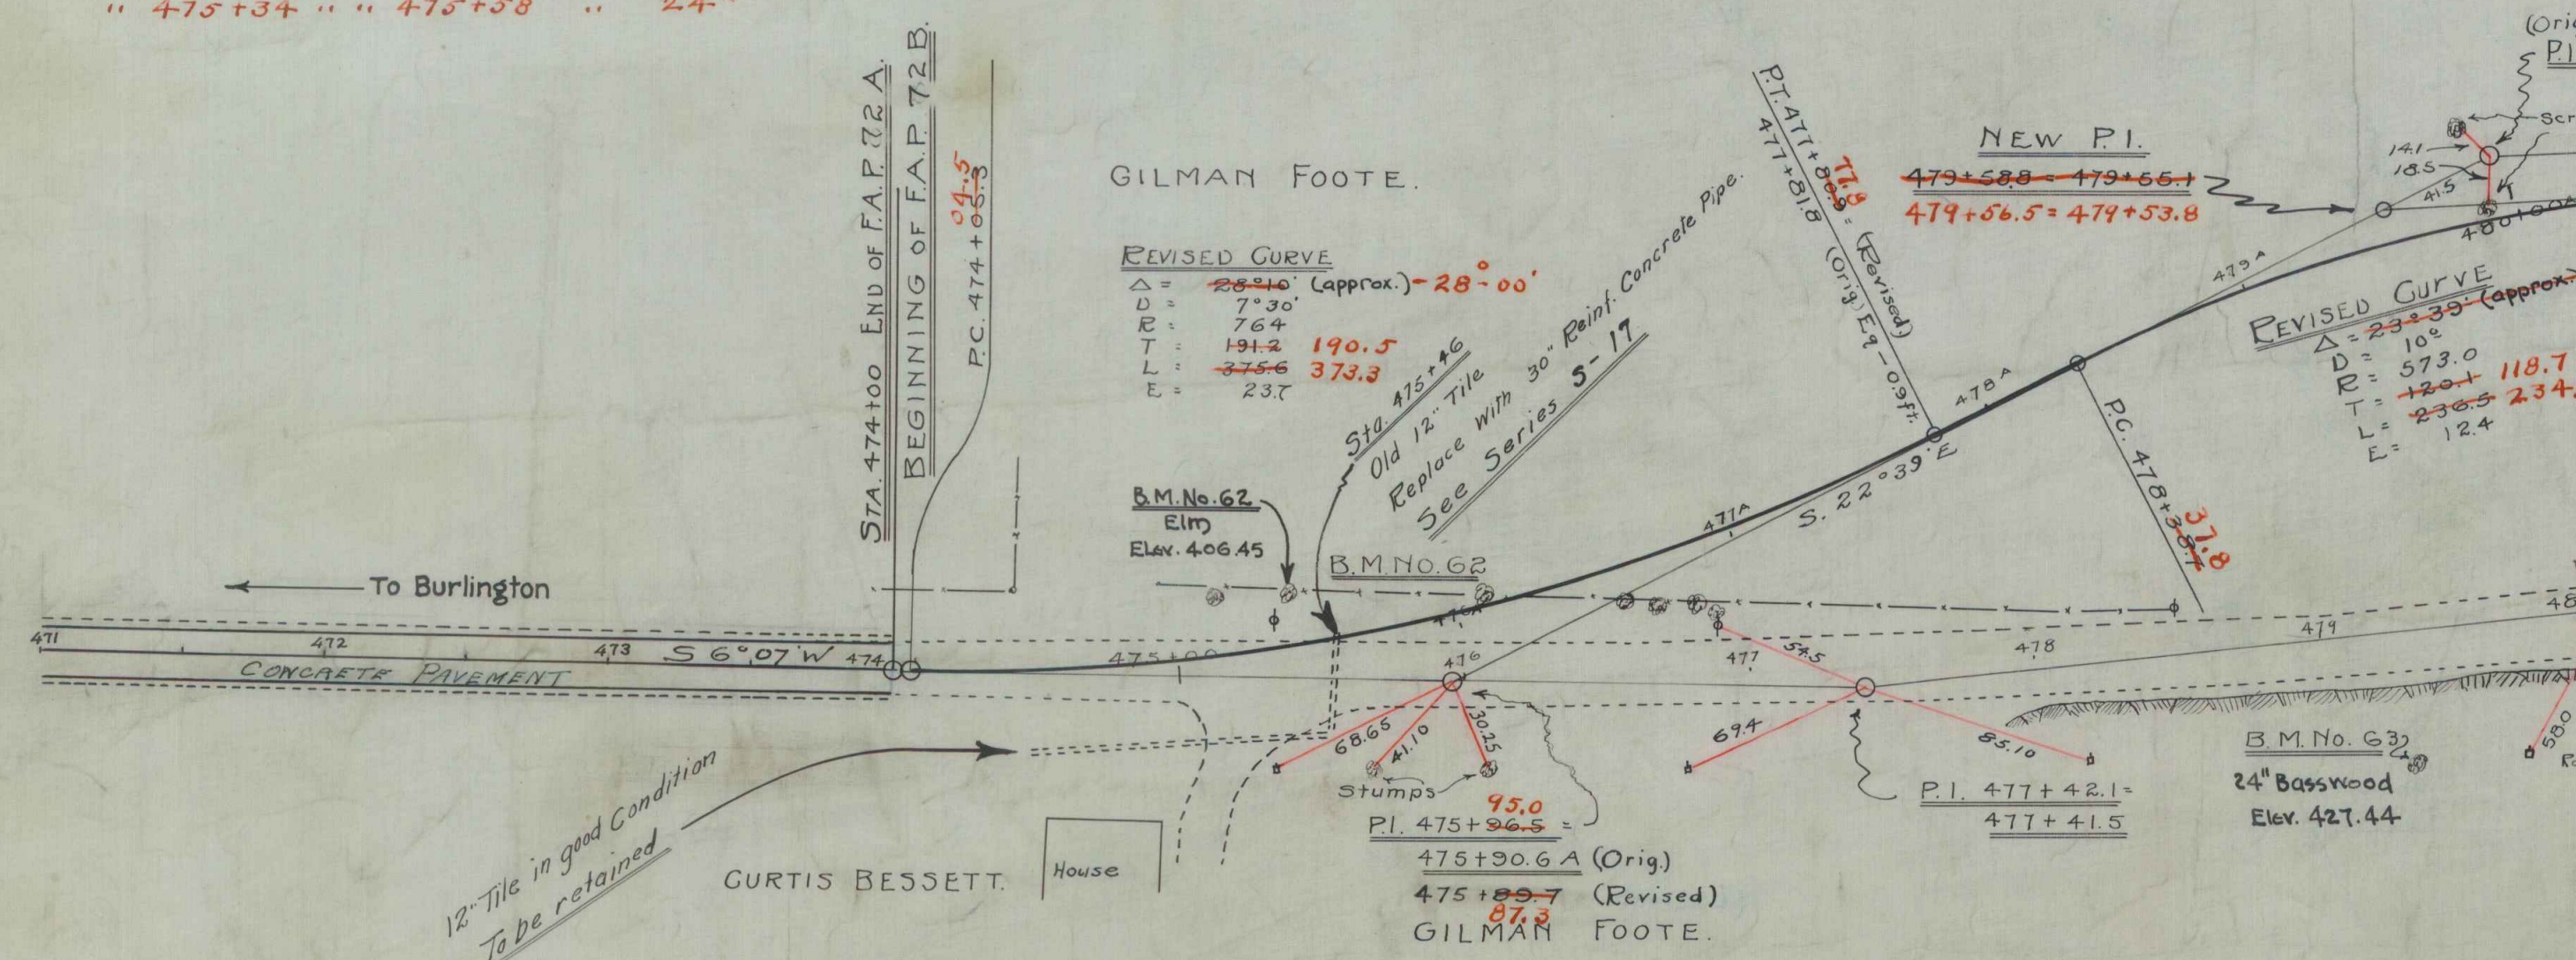

B.M. No. 62 Spike in Elm Left of Sta. 475+11 Elev. 406.45
B.M. No. 63 Spike in 24" Basswood Right of Sta. 479+32 Elev. 427.44
B.M. No. 64 Point Point on Ledge Right of Sta. 483+62 Elev. 412.45