
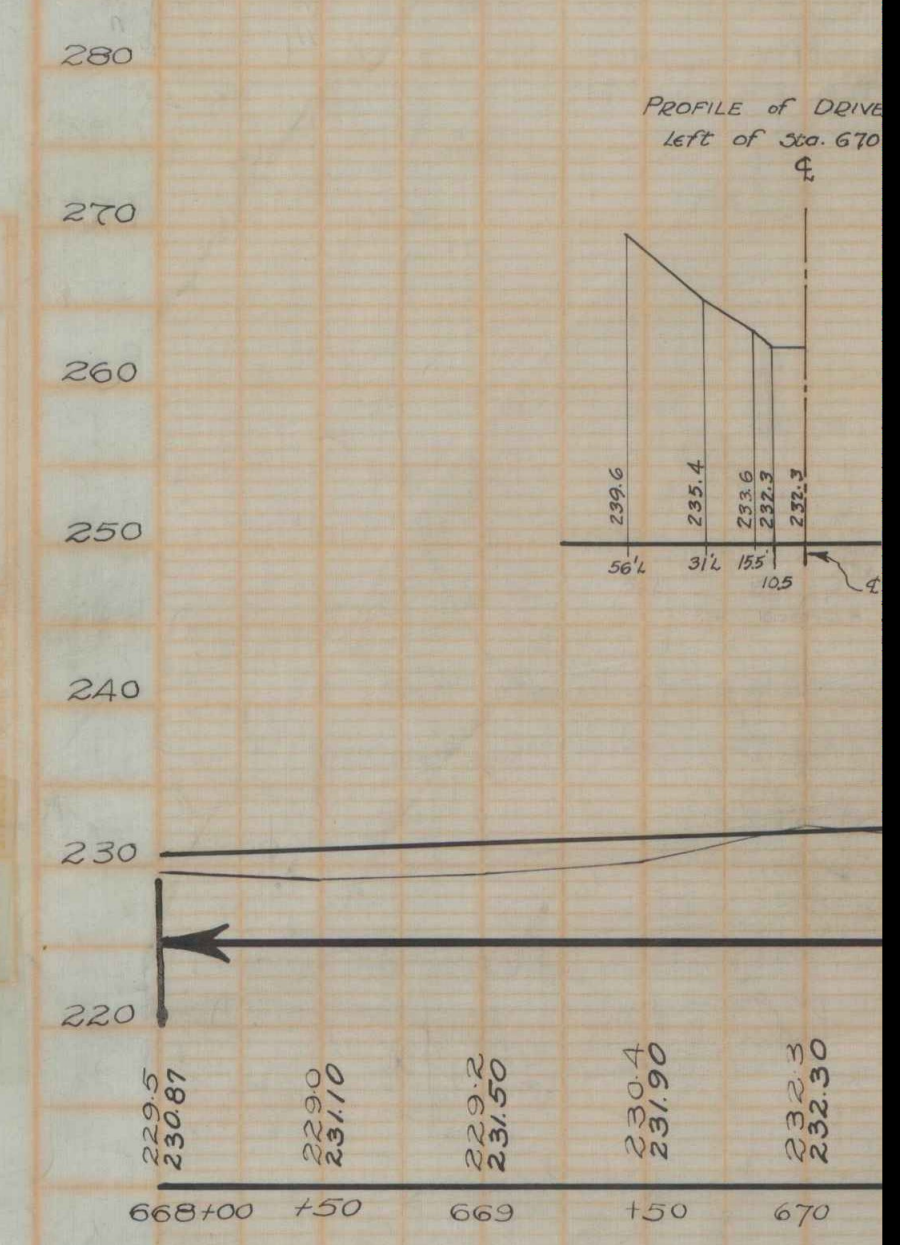


WOOD GUARD RAIL REQUIRED
LEFT and Right
Sta 671+35 to 671+62 Length
CABLE GUARD RAIL REQUIRED
Sta 668+00 to 673+20 Length
670+75 to 673+20

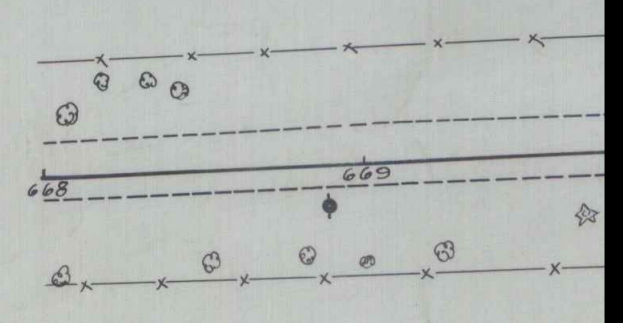

B.M. NO. 86 - SPIKE IN 24" ELM, 28' LEFT