


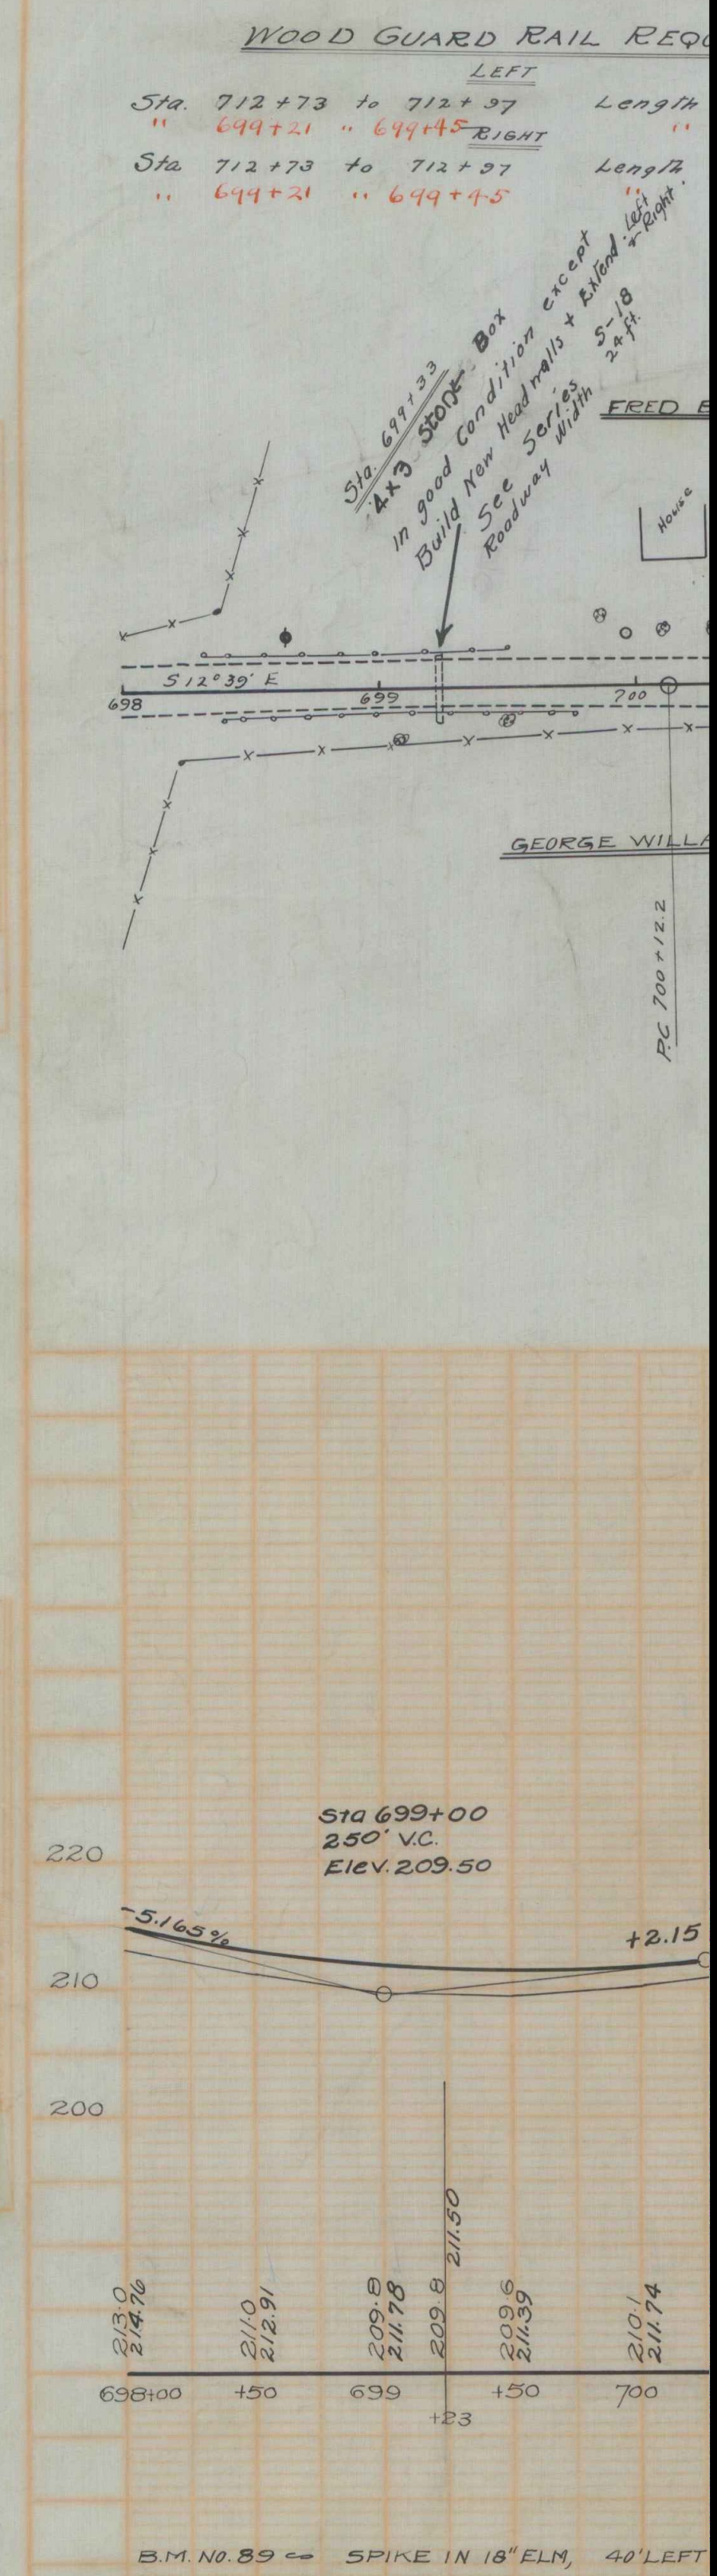

B.M. NO. 89 $\leftrightarrow$ SPIKE IN 18" ELM, 40' LEFT