
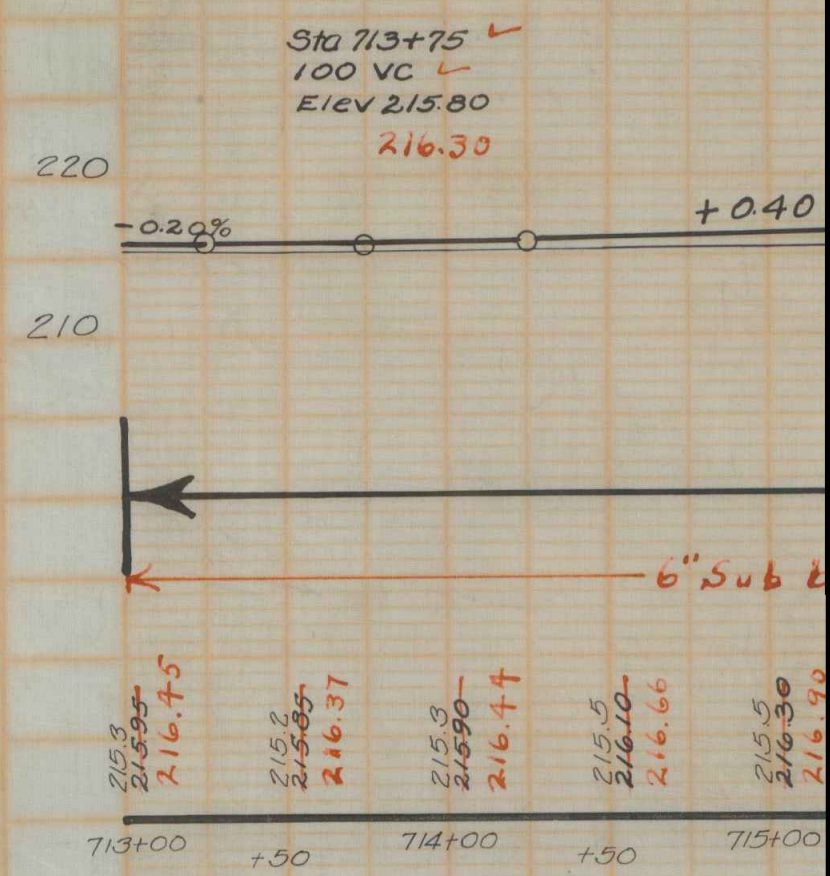


WOOD GUARD RAIL REQUIRE

LEFT			
Sta. 710+00 to	720+12	Length	24
" 722+18 "	722+42	"	24
RIGHT			
Sta. 719+00 to	720+12	Length	24
" 722+18 "	722+42	"	24

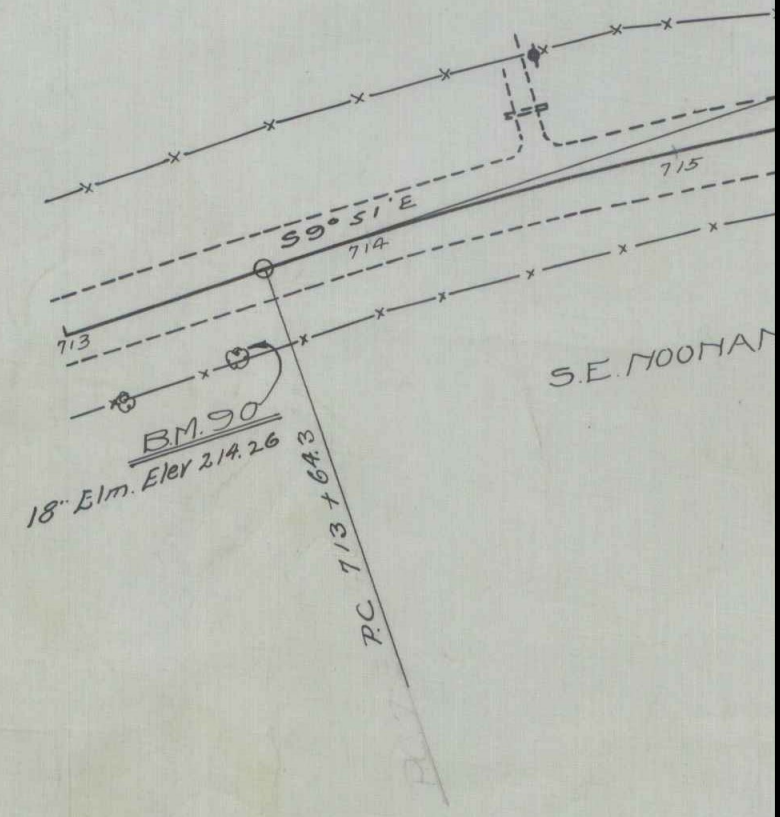

B.M. No. 90 Spike in 18\"
B.M. No. 91 Spike in 24\"