



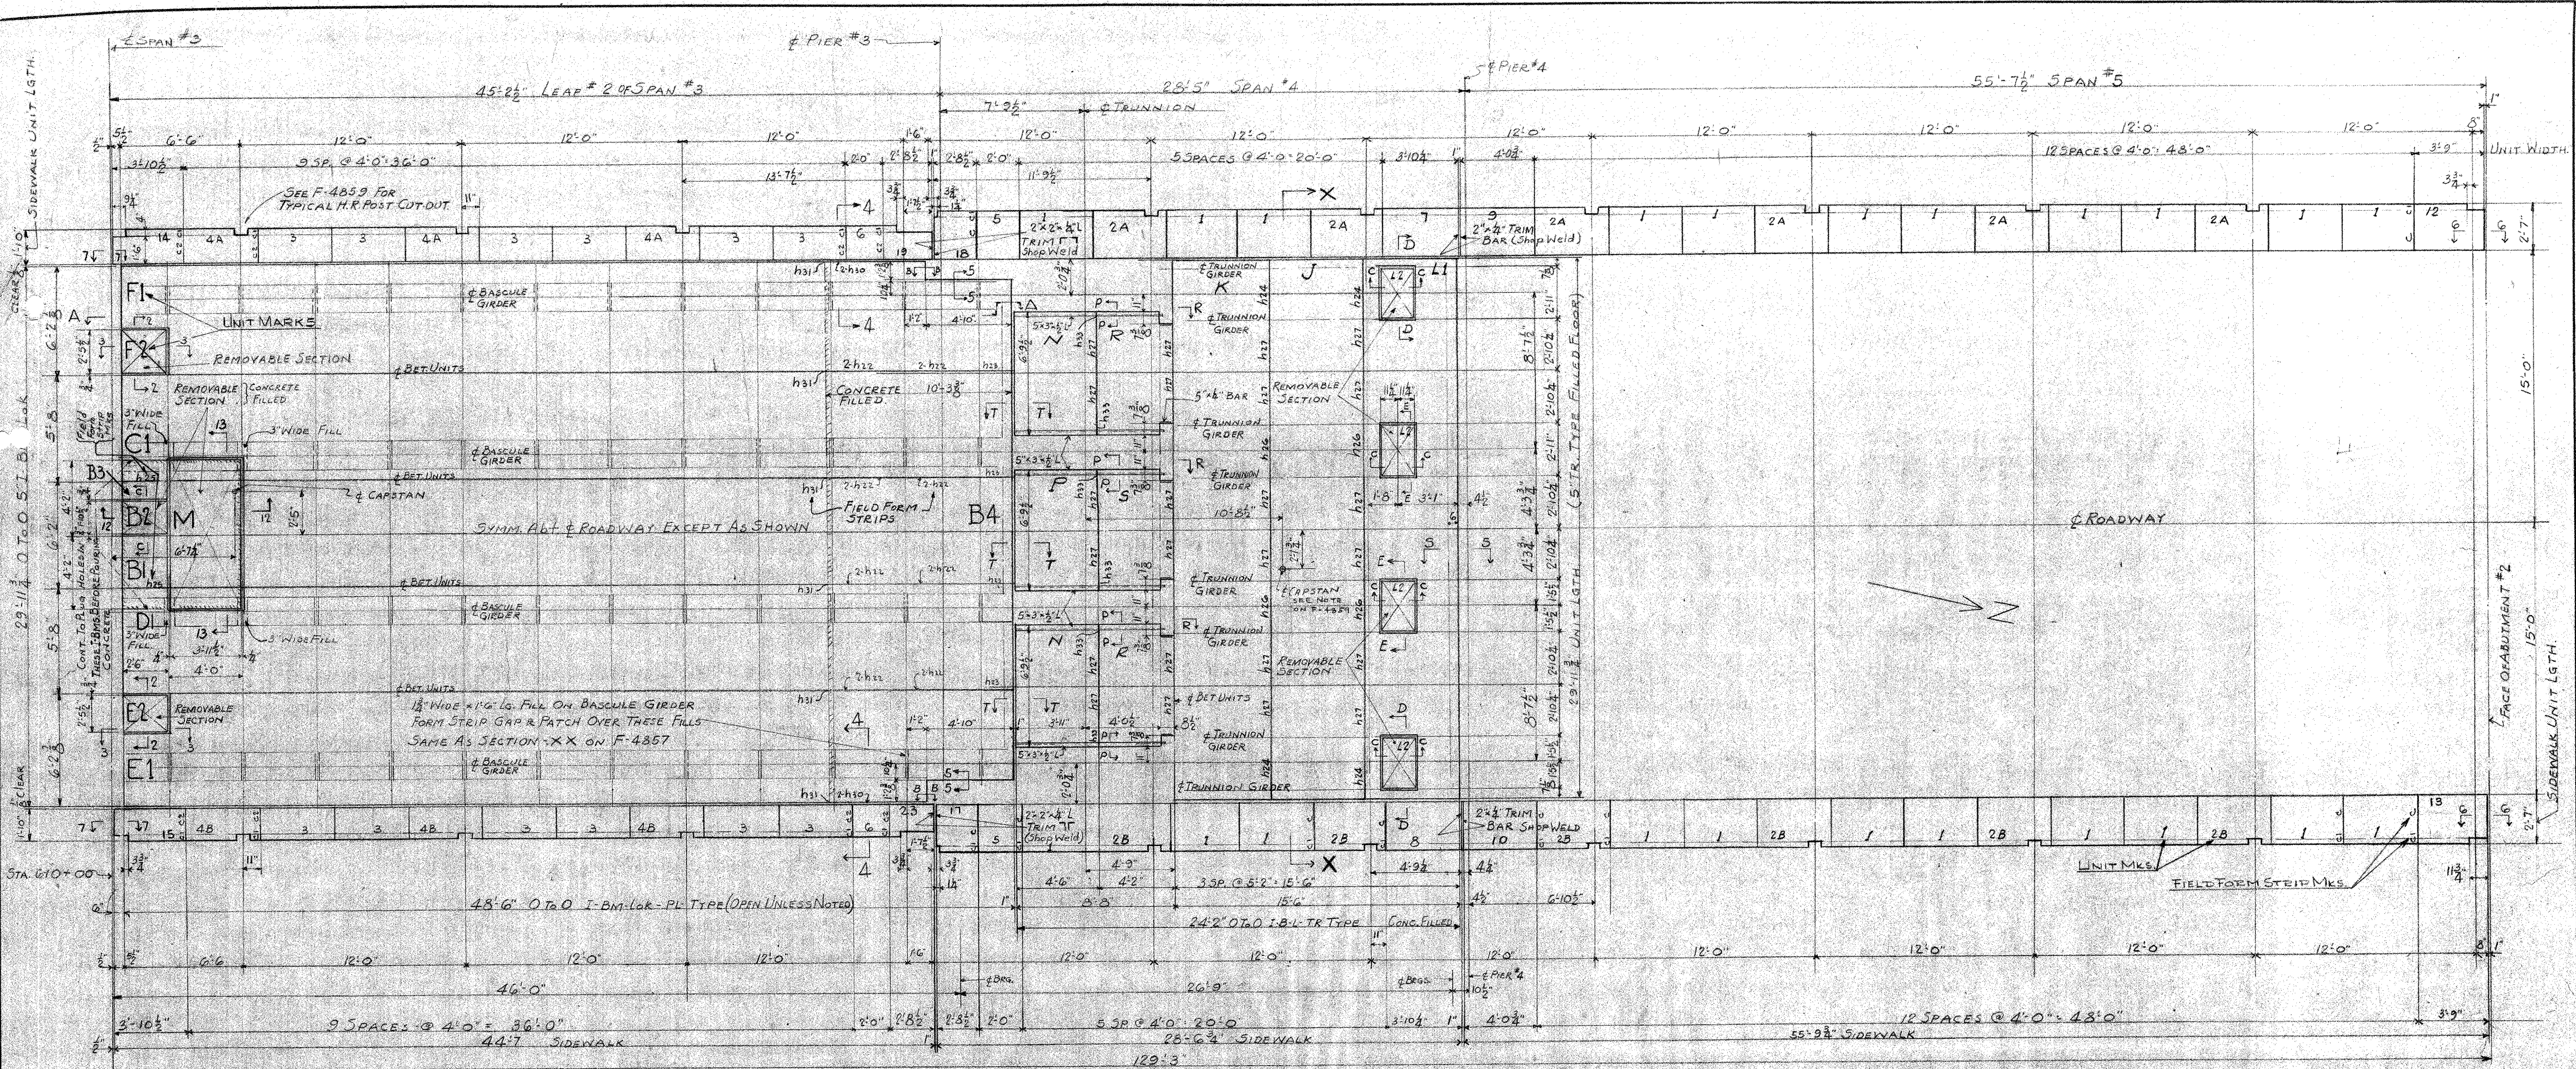

PLAN - NORTH SPAN

ERECTION NOTE:

PLACE UNITS, WITH MARKED END OF UNITS, LOCATED AS SHOWN ON PLAN.
 DURING ERECTION OF UNITS, CARE MUST BE EXERCISED TO PLACE EACH UNIT IN ITS PROPER LOCATION, MEASURING IN ALL CASES FROM SOME FIXED POINT, AS OTHERWISE A CUMULATIVE ERROR IN SPACING WILL APPEAR, CAUSING THE SPACE FOR THE FINAL UNITS TO BE MORE OR LESS THAN THE ACTUAL WIDTH OF UNITS.

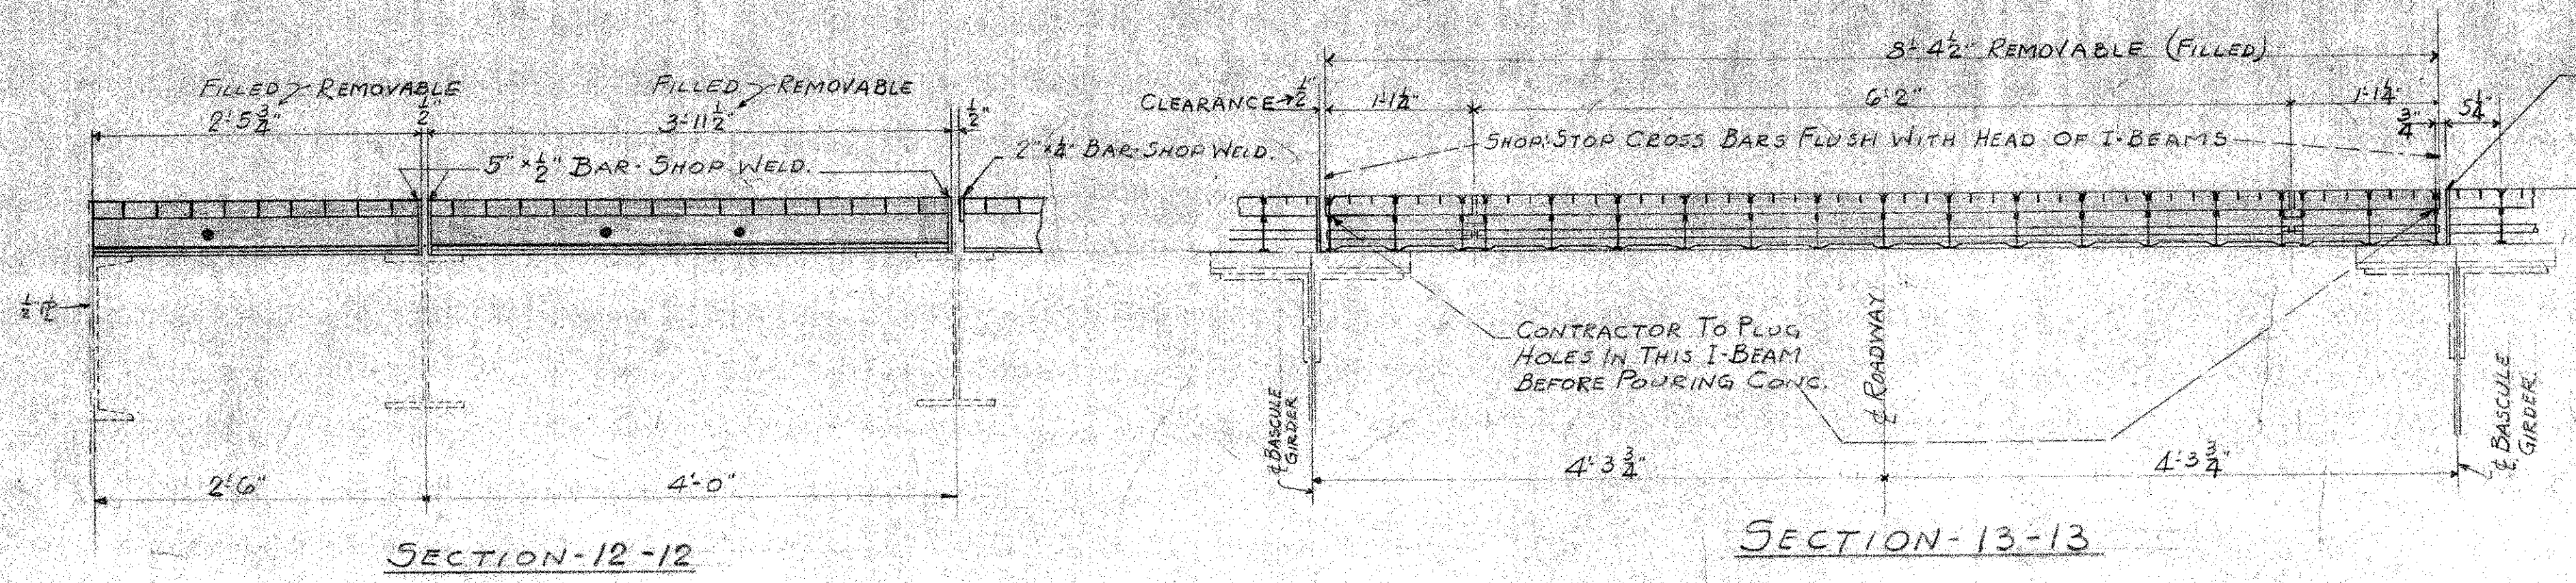

SECTION-12-12

SECTION-13-13

FOR GEN. NOTES & ADDITIONAL PLANS, F-4857
 FOR SECTIONS SEE F-4857 & F-4858

5" I-BEAM-LOK OPEN (TR & PL TYPE) FLOORING PLAN
 2" TEE-TYPE SIDEWALK (H) PLAN
 DOUBLE LEAF BASCULE SPAN (NORTH)
 GRAND ISLE - NORTH HERO BRIDGE
 COUNTY OF GRAND ISLE, VT.
 AMERICAN BRIDGE DIV. ORDER J-9757 CONT.

REVISED 10 4-23-52

UNITED STATES STEEL COMPANY
 SPECIALTY PRODUCTS DIVISION
 PITTSBURGH, PENNA.

DRAWN BY T-H-H, CHECKED BY F.W.B., DATE 1-16-52
 SHEET 2 OF 17 Dwg. No. F-4858

MILL NO. GP-2192-B