


TYPICAL SECTION

U.S. 5

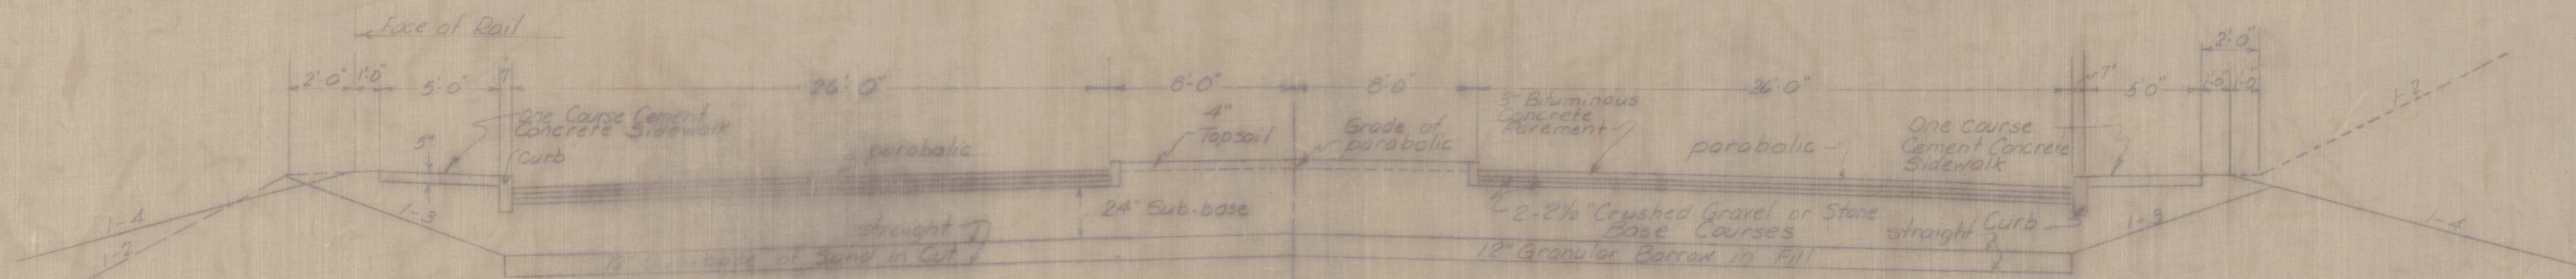

NORMAL SECTION

STATE OF VERMONT
DEPARTMENT OF HIGHWAYS

TOWN OF HARTFORD
ROUTE No U.S. 5 LOG STA _____
Barnes and Taft Avenue

SCALE _____

SURVEYED BY _____

DRAWN BY _____

CHECKED BY _____

PROJECT No. F110415

SHEET 2 OF 70