
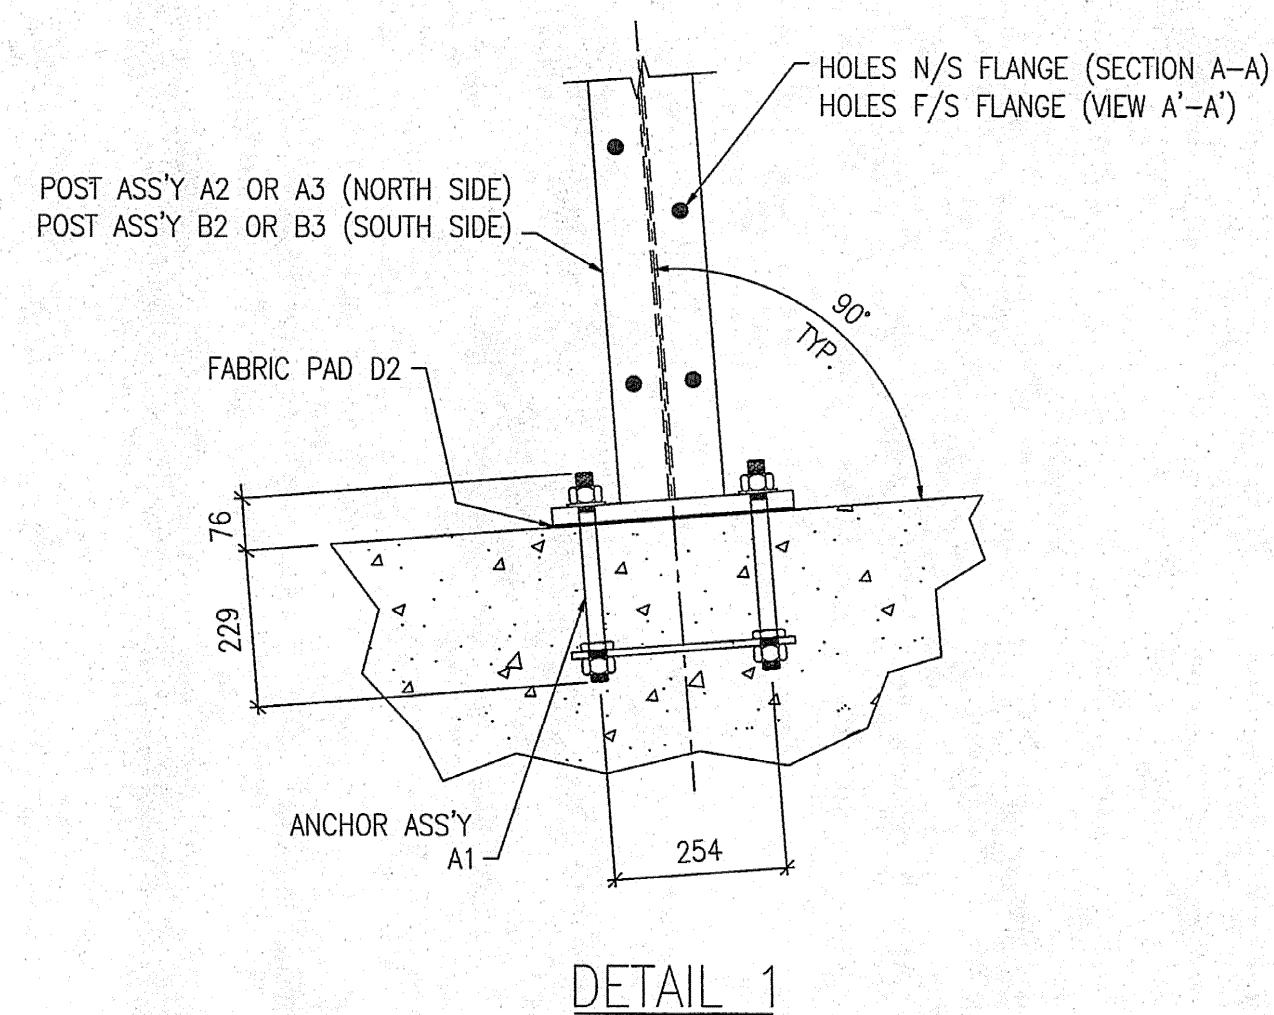


**FOR
APPROVAL**

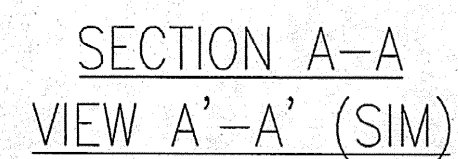

SHOP DRAWING REVIEW

☐ REVIEWED AS REQUIRED BY THE CONSTRUCTION CONTRACT DOCUMENTS AND APPROVED ONLY FOR CONFORMANCE TO THE DESIGN CONCEPT OF THE WORK, AND SUBJECT TO THE LIMITATIONS AND REQUIREMENTS CONTAINED IN THE CONSTRUCTION CONTRACT DOCUMENTS.

☐ REJECTED ☐ REWSE AND RESUBMIT ☐ FORUSH (SEE COMMENTS)

CORRECTIONS OR COMMENTS MADE ON THE SHOP DRAWINGS DURING THE REVIEW SHALL BE REVIEWED BY THE CONTRACTOR FROM COMPLIANCE WITH REQUIREMENTS OF THE DRAWING SPECIFICATIONS. THIS CHECK IS ONLY FOR REVIEW OF GENERAL CONFORMANCE WITH THE DESIGN CONCEPT OF THE PROJECT AND GENERAL COMPLIANCE WITH THE INFORMATION CONTAINED IN THE CONTRACT DOCUMENTS. THE CONTRACTOR IS RESPONSIBLE FOR CONFORMANCE WITH ALL QUALITY ASSURANCE REQUIREMENTS OF THE PROJECT AND THE CONTRACT DOCUMENTS OF CONSTRUCTION, COORDINATING HIS WORK WITH THAT OF ALL OTHERS AND PERFORMING HIS WORK IN A SAFE AND SATISFACTORY MANNER.

VHB Vanasse Hangen Brustlin, Inc.
Engineers, Planners, and Scientists
80 Bedford Farms, Boston Rd.
Bedford, NH 03110 603-564-0888

Job Number: 88811
Reviewed by: DMH
Date: 7-7-85

NOTES:

1. FOR BRIDGE RAILING ERECTION PLAN SEE DRAWING E24.
2. ALL RAIL POST ASSEMBLIES TO BE ERECTED WITH FLANGE HOLES FACING CENTER OF BRIDGE.

MAT'L : SEE GN-1			FIELD BOLTS																				
HOLES : 22Ø (7/8") U.N.O.			GRADE: A325																				
WELD :			* <table><tr><td></td><td></td><td></td></tr><tr><td></td><td></td><td></td></tr><tr><td></td><td></td><td></td></tr><tr><td></td><td></td><td></td></tr><tr><td></td><td></td><td></td></tr><tr><td></td><td></td><td></td></tr></table>																				
ELECTRODE : E70XX																							
PREP : SEE GN-1																							
PAINT : SEE GN-1																							
1	11/01/05	JM	RE-ISSUED FOR APPROVAL																				
0	09/06/04	JM	ISSUED FOR APPROVAL																				
REV.	DATE	BY	DESCRIPTION																				
WORK			CHK																				
NETC 4 RAIL-BRIDGE RAILING VT. ROUTE 78 OVER MISSISQUOI BAY ALBURG - SWANTON, VERMONT																							
DRAWING																							
RAIL POST ANCHOR PLAN - SPAN 7																							
SCALE: N.T.S.			SHEET																				
			E7 																				
DRAWN: JM			JOB																				
CHECK: RH			050004																				
CIANBRO CORPORATION PITTSFIELD MAINE																							