



TR#2 5+42.17 ~ TR#2 5+64.20 RT
New 18"x48" ACGMP (OK)

TR#2 5+59 RT
End Vertical Granite Curb

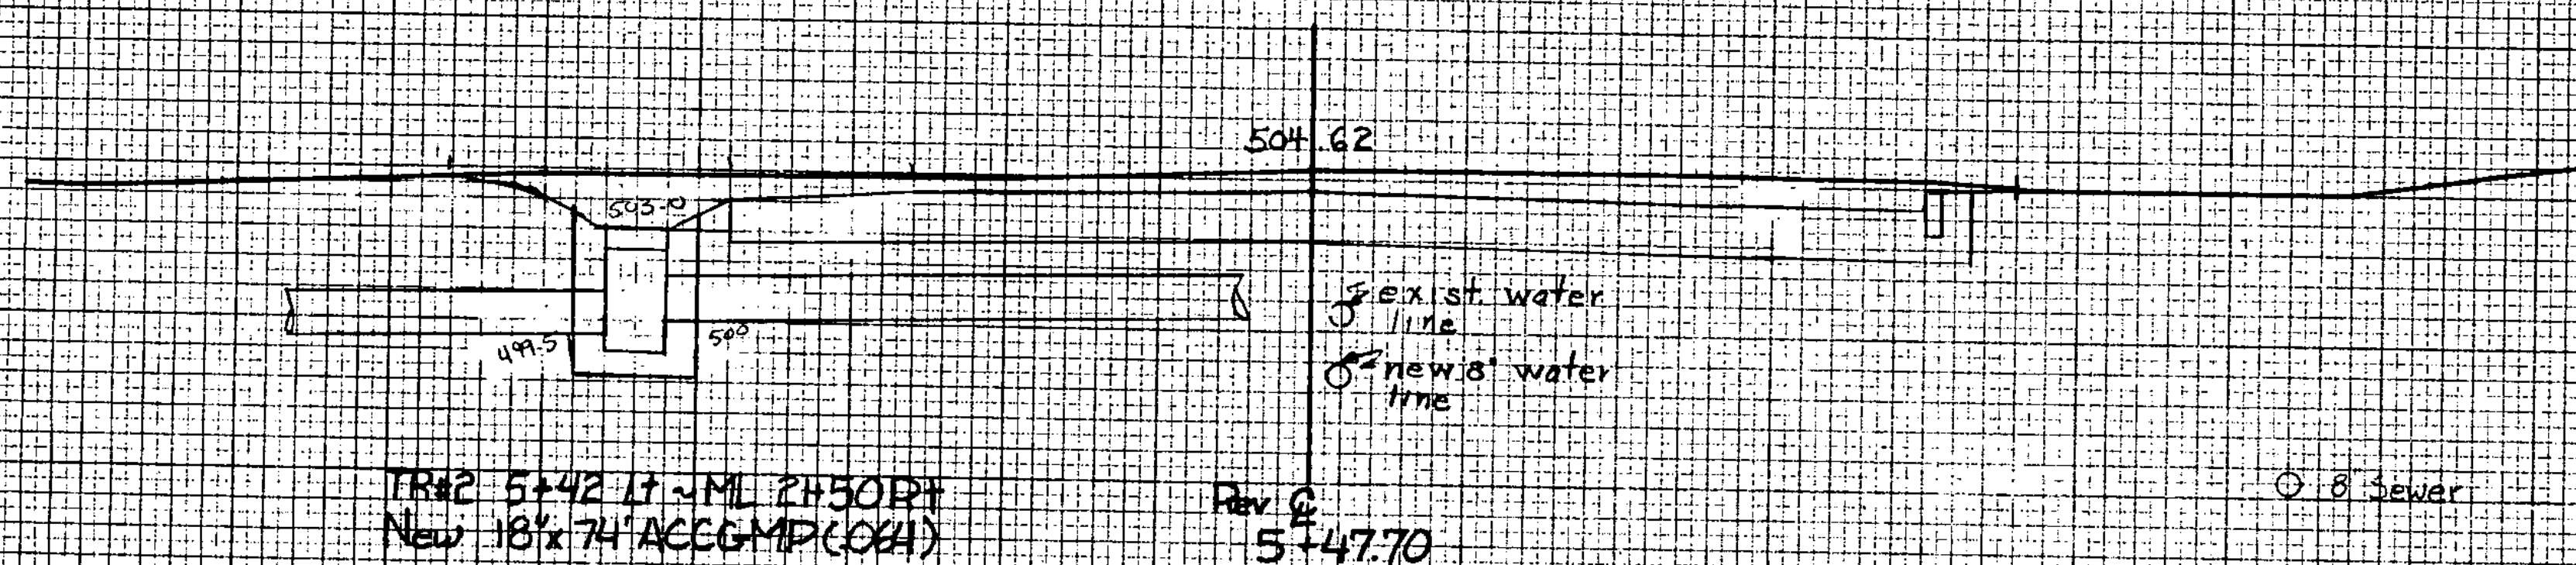


TR#2 5+42.17 ~ ML 2+50 RT
New 18"x74" ACGMP (OK)

Rev C
5+47.70

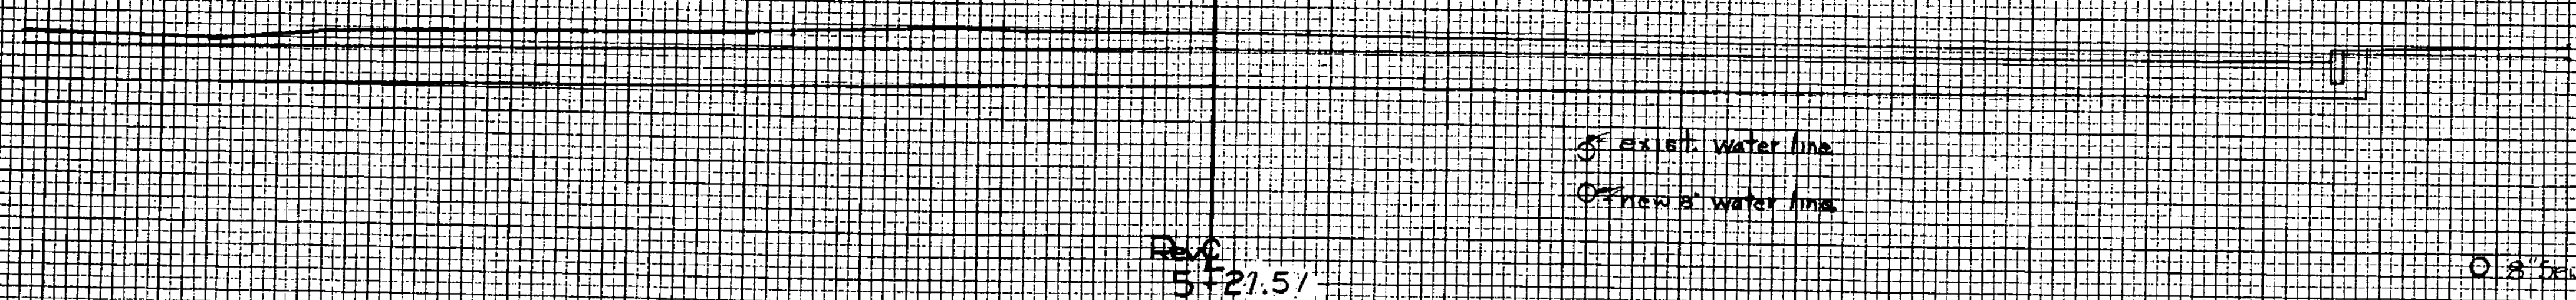

Rev C
5+21.51

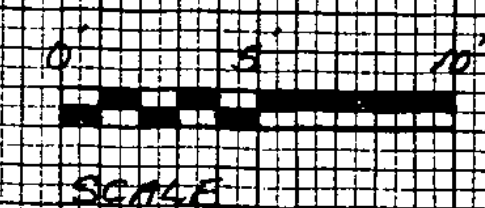

TR#2
Hinesburg F021-035
Sheet 68 of 76