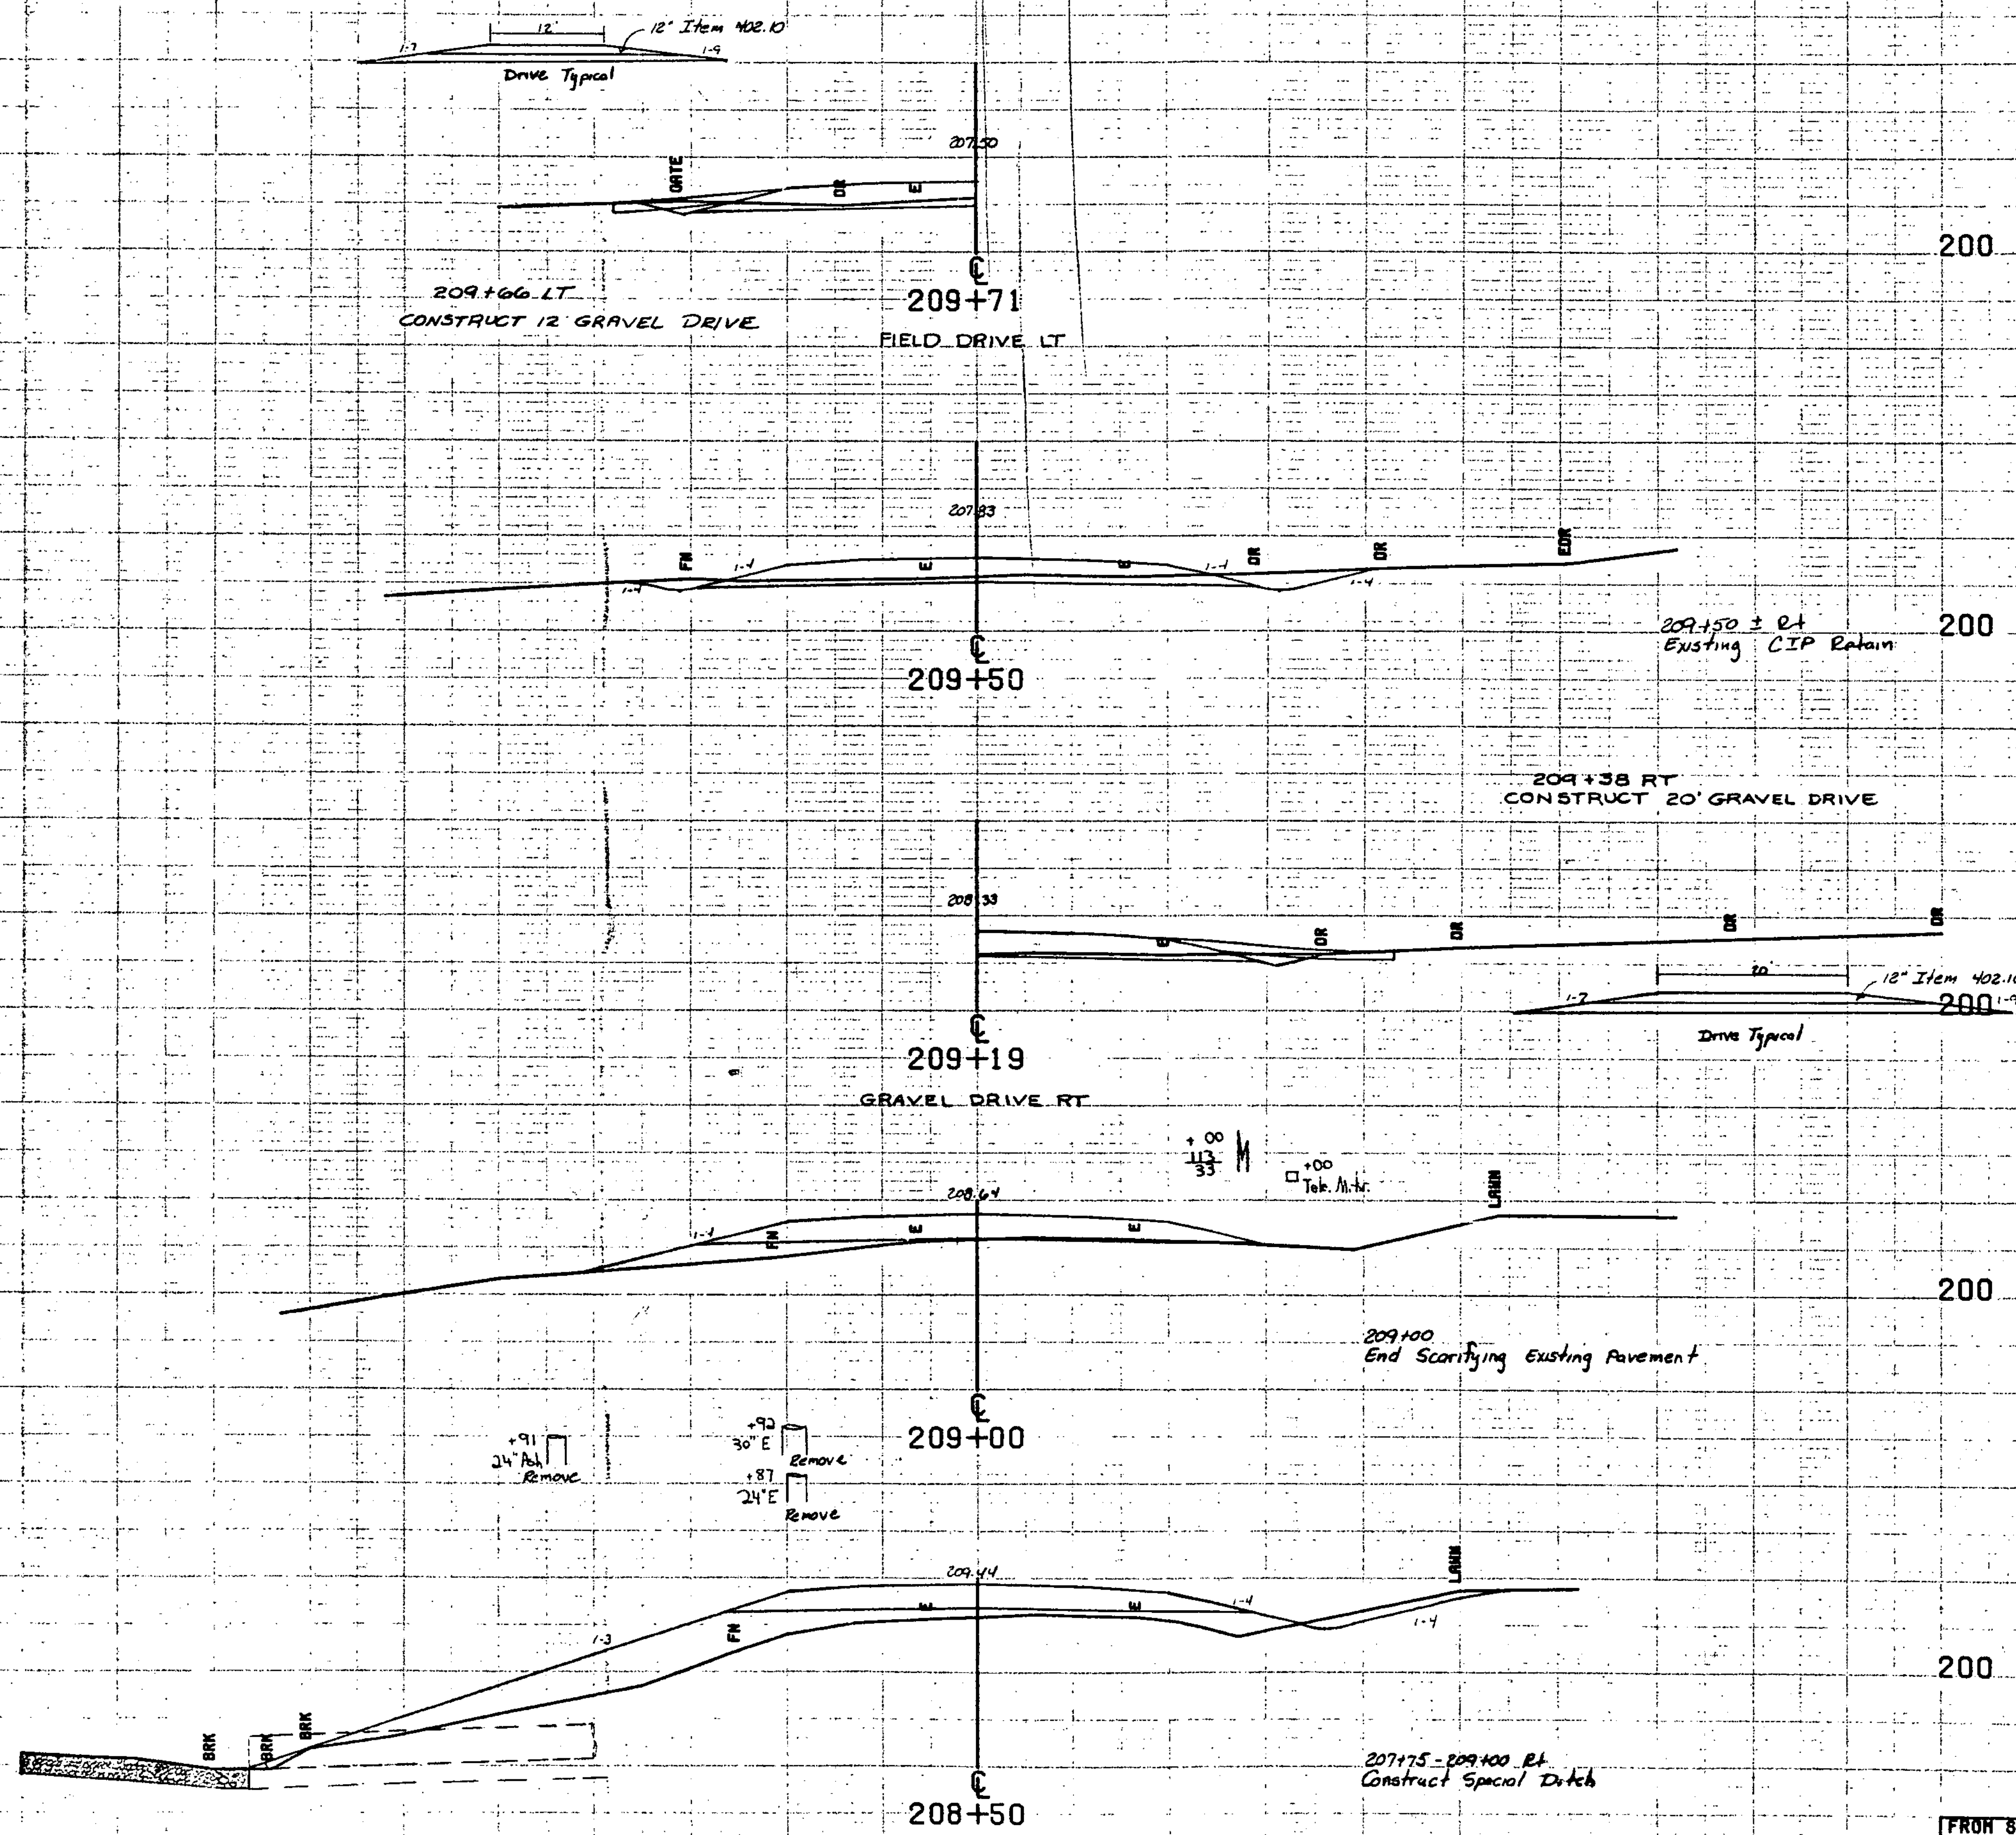


FROM STA. 208+50	TO STA. 209+71
PROJECT NAME	FERRISBURG M/L
NO.	F EGC F 019-4 (11)
SURVEYED BY	CARLSON
SHEET 28 OF 62 SHEETS	PLOTTED 05/27/80 APRIL 1980

SCALE 1" = 10 FEET