



PLAN	DATE	BY	CHECKED
SUBMITTED	9/73	Fall/Fantoni	Trombly
PLANNED			
NOTED			
NO. OF WY. CHECKED			

PROFILE	DATE	BY	CHECKED
SUBMITTED	9/73	Fall/Fantoni	Trombly
PLANNED			
NOTED			
NO. OF WY. CHECKED			

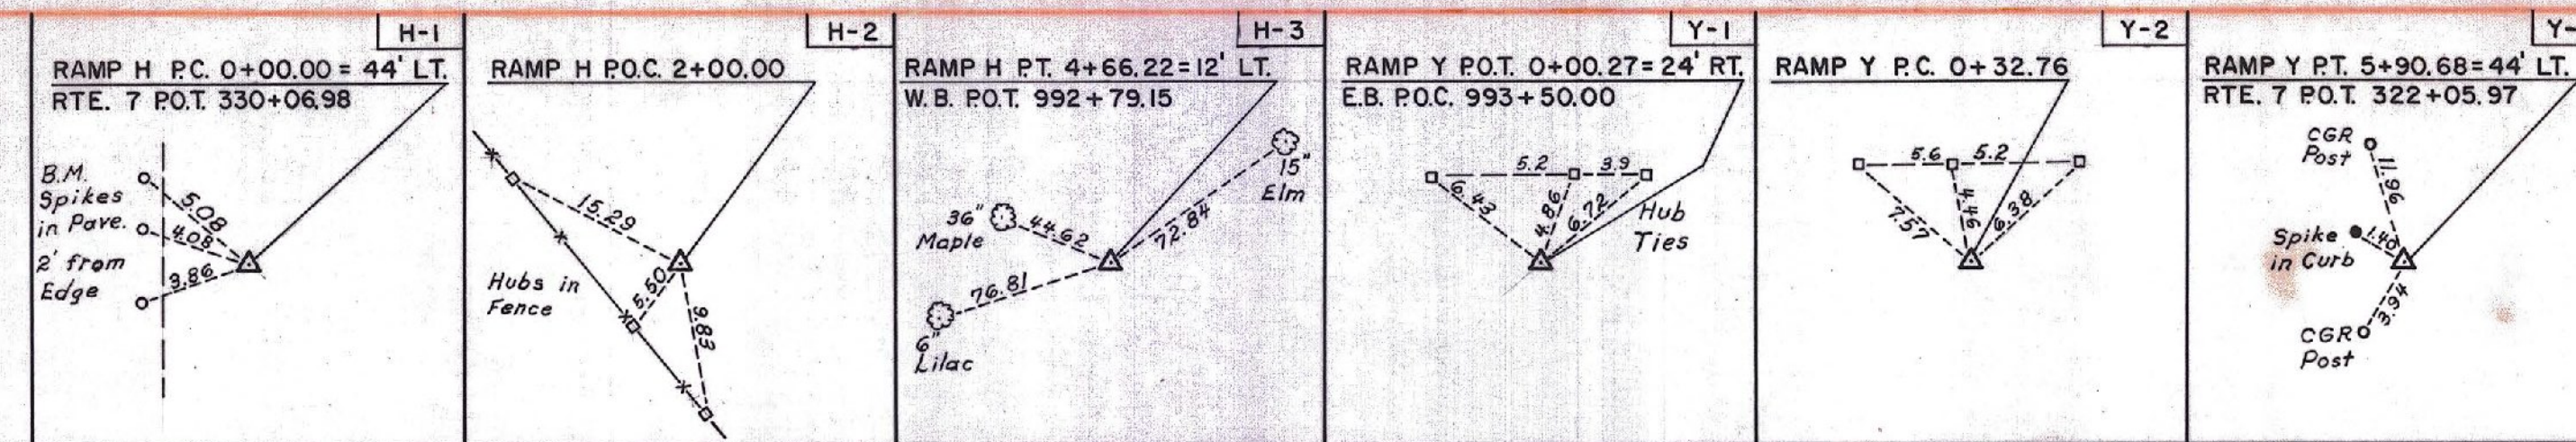


Stage 2 Finished Grades Shown
 Stage 1 Subgrade Elev. 2.67' (2 ft. 8 in.) Below

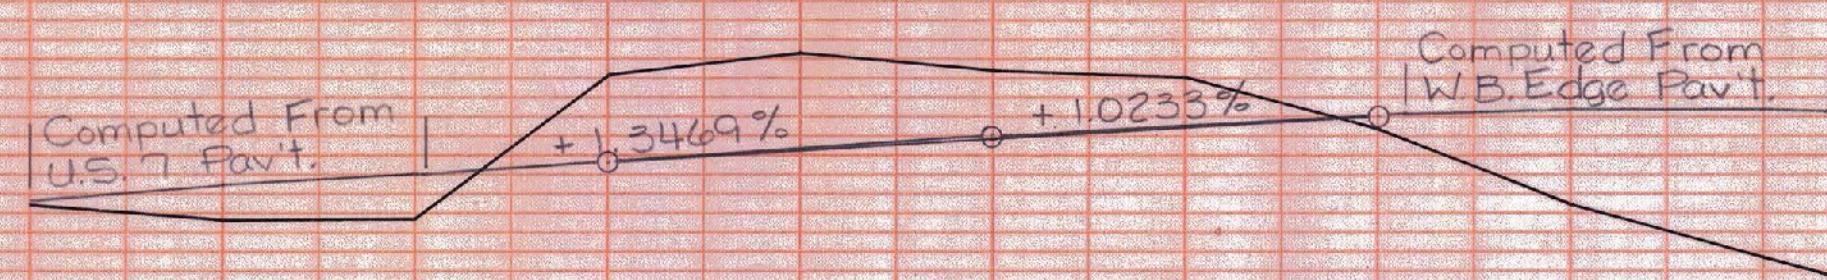

RAMP H

0+ U.S. 7 330+06.98 Lt. 1 2 3 4 +66.22 W.B. 992+79.15

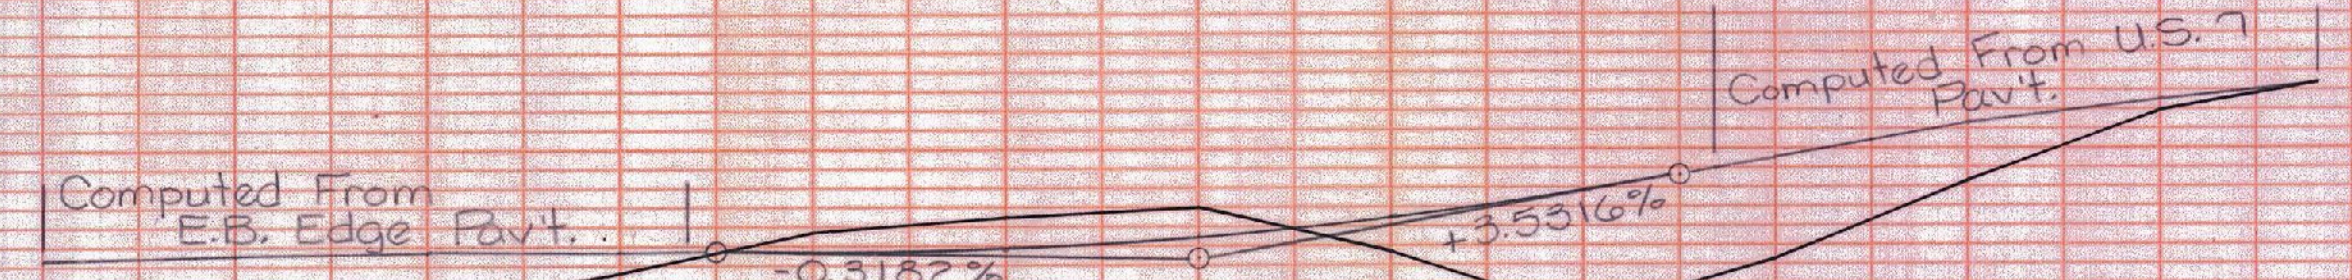

RAMP Y

0+00.27 E.B. 993+50.00 1 2 3 4 5 +90.68 U.S. 7 322+05.97 Lt.

PROFILE	SCALE
HORIZ. 1" = 20'	VERT. 1" = 10'

WEST RUTLAND-RUTLAND F 020-1(10)

Sheet 70 of
 Stage I Construction