


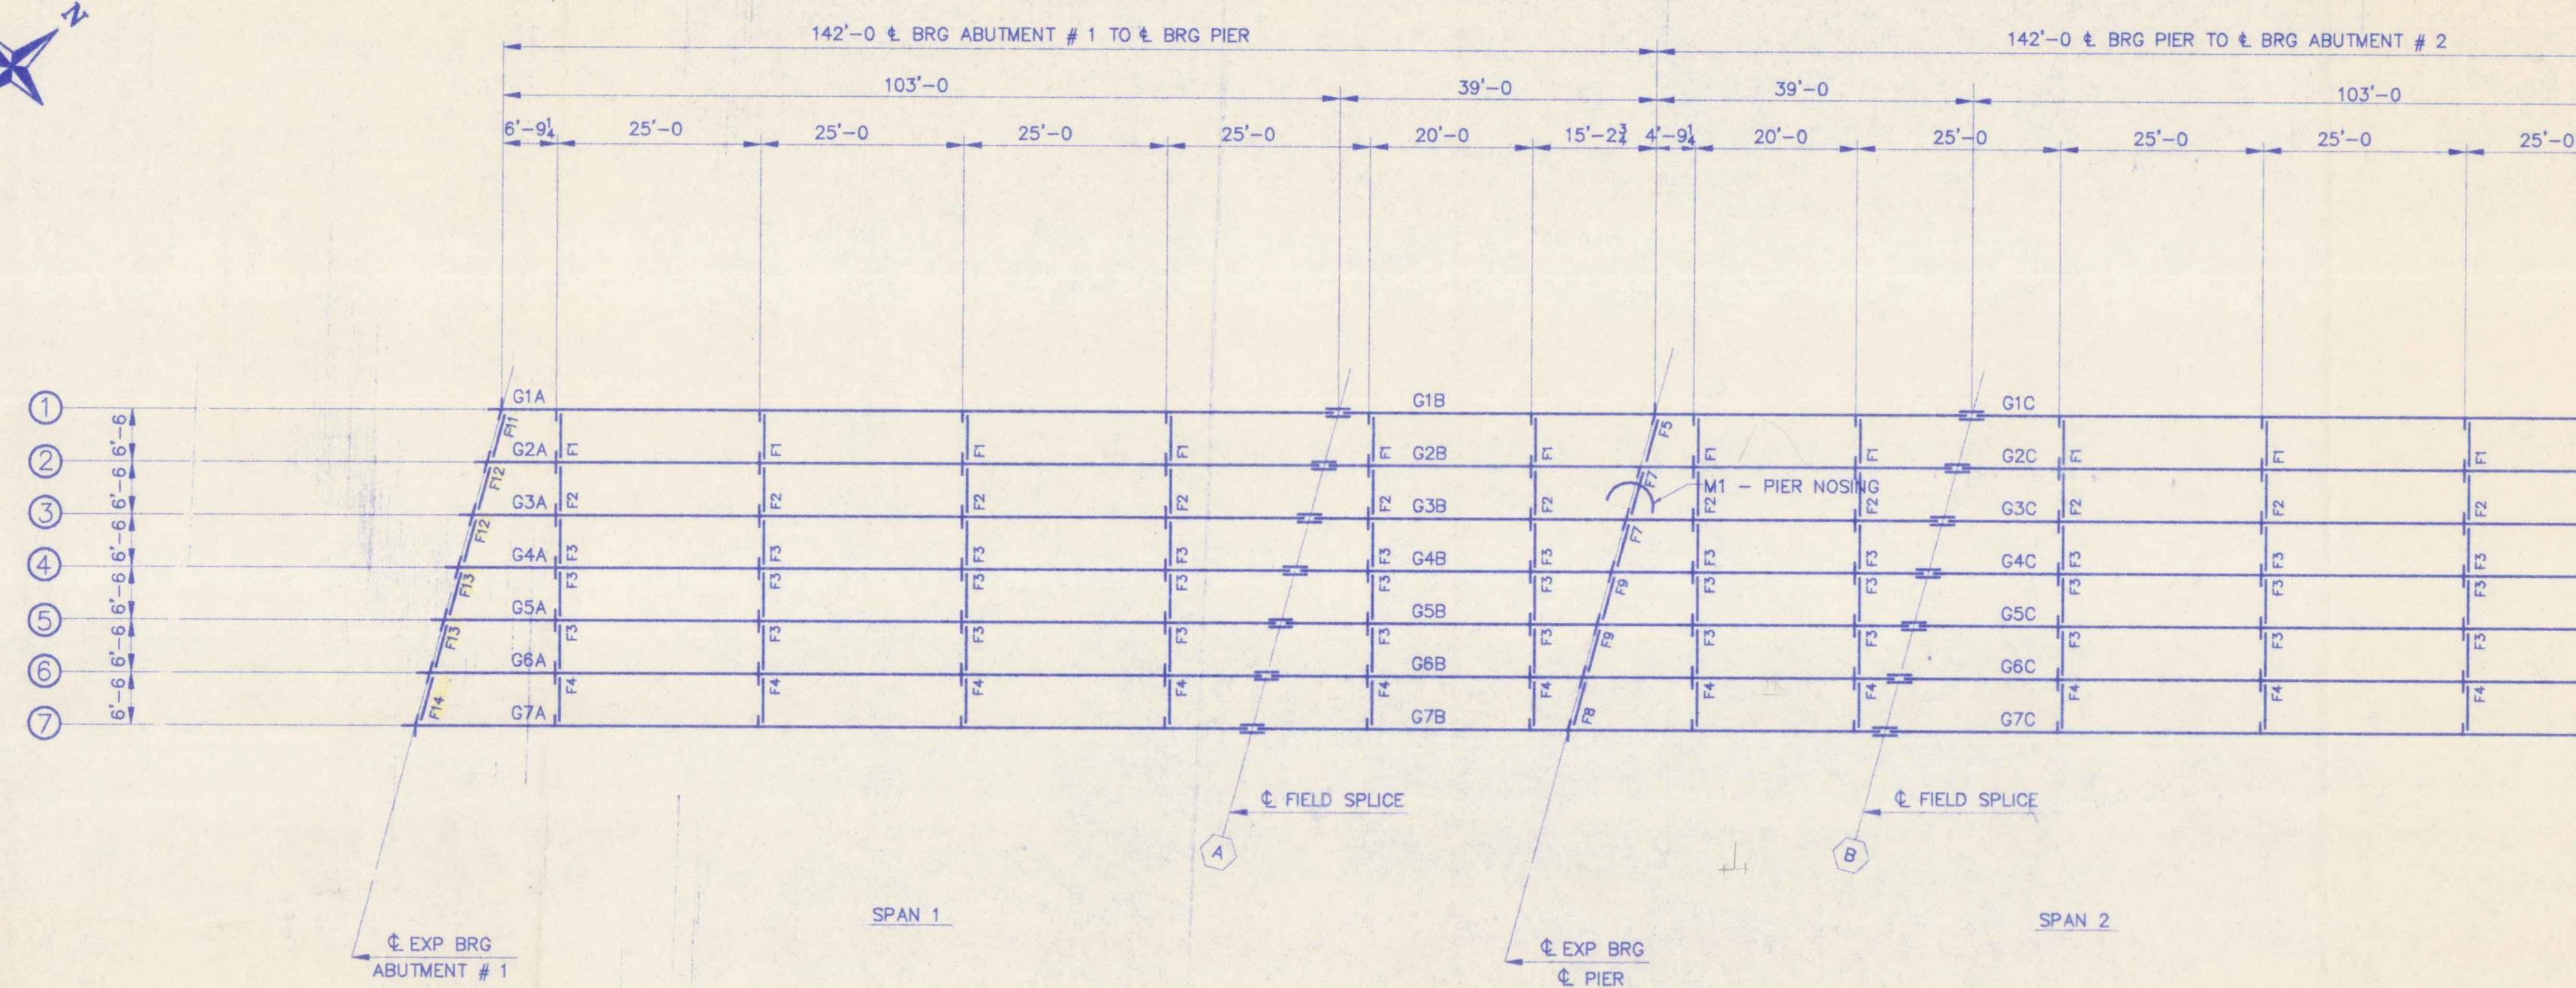

STEEL FRAMING PLAN

NOTES

1. DIMENSIONS SHOWN ARE HORIZONTAL AND DO NOT REFLECT ANY CHANGE DUE TO GRADE.

☒ No Exception Taken ☐ Make Corrections Noted
☐ Review and Re-submit ☐ Not Acceptable
Reviewed only for general conformance with the design concept of the project and general compliance with the information given in the contract documents. The contractor is responsible for verifying and correcting all quantities and dimensions and performing his work in a satisfactory manner.
MUFARLAND-JOHNSON ENGINEERS, INC.
Date 12/11/98 BY SPB

ITEM NO.	506.55
TITLE	STEEL FRAMING PLAN
APPROVED:	
PRINT DIST	
5	10/18/96 APPR
DRG	12/3/96 FAB
5	11/18/96 APP
CHECKED	11/19/98 CSD
DRAWN	8/96 CSD