

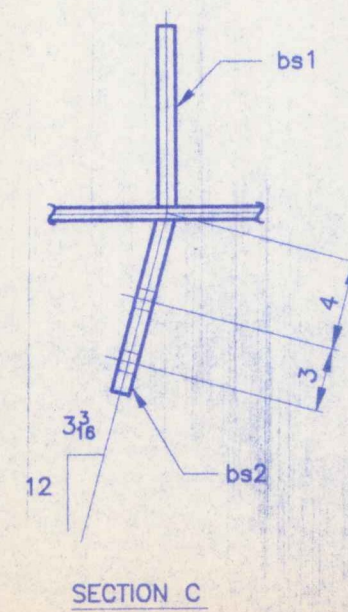


$\otimes$
1'-10
2'-2
5'-10
6'-2
9'-10
13'-10
14'-2
17'-10
18'-2
21'-10
22'-2
25'-10
26'-2
29'-10
30'-2
33'-10
34'-2
37'-10
38'-2
41'-10
42'-2
45'-10
46'-2
49'-10
50'-2
53'-10
54'-2
57'-10
61'-10
62'-2
65'-10
66'-2
68'-10
69'-2
72'-10
73'-2
75'-10
76'-2
79'-10
80'-2
83'-10
84'-2
87'-10
88'-2
91'-10
92'-2
95'-10
96'-2
99'-10
100'-2

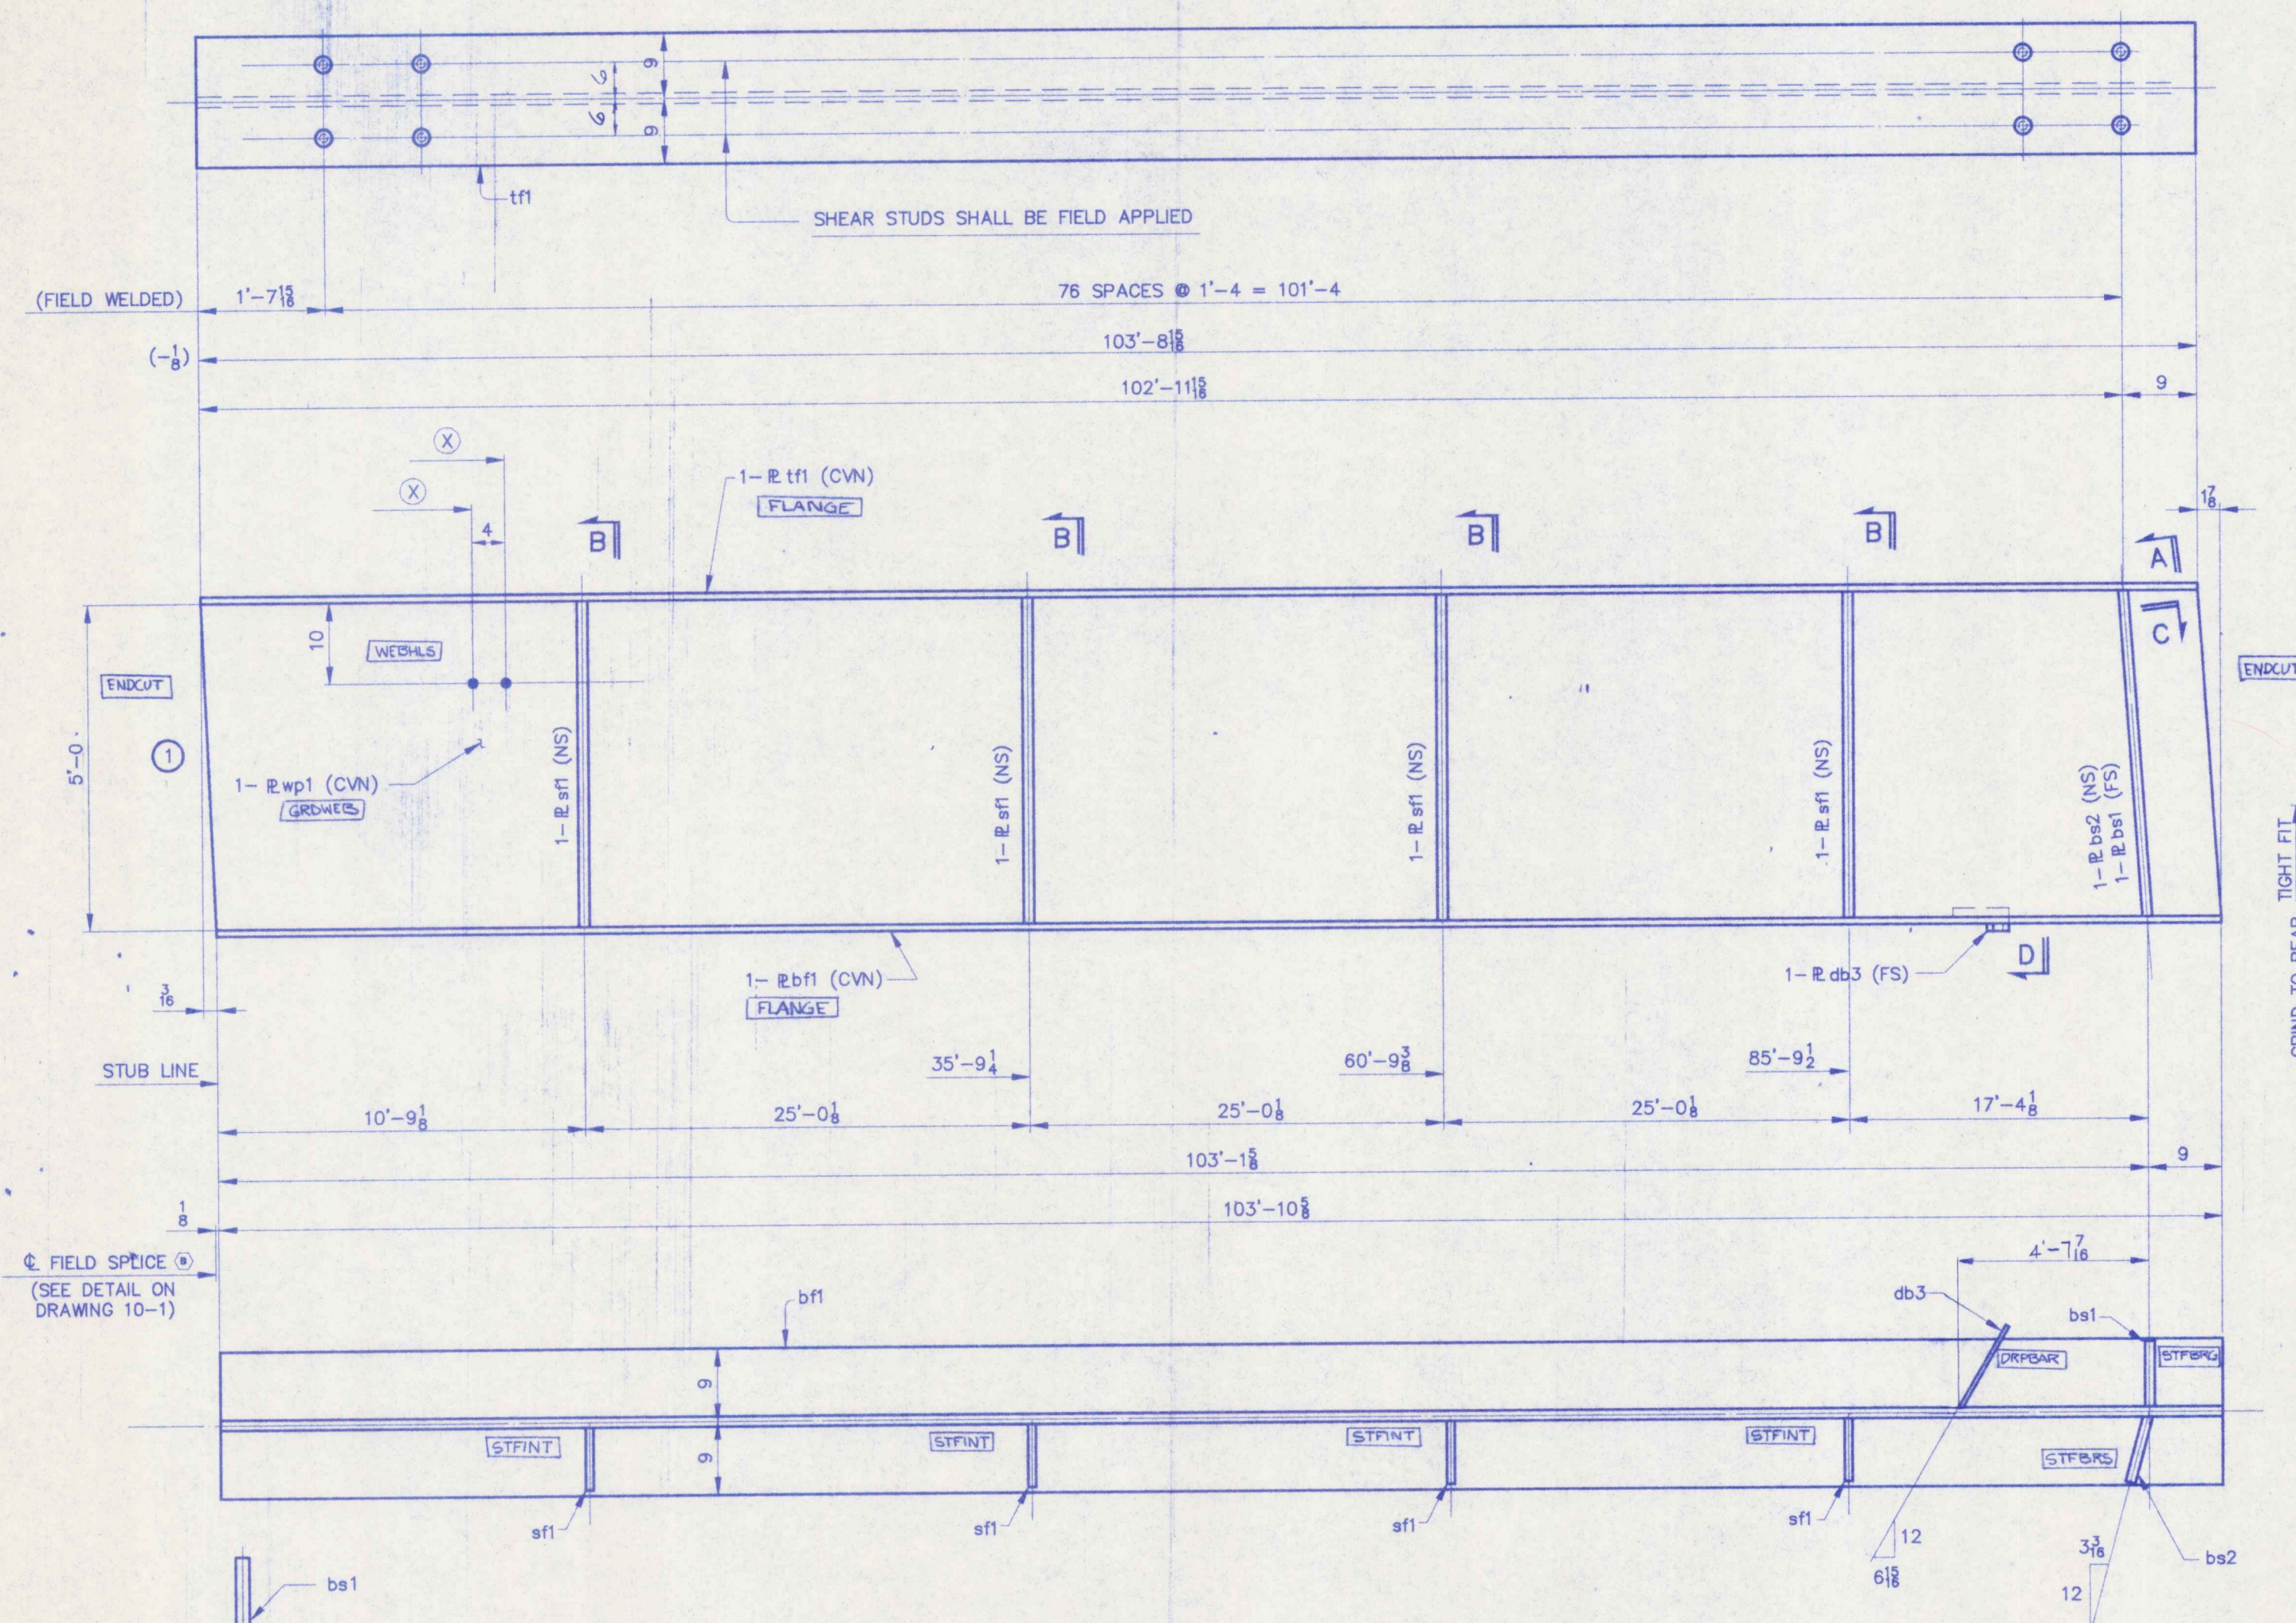

ONE ~ GIRDER ~ G1C
GIRDER

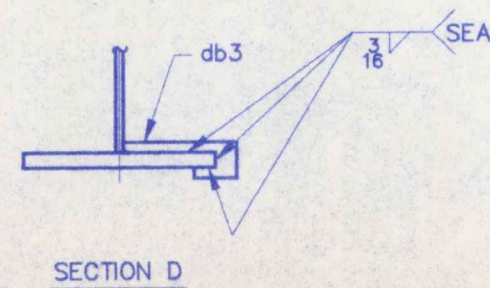


SECTION D

☒ No Exception Taken ☐ Make Corrections Noted
☐ Revise and Resubmit ☐ Not Acceptable

Reviewed only for general conformance with the design concept of the project and general compliance with the information given in the contract documents. The contractor is responsible for confirming and correlating all quantities and dimensions and performing his work in a satisfactory manner.

McFARLAND-JOHNSON ENGINEERS, INC.

Date 12/12/94 BY SPB

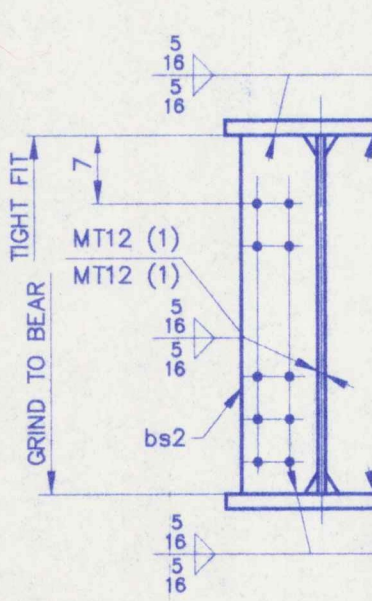[illegible]

SECTION 1

- 1.
- 2.
- 3.

STEEL: ASTM
WELDING ELEC
HOLES:
PAINT:
SPECIAL PAINT
SPECIAL CLEAR
ITEM NO. 506
TITLE:

APPROVED:	
PRINT D	
5	10-19-
ORIG	12-3-9
5	11-18-9

CHECKED	10/9/01
DRAWN	9/9/01