
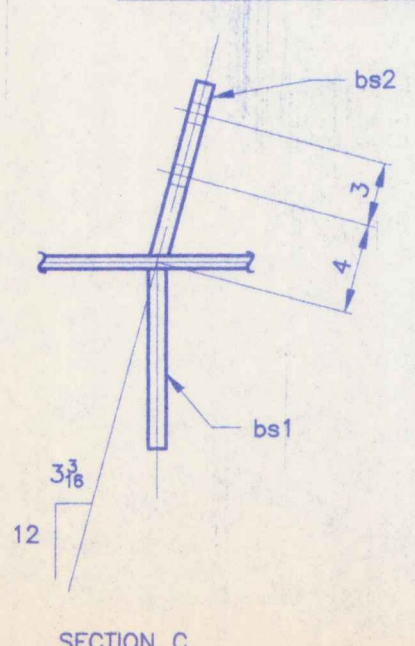


[illegible]

ONE ~ GIRDER ~ G7C

GIRDER

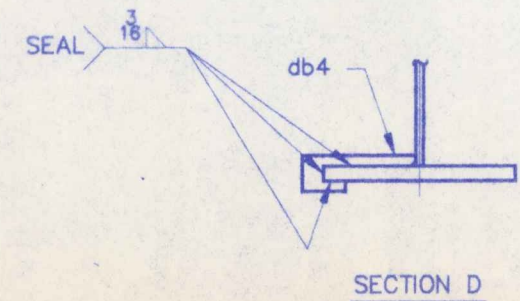

☒ No Exception Taken ☐ Make Corrections Noted
☐ Revise and Resubmit ☐ Not Acceptable

Reviewed only for general conformance with the design
intent of the project and general compliance with the design
information given in the contract documents. The contractor is
responsible for confirming and correlating all quantities and
dimensions and performing his work in a satisfactory manner.

McFARLAND-JOHNSON ENGINEERS, INC.

Date 12/12/96 BY SPB

[illegible]