



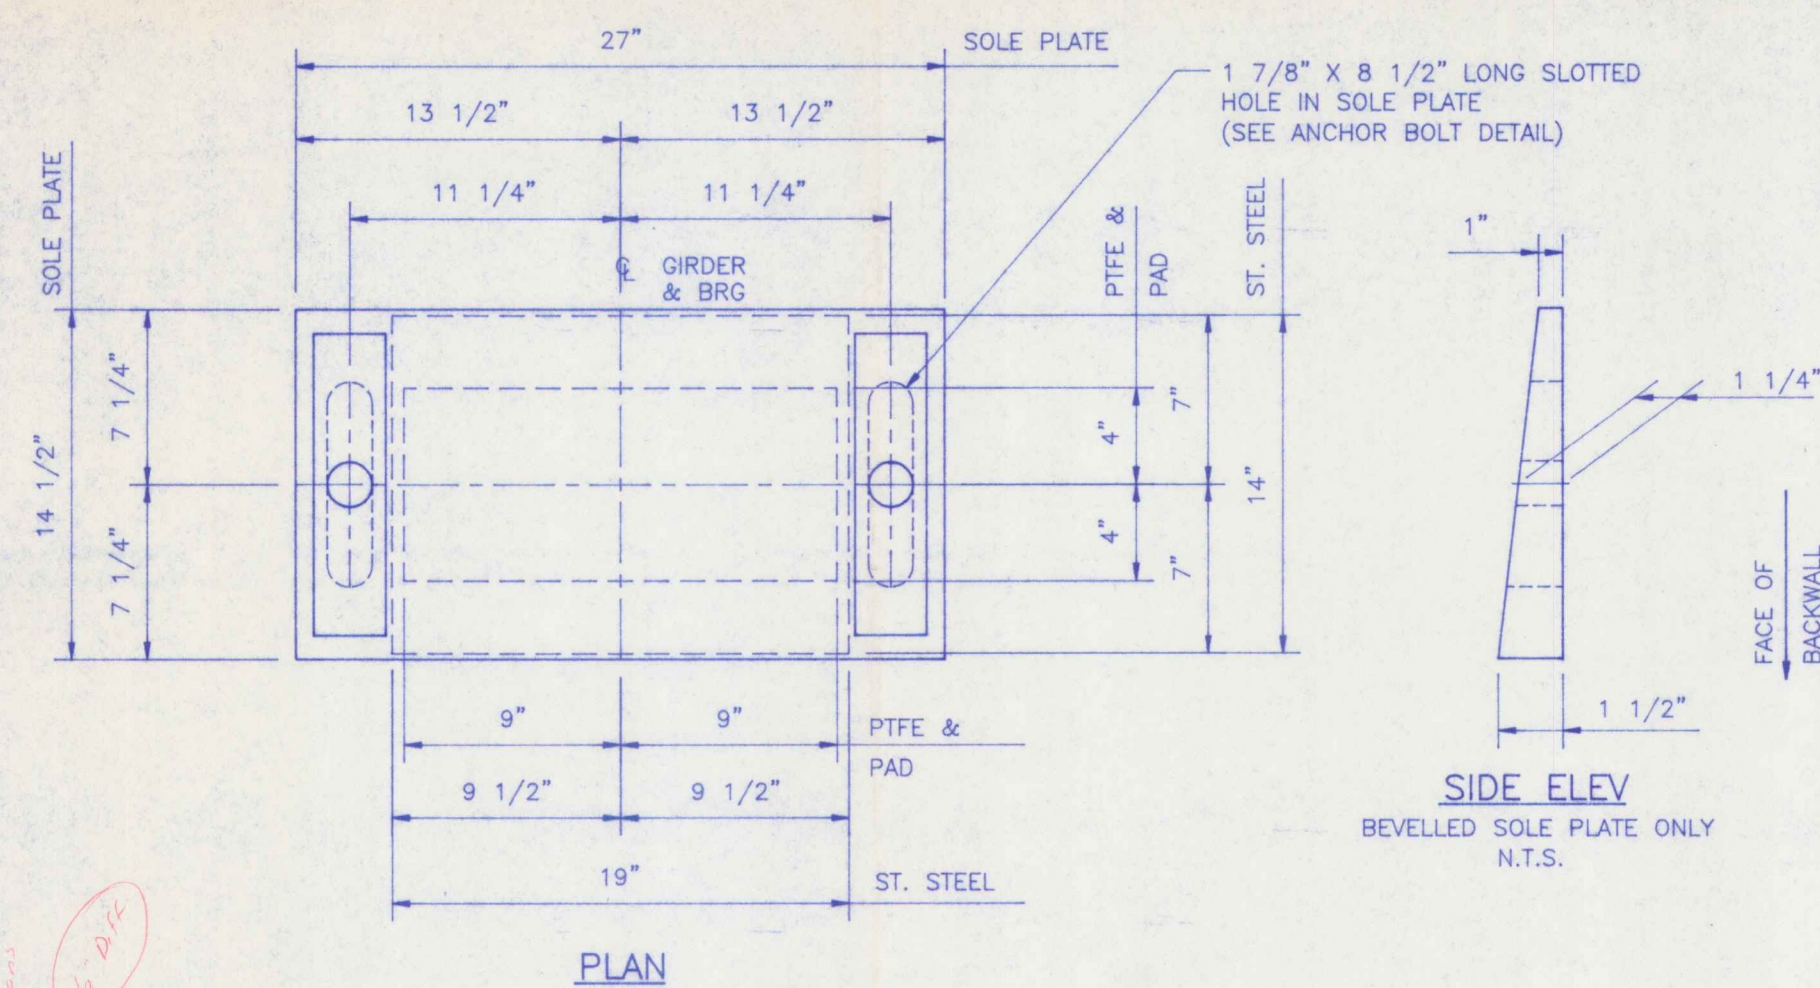

SIDE ELEV
BEVELLED SOLE PLATE ONLY
N.T.S.


PLAN

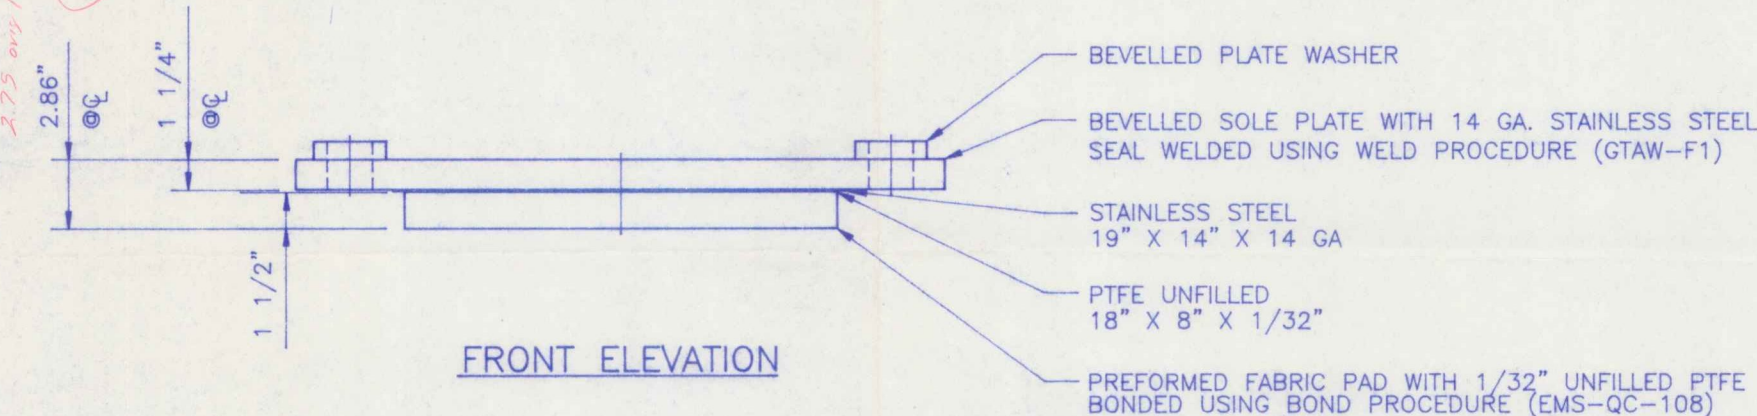

FRONT ELEVATION

EXPANSION BEARING

LOCATION - ABUTMENT NO. 1
QUANTITY REQUIRED - 7

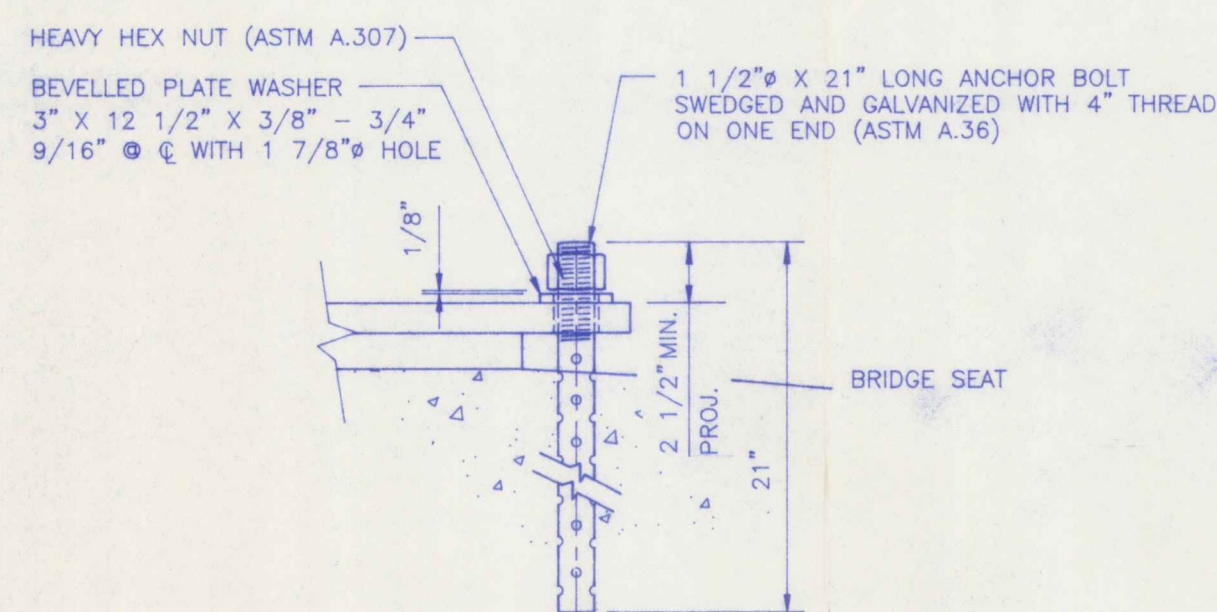


SIDE ELEVATION

EXPANSION BEARING ANCHOR BOLT DETAIL
QUANTITY REQUIRED FOR EXPANSION BEARING @ ABUTMENT NO. 1 - 14


THREADS SHALL BE BURRED TO PREVENT REMOVAL

NUTS, BOLTS, AND WASHERS TO BE SUPPLIED BY COSMEC, INC.

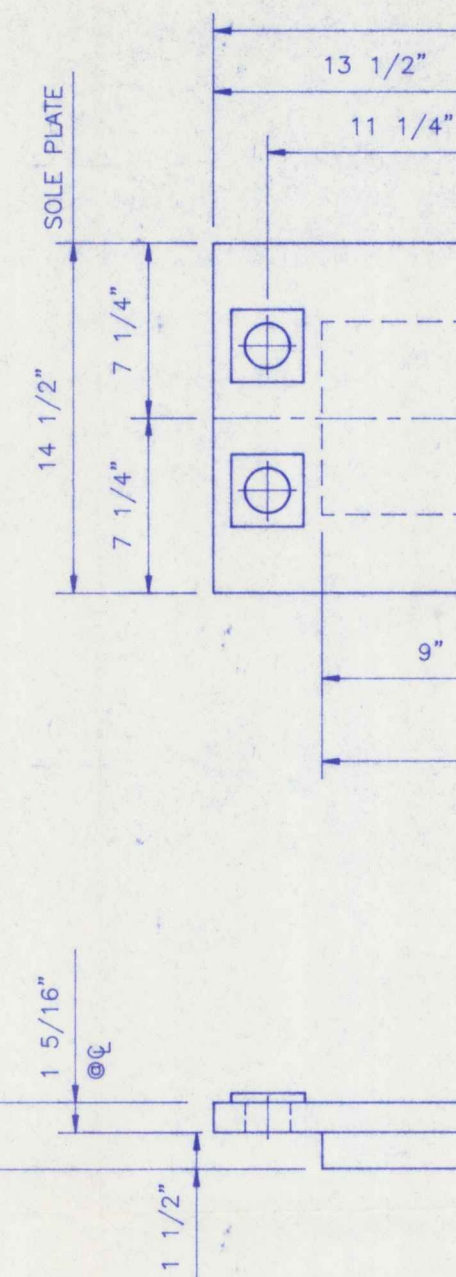

FRONT ELEVATION

FIXED BEARING
LOCATION -
QUANTITY REQUIRED -

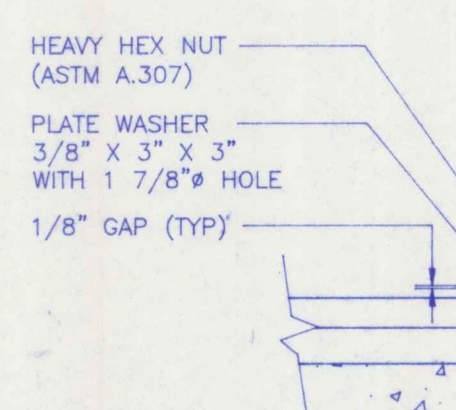

SIDE ELEVATION

FIXED BEARING ANCHOR BOLT DETAIL
QUANTITY REQUIRED FOR FIXED BEARING @ ABUTMENT NO. 1 - 14