


WORK ORDER NO.	DRAWING NO.	REV.
15713	E1	

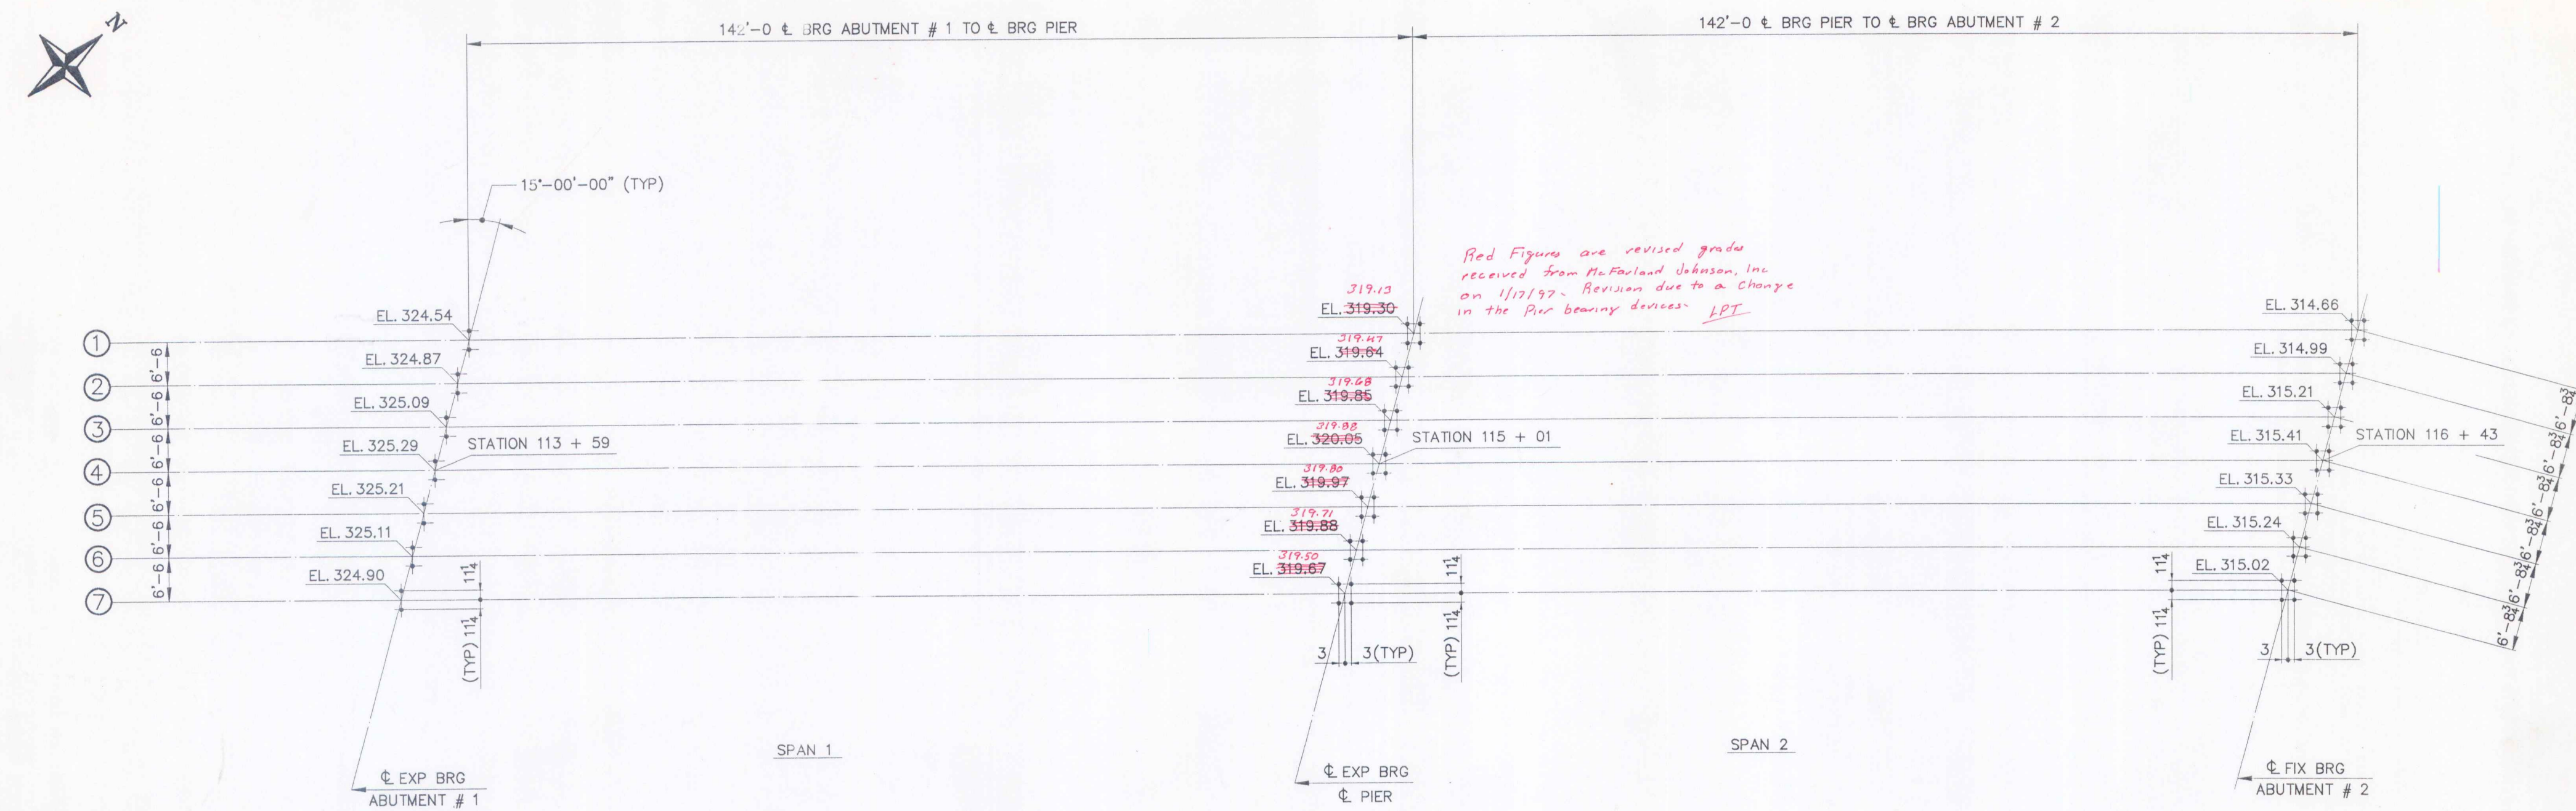

BRIDGE GEOMETRY

(FOR REFERENCE ONLY)

NOTES

- ELEVATIONS ARE TO TOP OF CONCRETE BEARING PADS.
- DIMENSIONS SHOWN ARE HORIZONTAL AND DO NOT REFLECT ANY CHANGE DUE TO GRADE.

ITEM NO.	506.55	BRIDGE NO.	44	PROJ. NO.	BRS-RS 0113 (8)
TITLE:	BRIDGE GEOMETRY				
APPROVED:					
PRINT	5	DATE	12-14-94	APP.	
ORIG	5	DATE	12-13-96	FAB.	
ORIG	5	DATE	11-13-96	HP	
ORIG	4	DATE	4-2-97	VAT	
National Eastern Corporation Plainville, Connecticut					
JOB: U.S. ROUTE 5 OVER BLACK RIVER SPRINGFIELD, VERMONT					
CUSTOMER: WINTERSETT, INC.					
DESIGNER: VERMONT AGENCY OF TRANSPORTATION					
WORK ORDER NO.		DRAWING NO.		REV.	
15713		E1			
CHECKED	10/1/96	APP.			
DRAWN	9/96	CSD			