
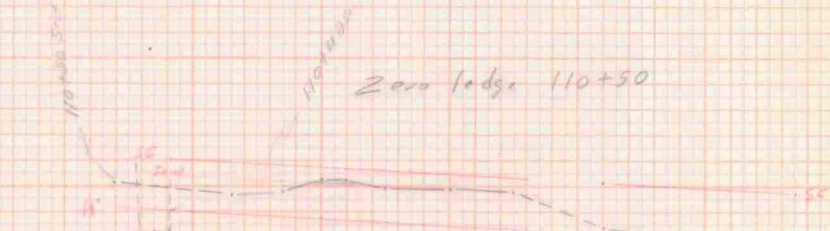
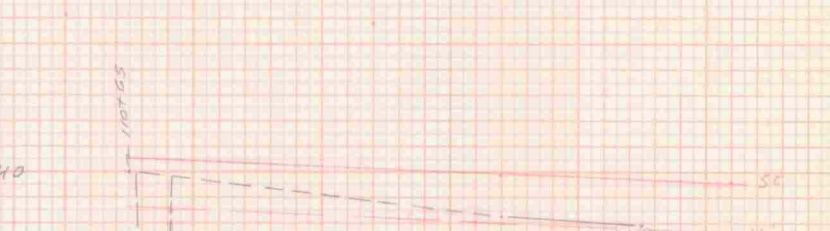
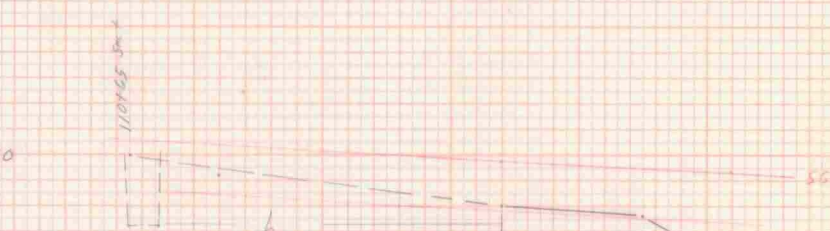
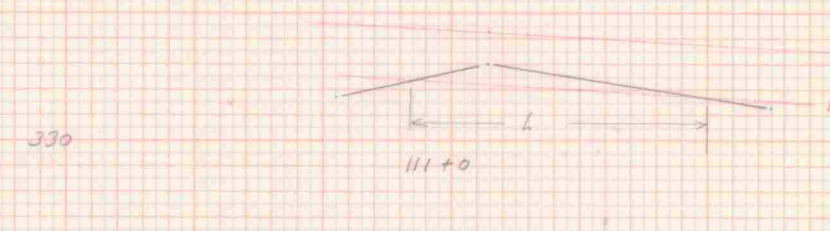
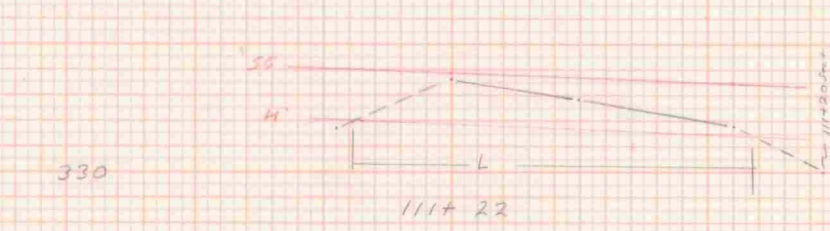
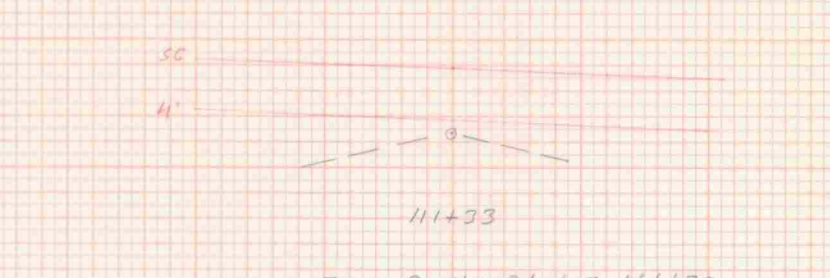
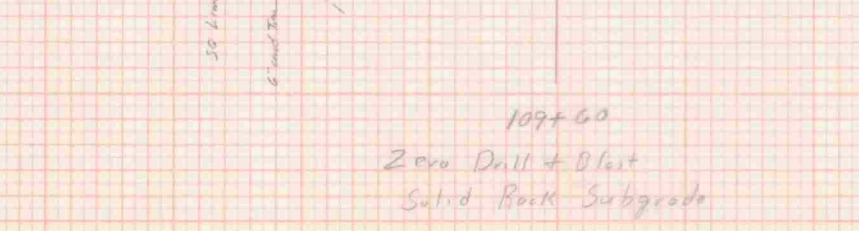
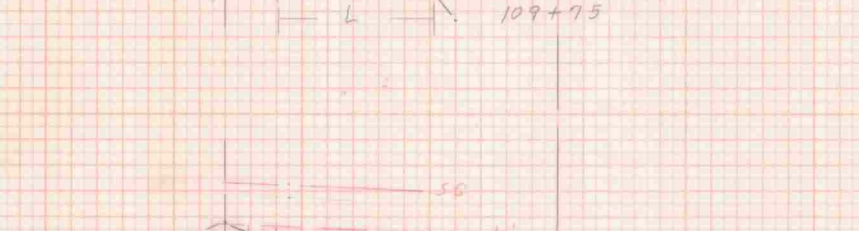
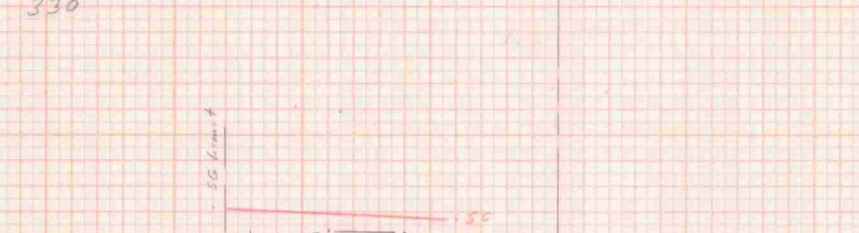
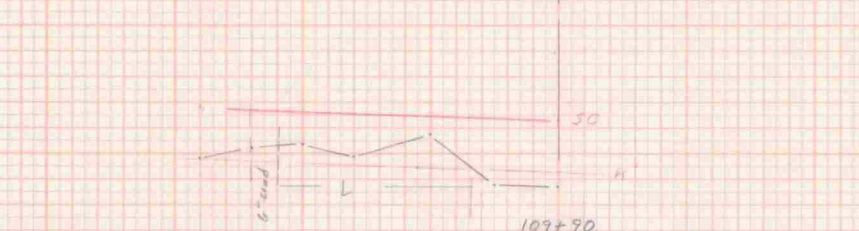
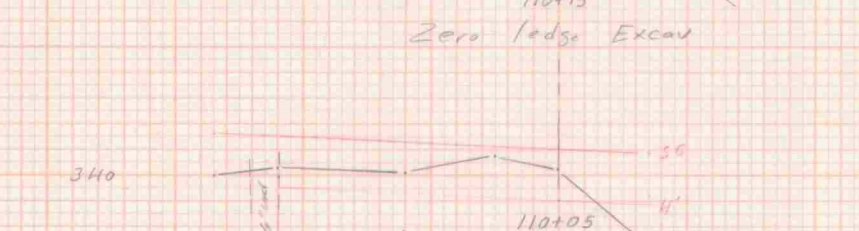
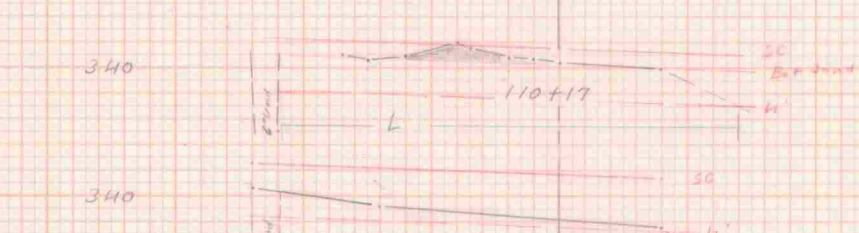
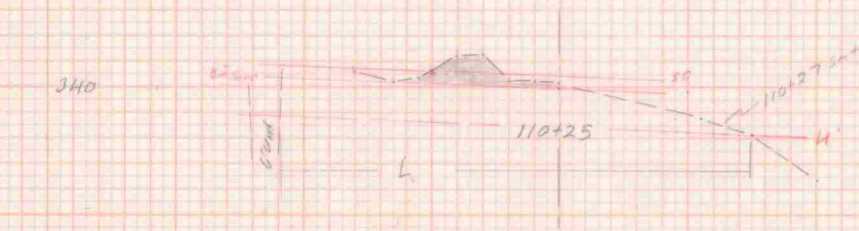


1. PROJECT
 2. SHEET NO.
 3. DATE
 4. DRAWN BY
 5. CHECKED BY
 6. APPROVED BY

1. PROJECT
 2. SHEET NO.
 3. DATE
 4. DRAWN BY
 5. CHECKED BY
 6. APPROVED BY

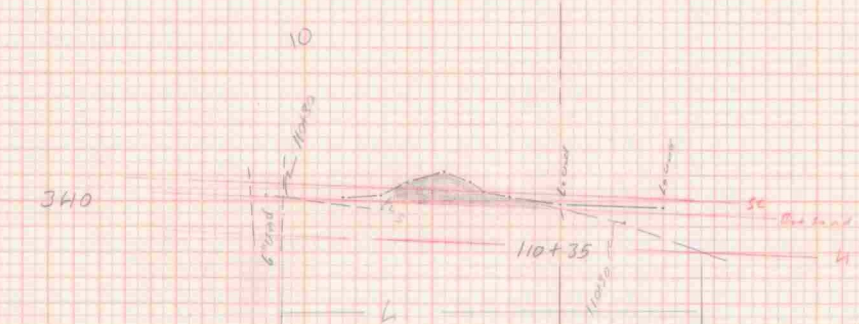

Item 203.16 Edge Excav

Sta	From	To	Length	Vol
110+15	0	5.33'	2	0.395'cy
110+17	10.67'	10.96'	8	3.242'cy
110+25	11.25'	9.245'	10	3.469'cy
110+35	9.16'	4.125'	13	1.986'cy
110+48	1.09'	0.545'	2	0.040'cy
110+50	0			
Total				9.08'cy

6PT
 16 APR 97
 8m 4-21-97
 20.0. 12/9/97

Item 205.20 Drilling + Blasting Solid Rock Subgrade

Sta	Length	From	To	Length	Vol
109+60	0	6	15	10.0	
109+75	12	13.5	15	22.5	
109+90	15	19.25	15	32.2	
110+05	24.5	2.7	10	30.0	
110+15	28.5	38.5	2	72	
110+17	35.5	36	8	32.0	
110+25	36.5	34.5	10	38.3	
110+35	32.5	35.0	13	50.5	
110+48	37.5	Pier 6' and E 110+50 (27' long) (2 B. and)			-15.6
110+60	31.5	2.9	10	32.2	
110+70	26.5	24.75	20	24.5	
111+0	23	27	22	66.0	
111+22	31	15.5	8	13.7	
111+30	0				

Total 344.25
 16 APR 97
 8m 4-21-97
 20.0. 12/9/97

Springfield BAS RS 0113(8)
 Item 203.16 Edge excav
 Item 205.20 Drilling + Blasting Subgrade
 Scale 1" = 10'
 L.P. Foster