



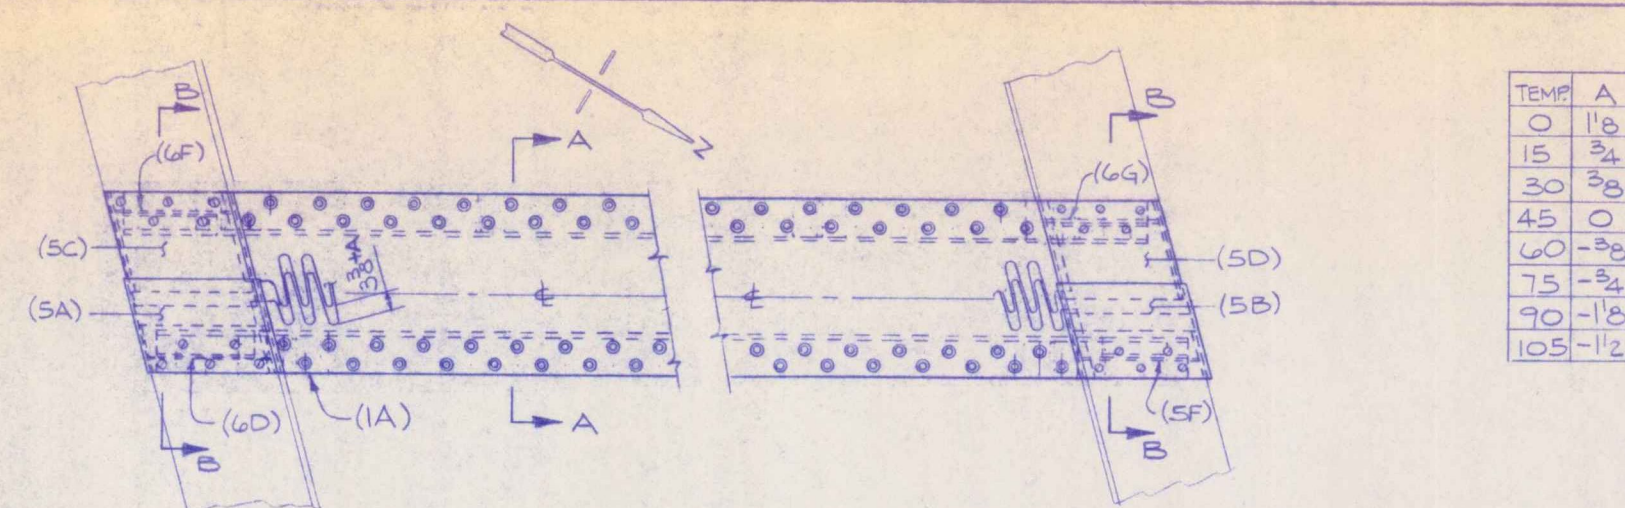


TEMP	A
0	1.0
15	3/4
30	5/8
45	1/2
60	3/8
75	5/16
90	1/4
105	3/16


PLAN AT FINGER JOINT
(ABUT. 1)

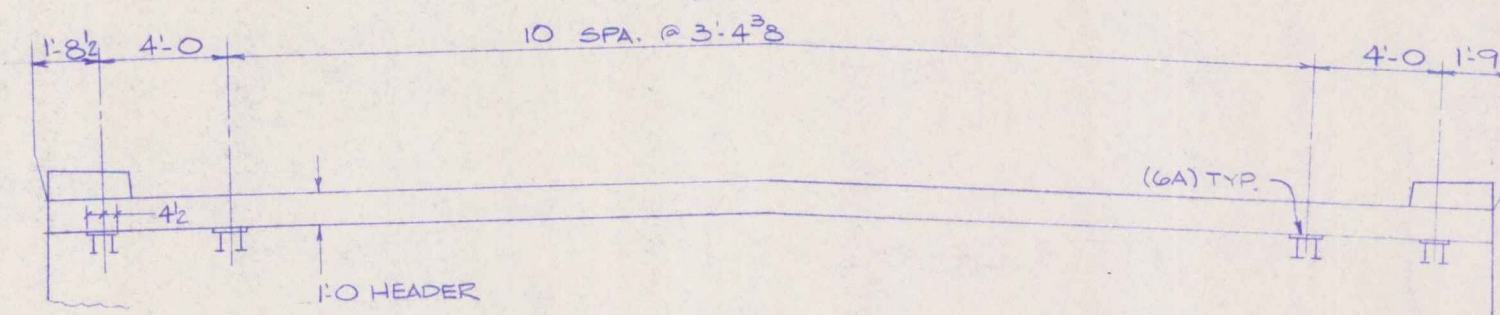

ELEVATION - EMBEDDED REINFORCEMENT LOCATIONS

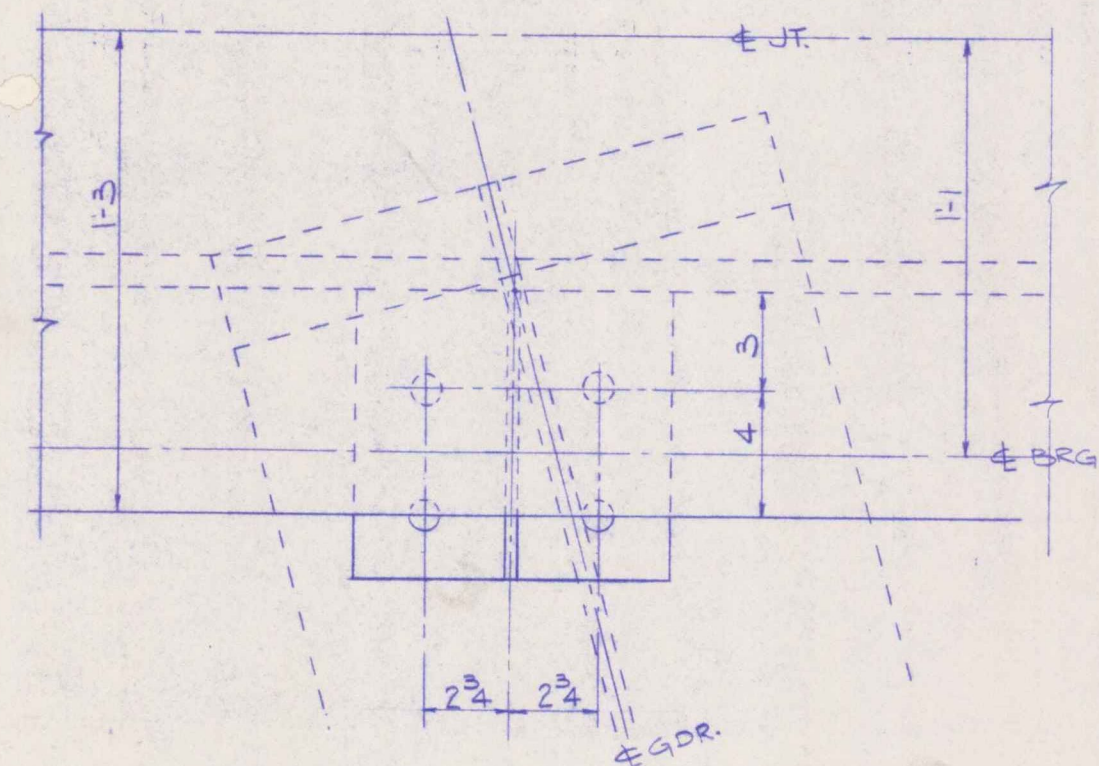

PLAN AT GIRDER SUPPORT

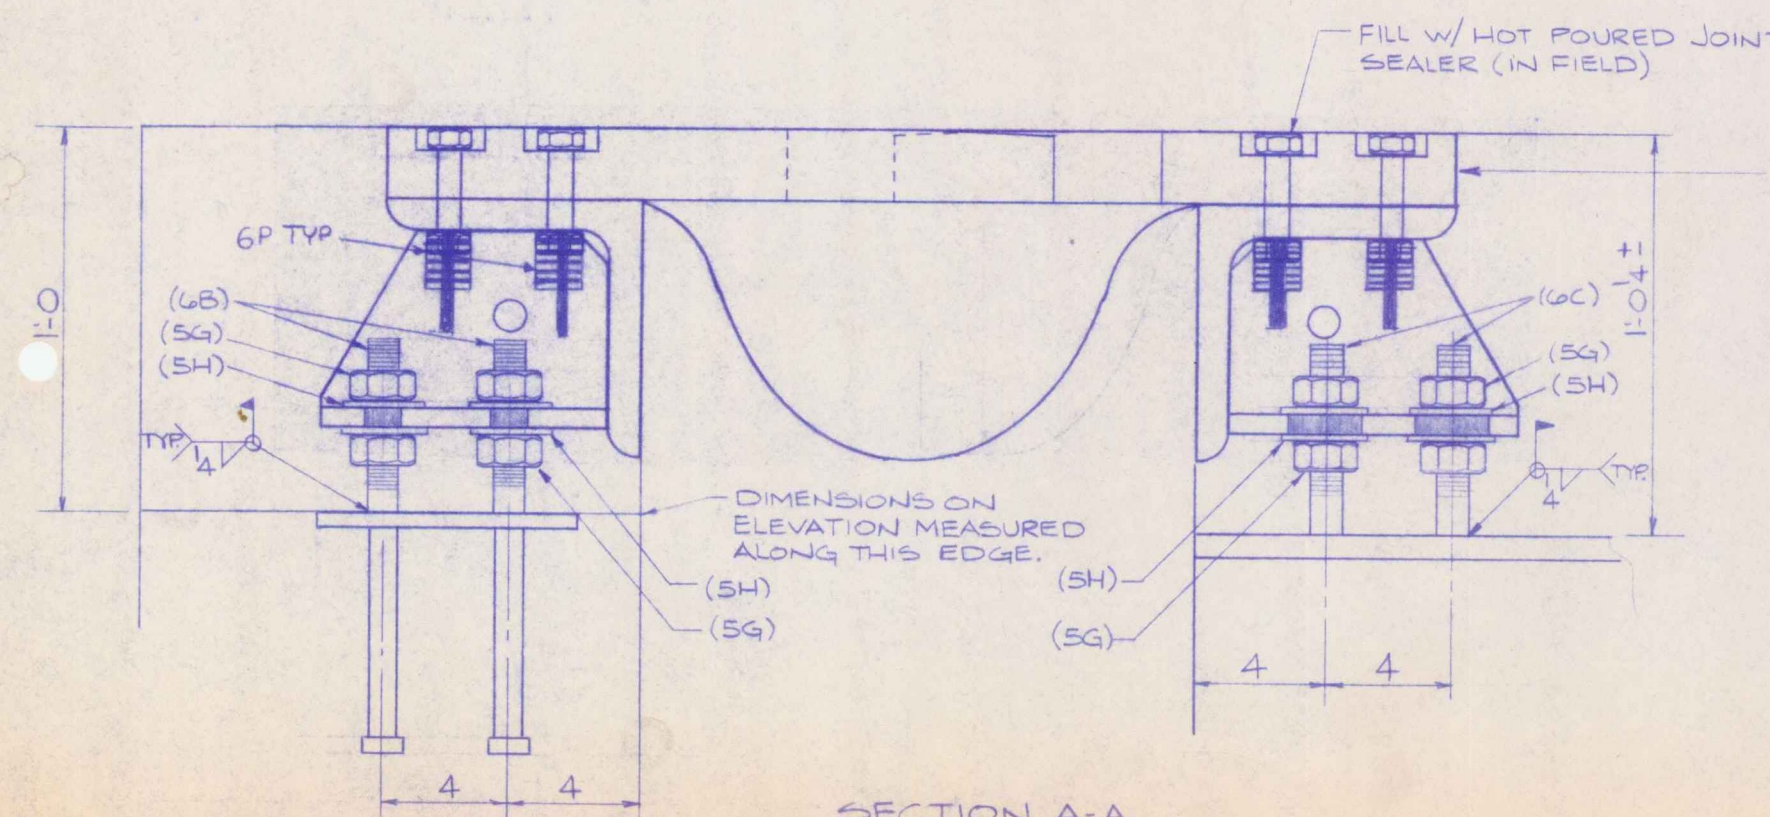


SECTION A-A

COAT CONCRETE CONTACT SURFACES W/ EPOXY BONDING COMPOUND (IN FIELD)



ANCHOR FERRULE DETAIL

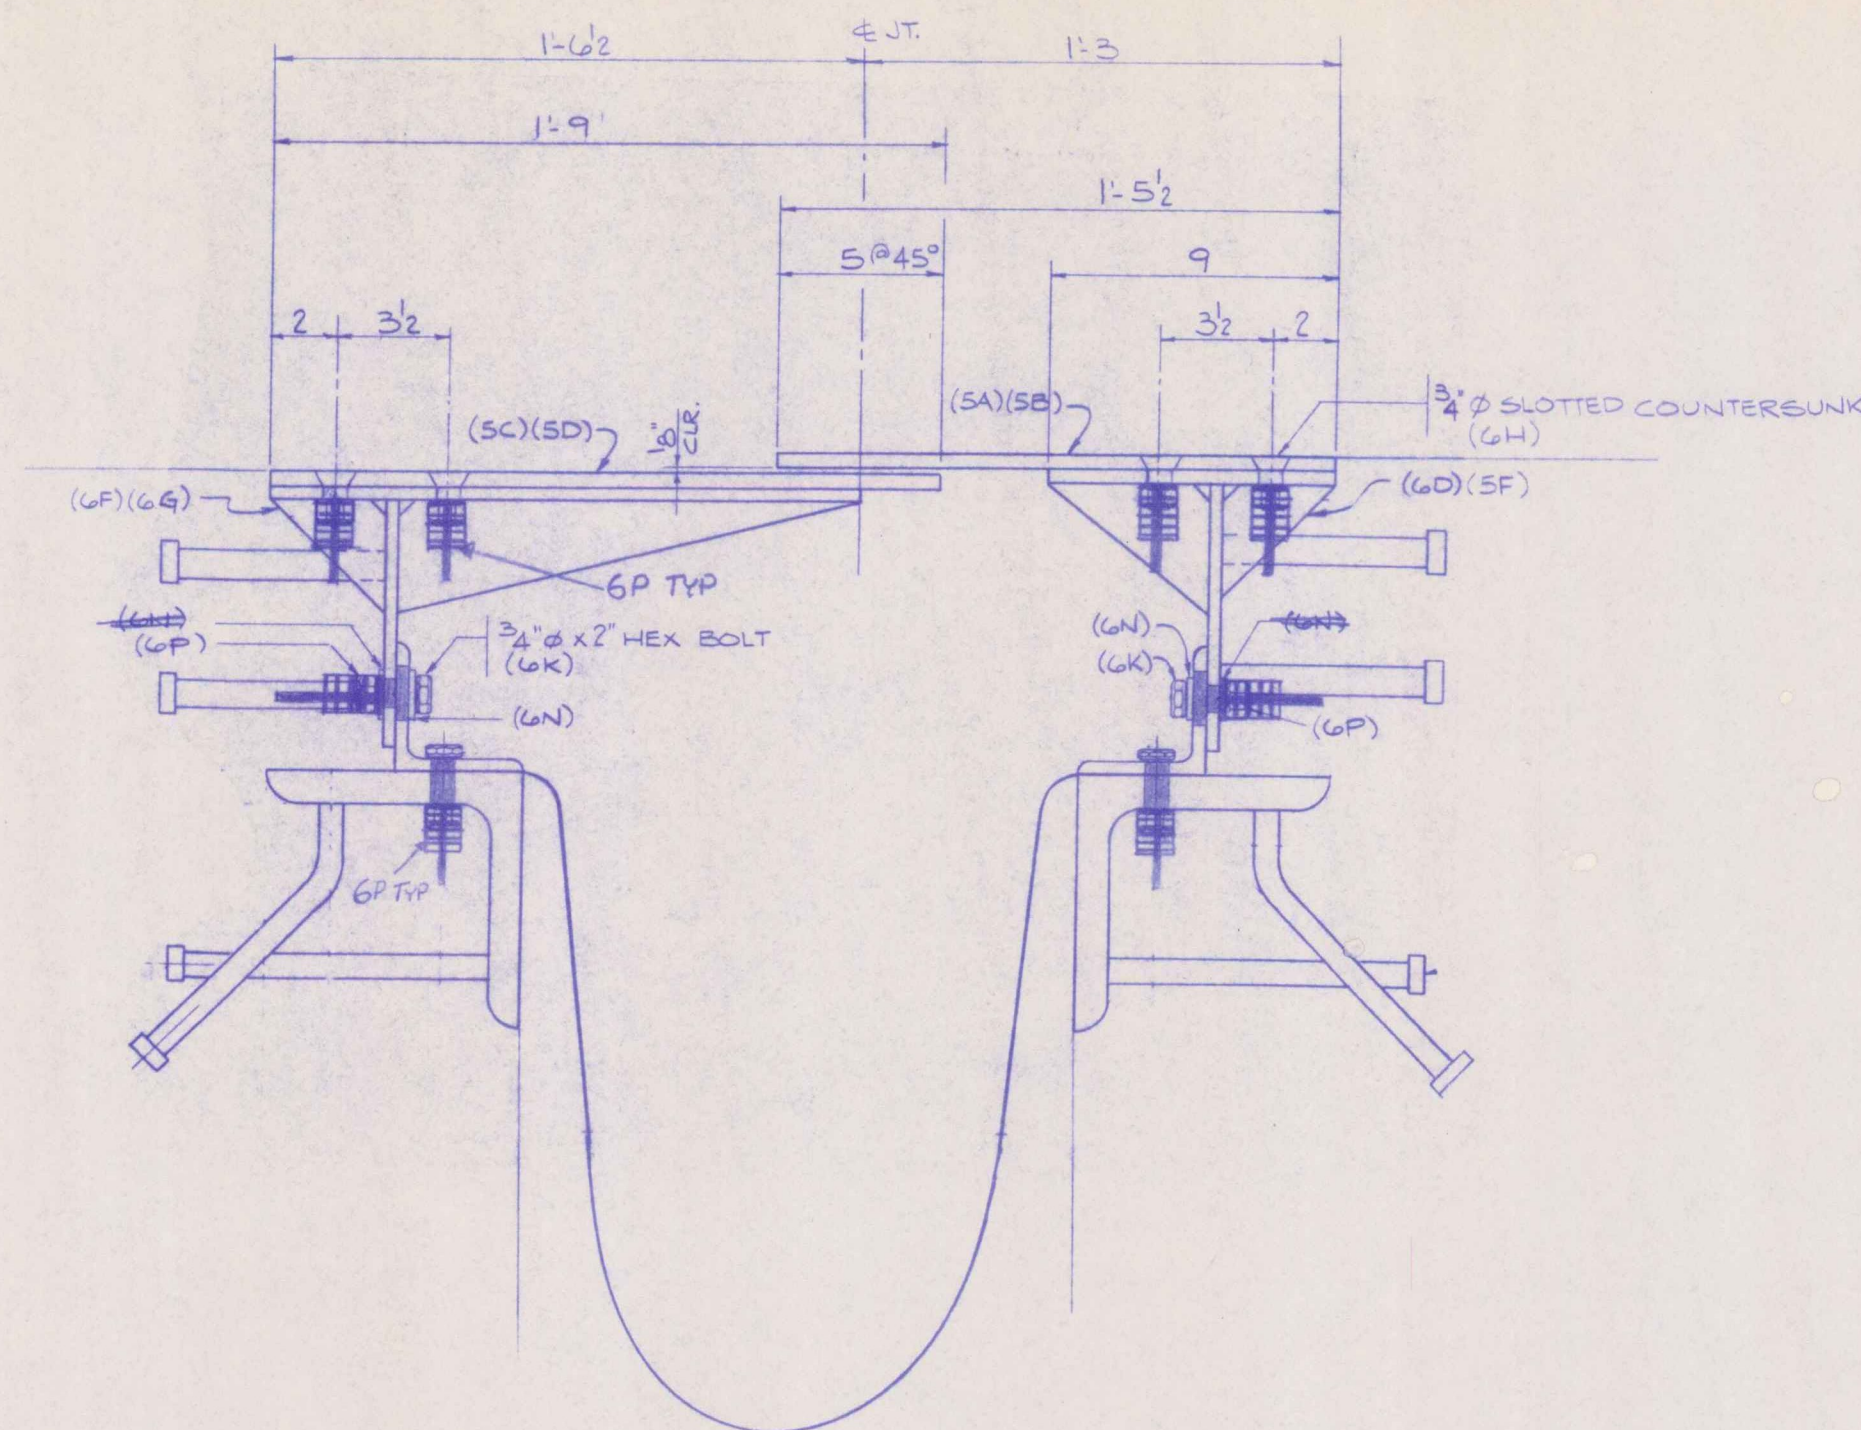

SECTION B-B

☐ No Exception Taken ☐ Make Corrections Taken
☐ Revise and Resubmit ☐ Not Acceptable
Revised only for general conformance with the design of the project and general construction. The contractor is responsible for confirming and correcting all quantities and dimensions and performing the work in a satisfactory manner.
McKINLEY-JOHNSON ENGINEERS, INC.
Date 2/14/77 BY SPK

OUT FOR APPROVAL	1/1
OUT FOR APPROVAL	1/1
ISSUED TO SHOP	
FIELD & OFFICE	
REV. REMARKS	DA
PROJECT NO. ERS-R	
MATERIAL:	EL
HOLES	SH
SURFACE PREP. & PAINT:	
DESCRIPTION: FINGER	
JOB: STATE OF VT	
BRIDGE NO.	
U.S. ROUTE	
TOWN OF SH	
CUSTOMER: WINTER	
BRIDGE &	
5 INDUSTRY ROAD	
PHONE (207) 874-	