



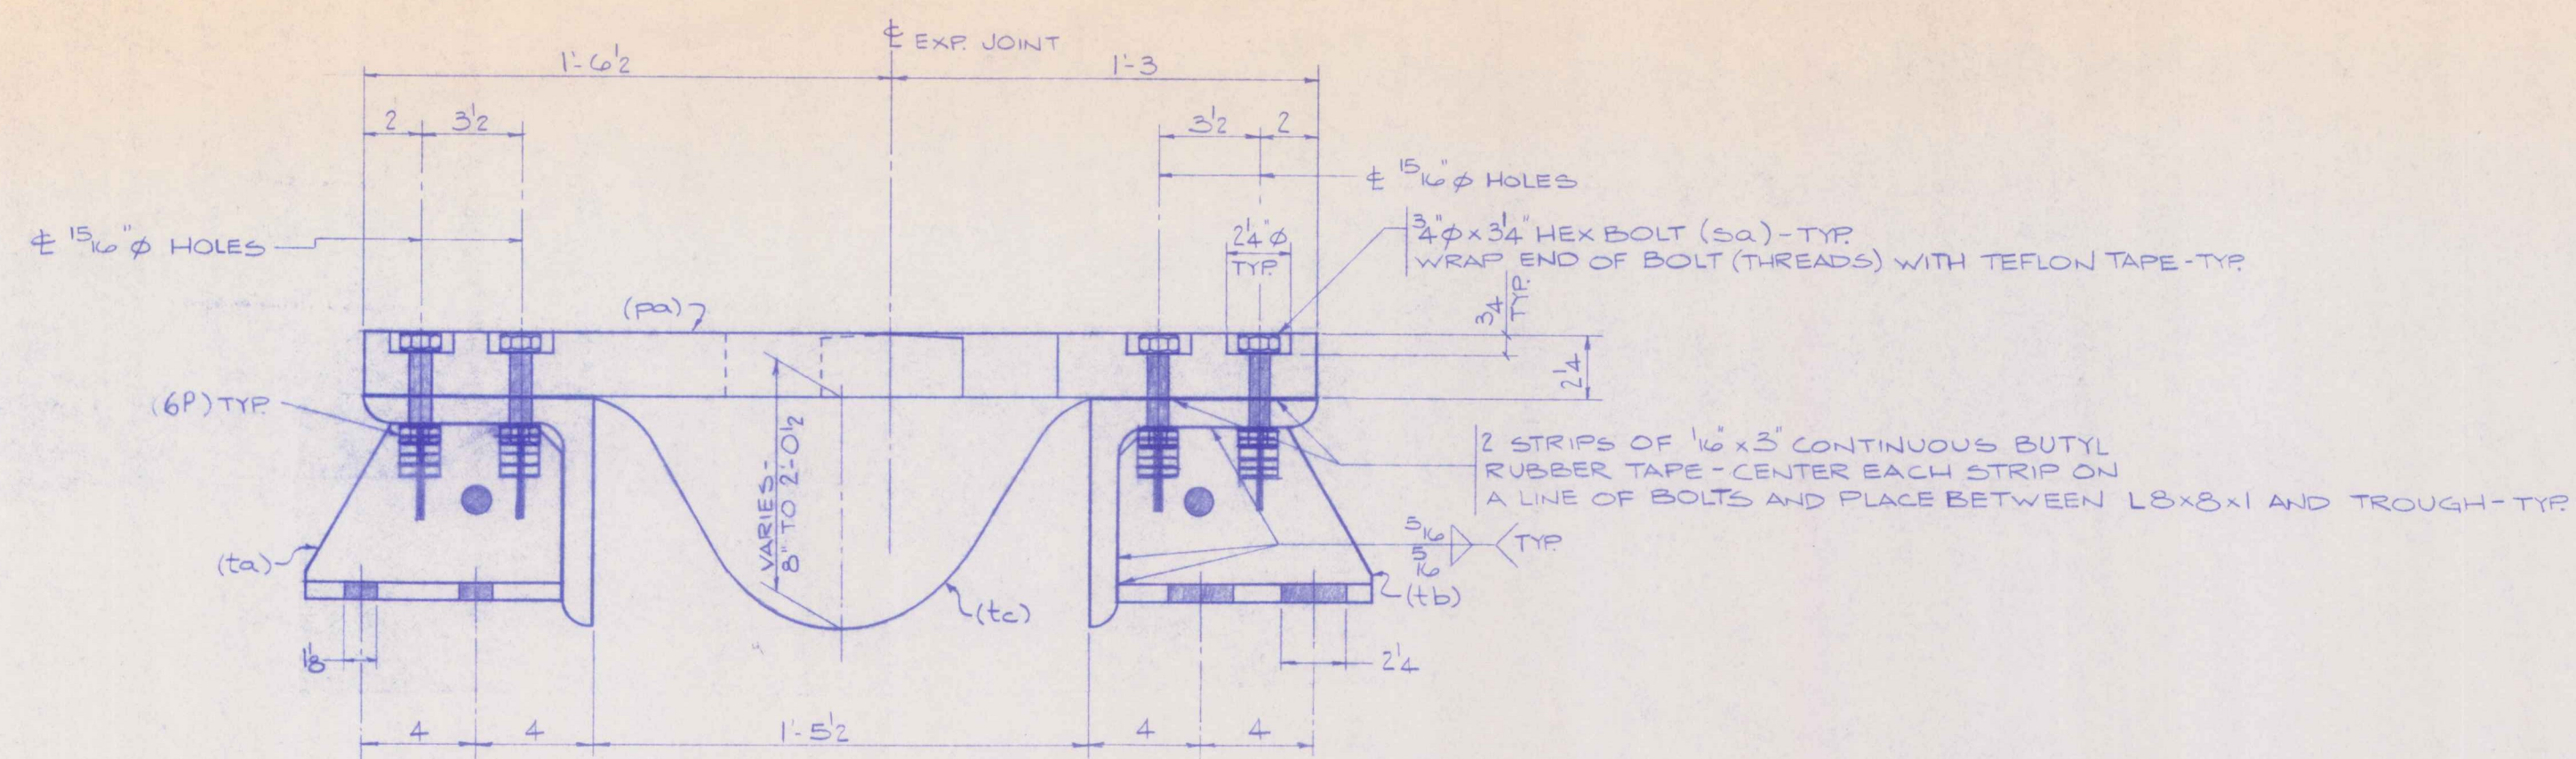


SECTION C-C

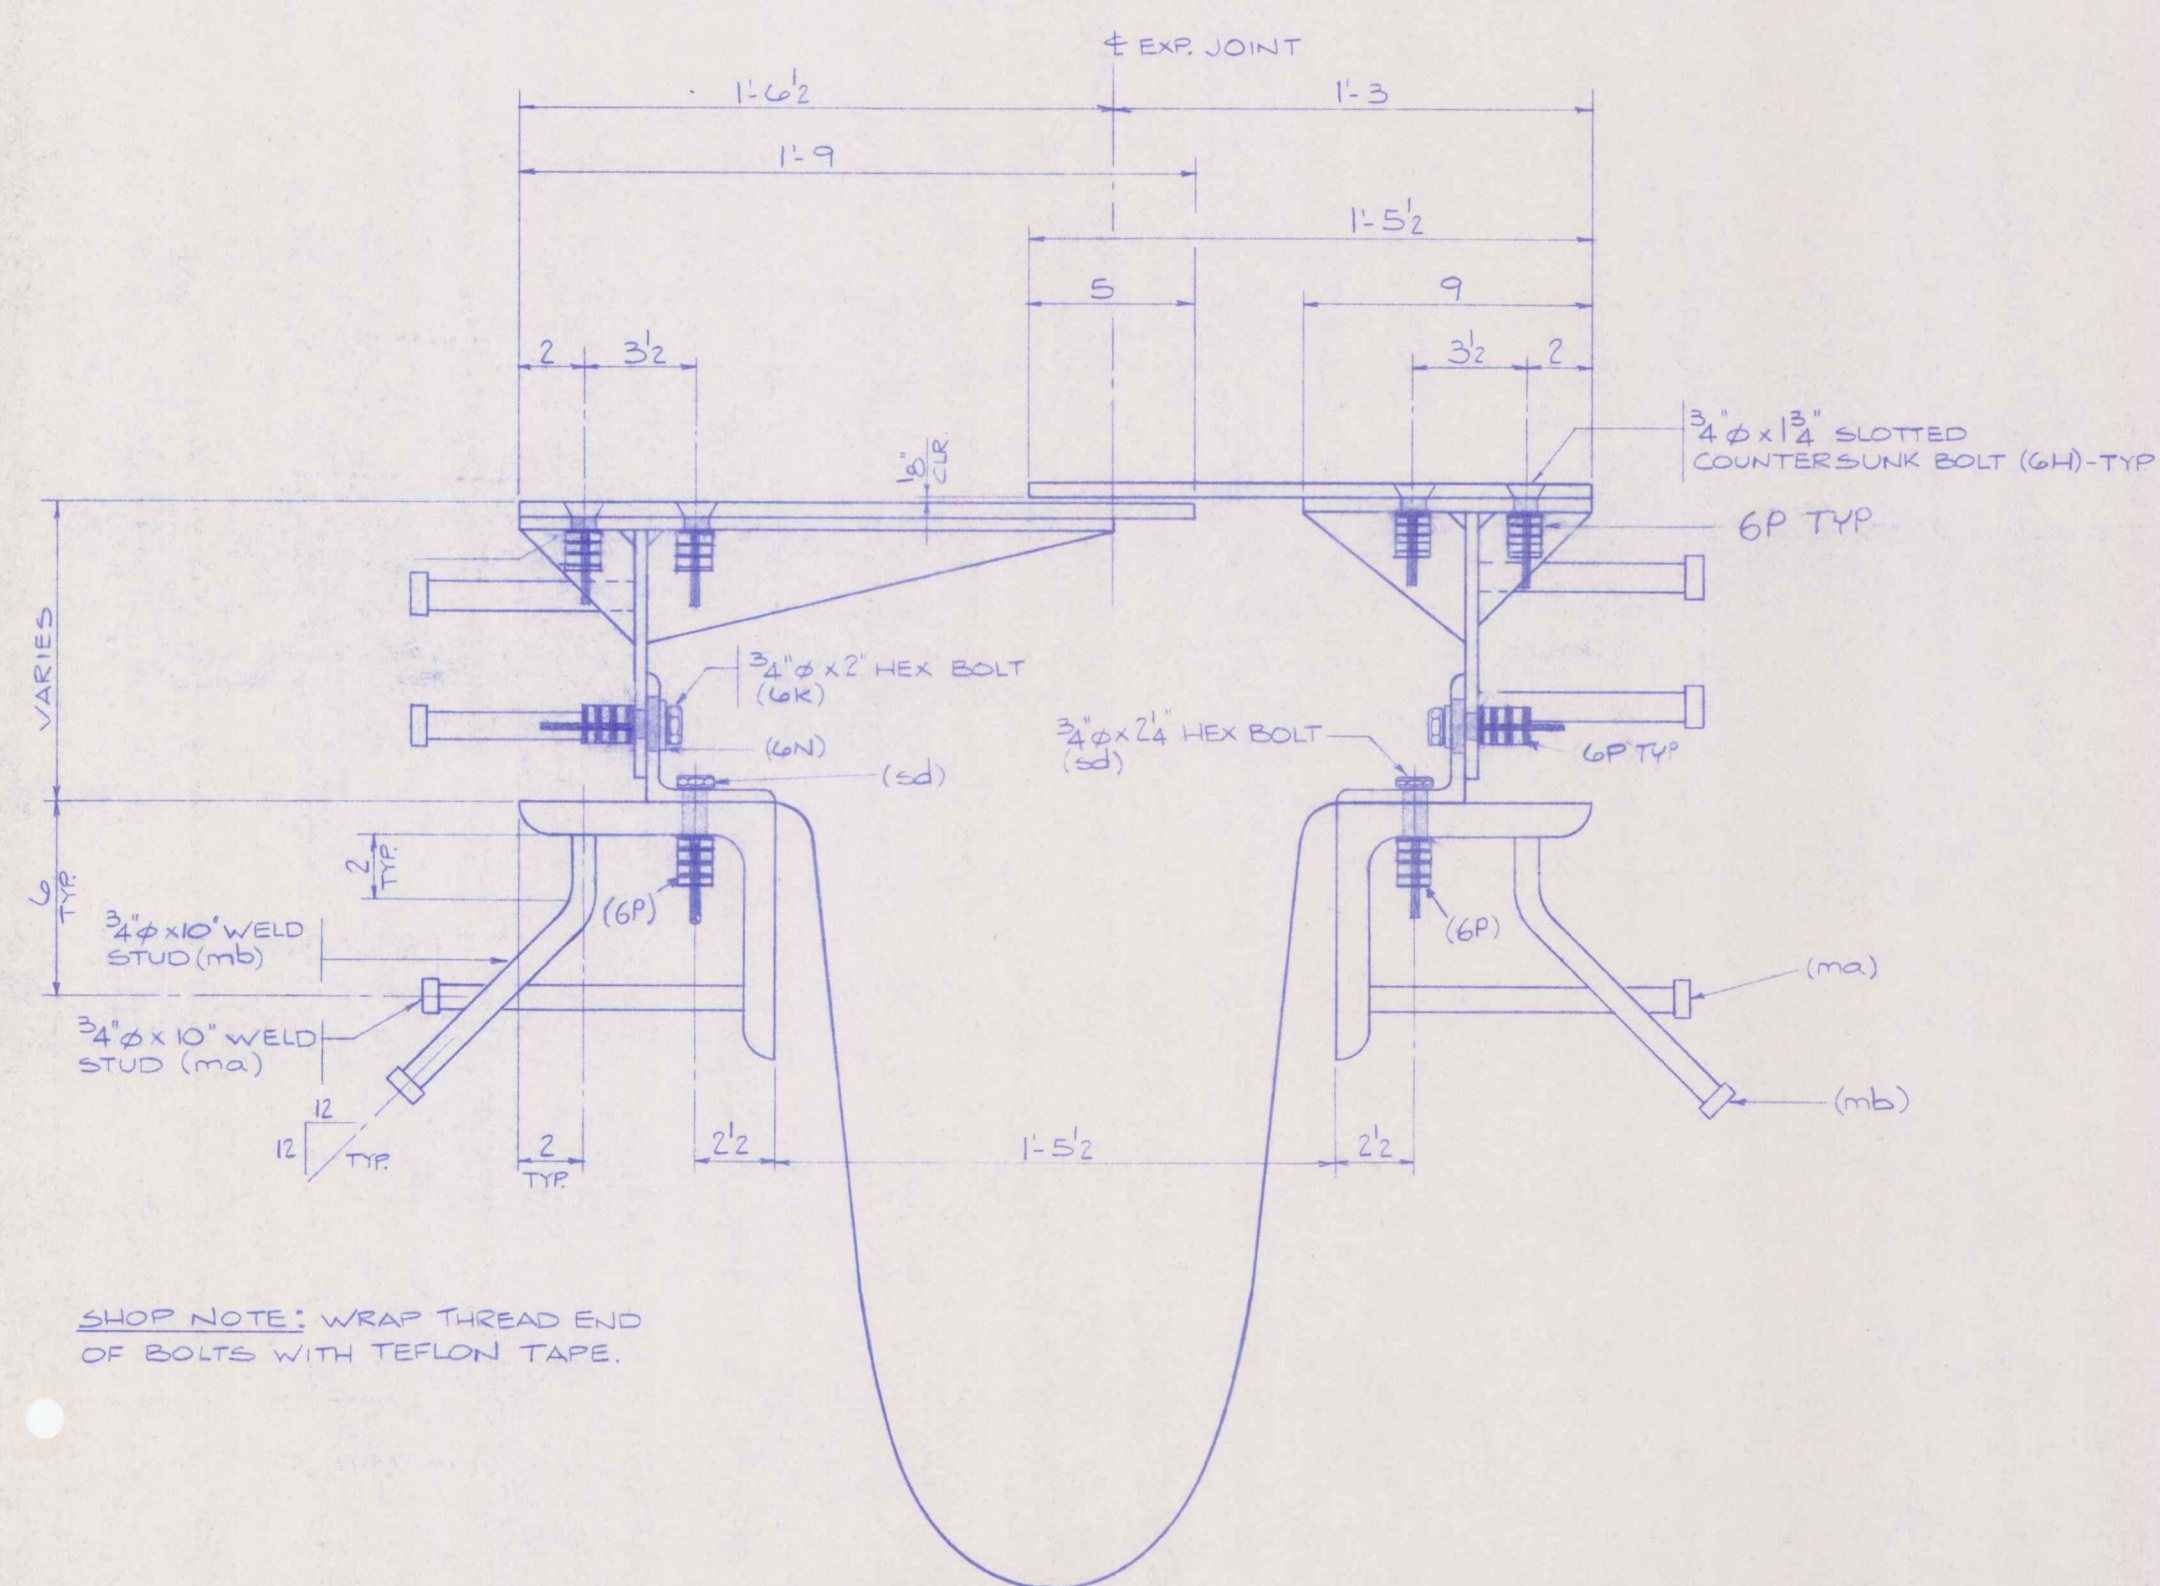

SECTION D-D

SHOP NOTE: ATTACH CURB ASSEMBY TO ENSURE PROPER FIT;
REMOVE CURB ASSEMBY FOR SHIPPING.

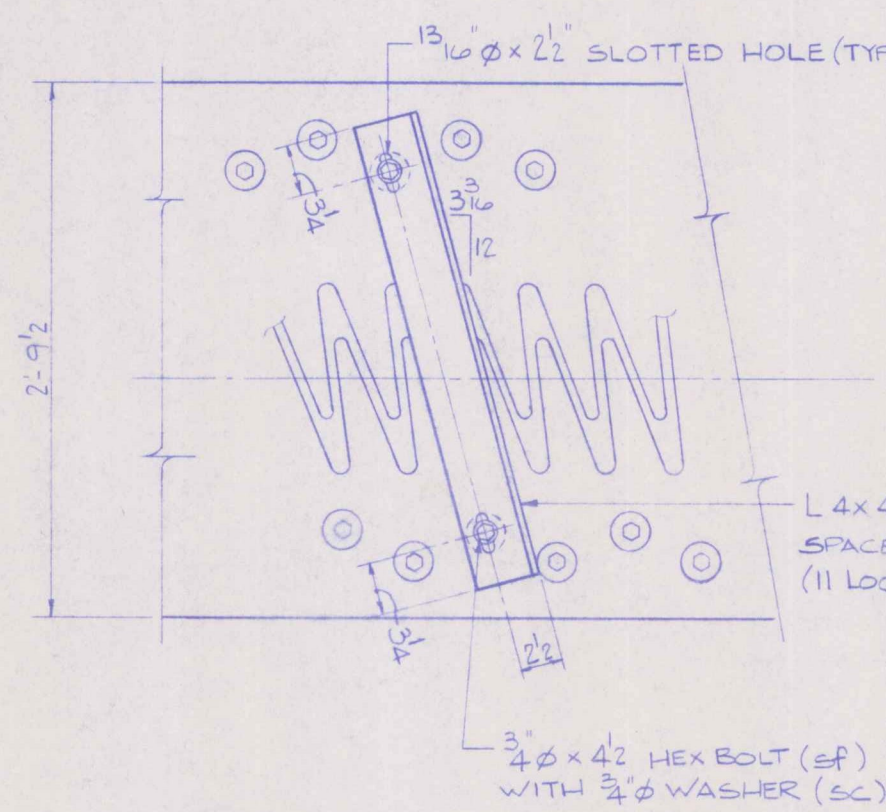

SHIPPING ANGLE DETAIL

☒ No Exception Taken ☐ Make Change
☐ None and Rejected ☐ Not Allowed
 Reviewed only for general conformance of
 design of the project and general control
 factor is responsible for controlling and
 satisfactory manner.
 MCKINLEY-JOHNSON ENGINEERS
 Date 2/14/77 BY SPB

WORK THIS