




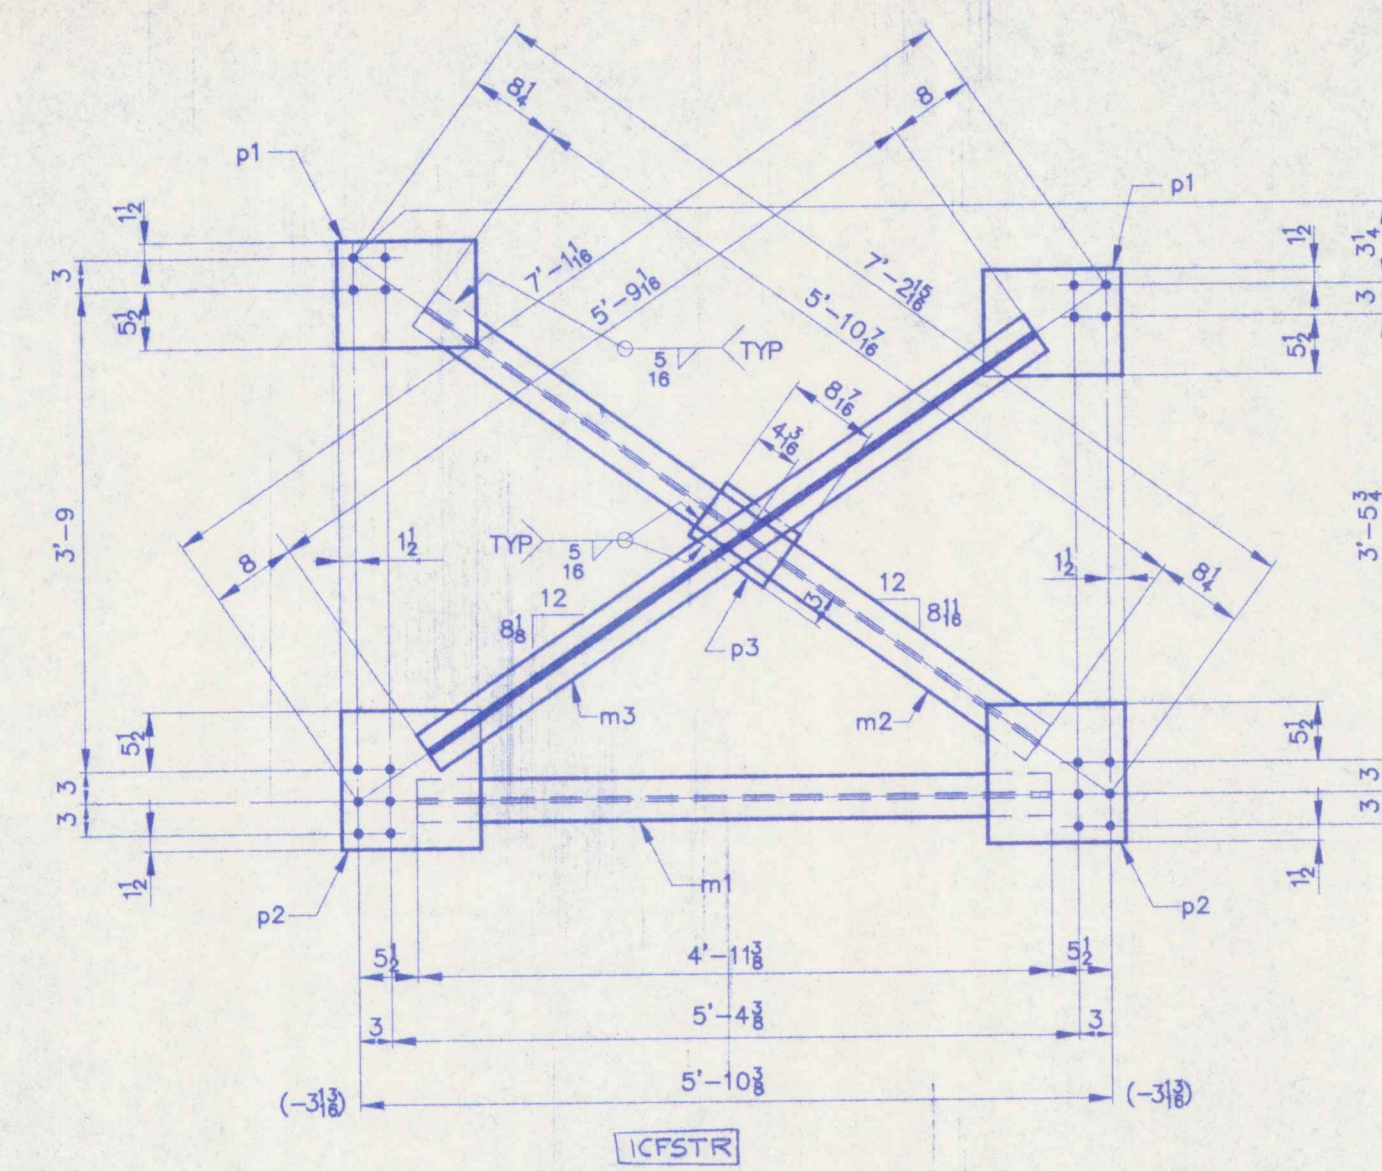


12 ~ CROSS FRAMES ~ F1

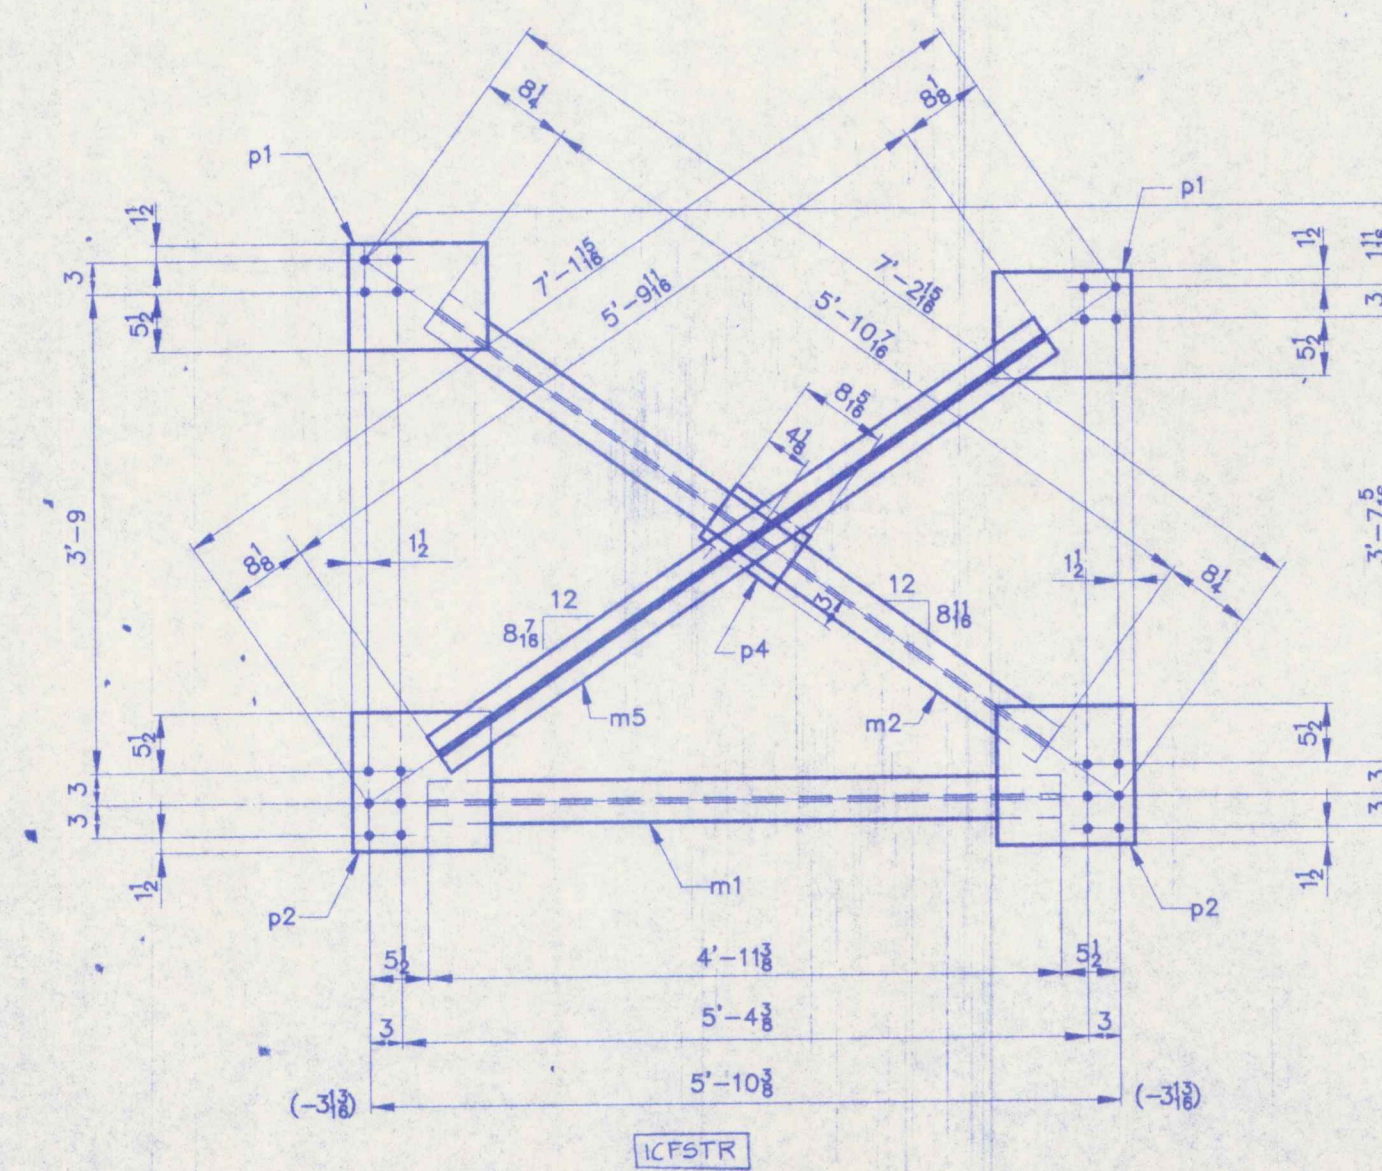

36 ~ CROSS FRAMES ~ F3

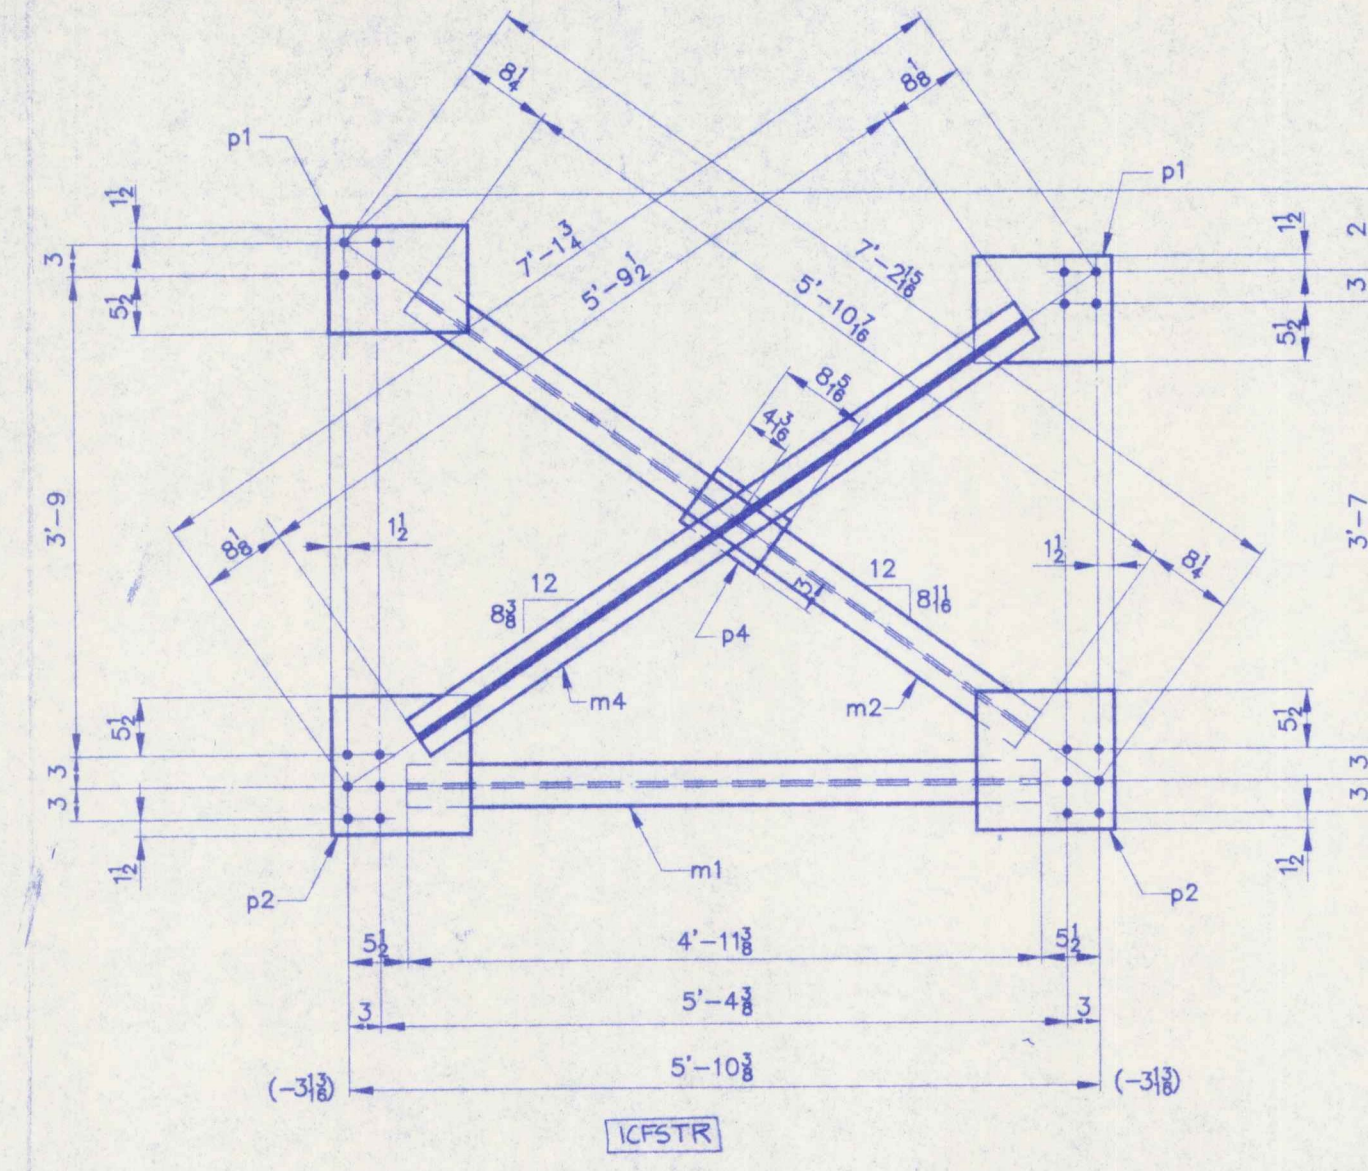

12 ~ CROSS FRAMES ~ F2

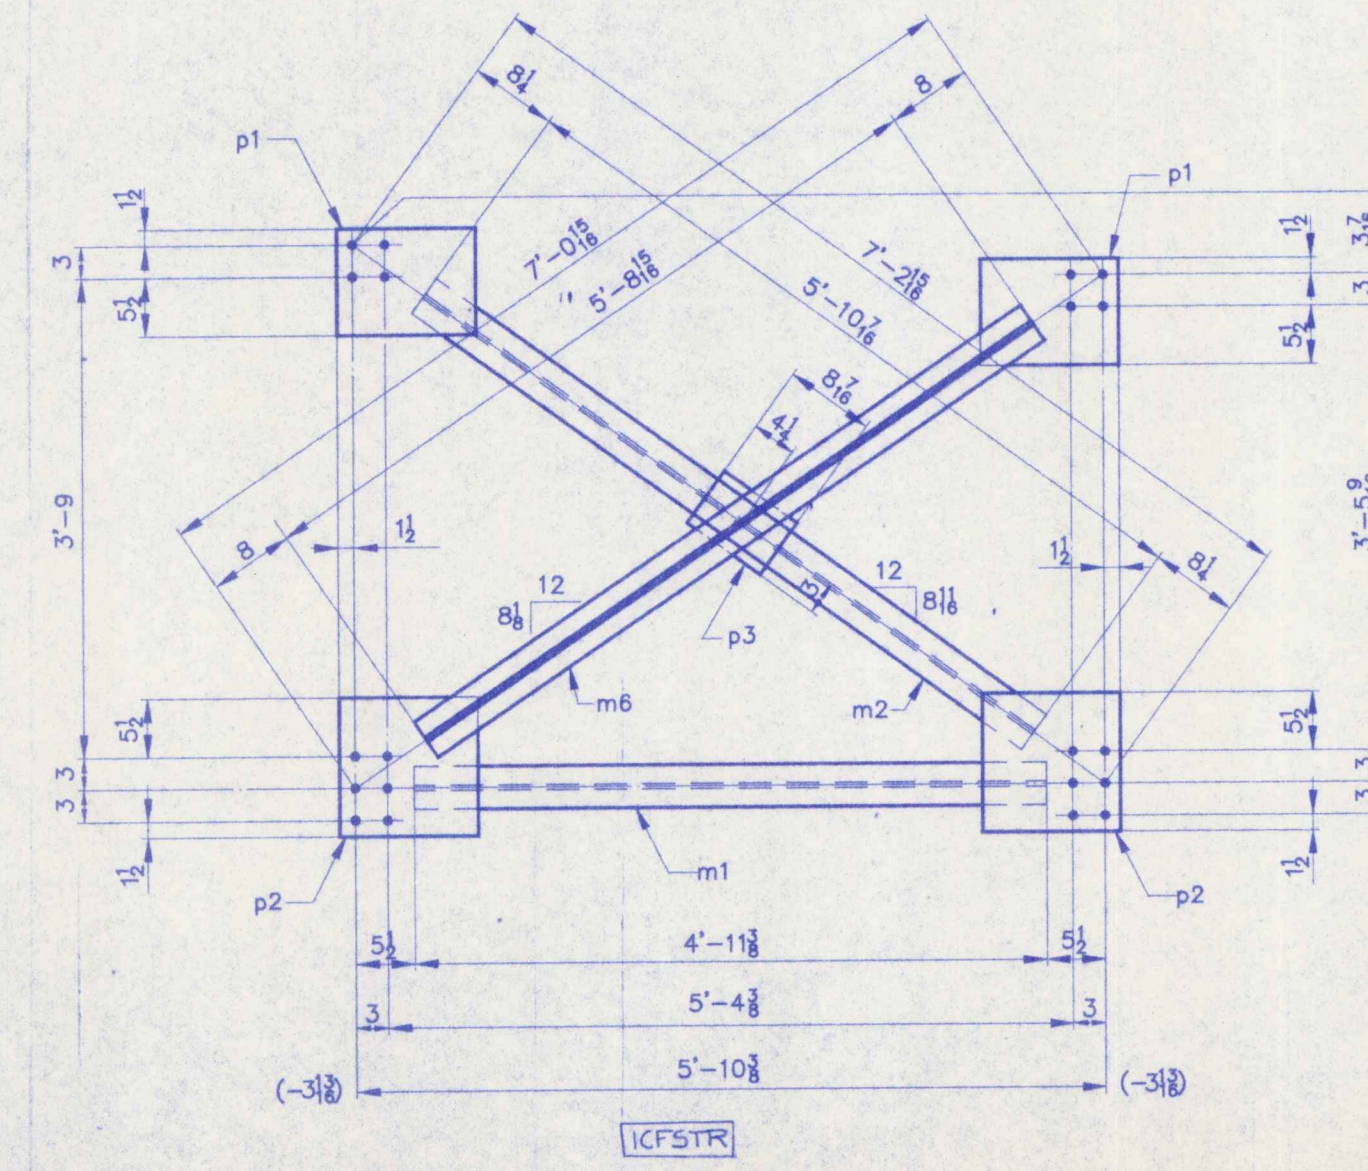

12 ~ CROSS FRAMES ~ F4