



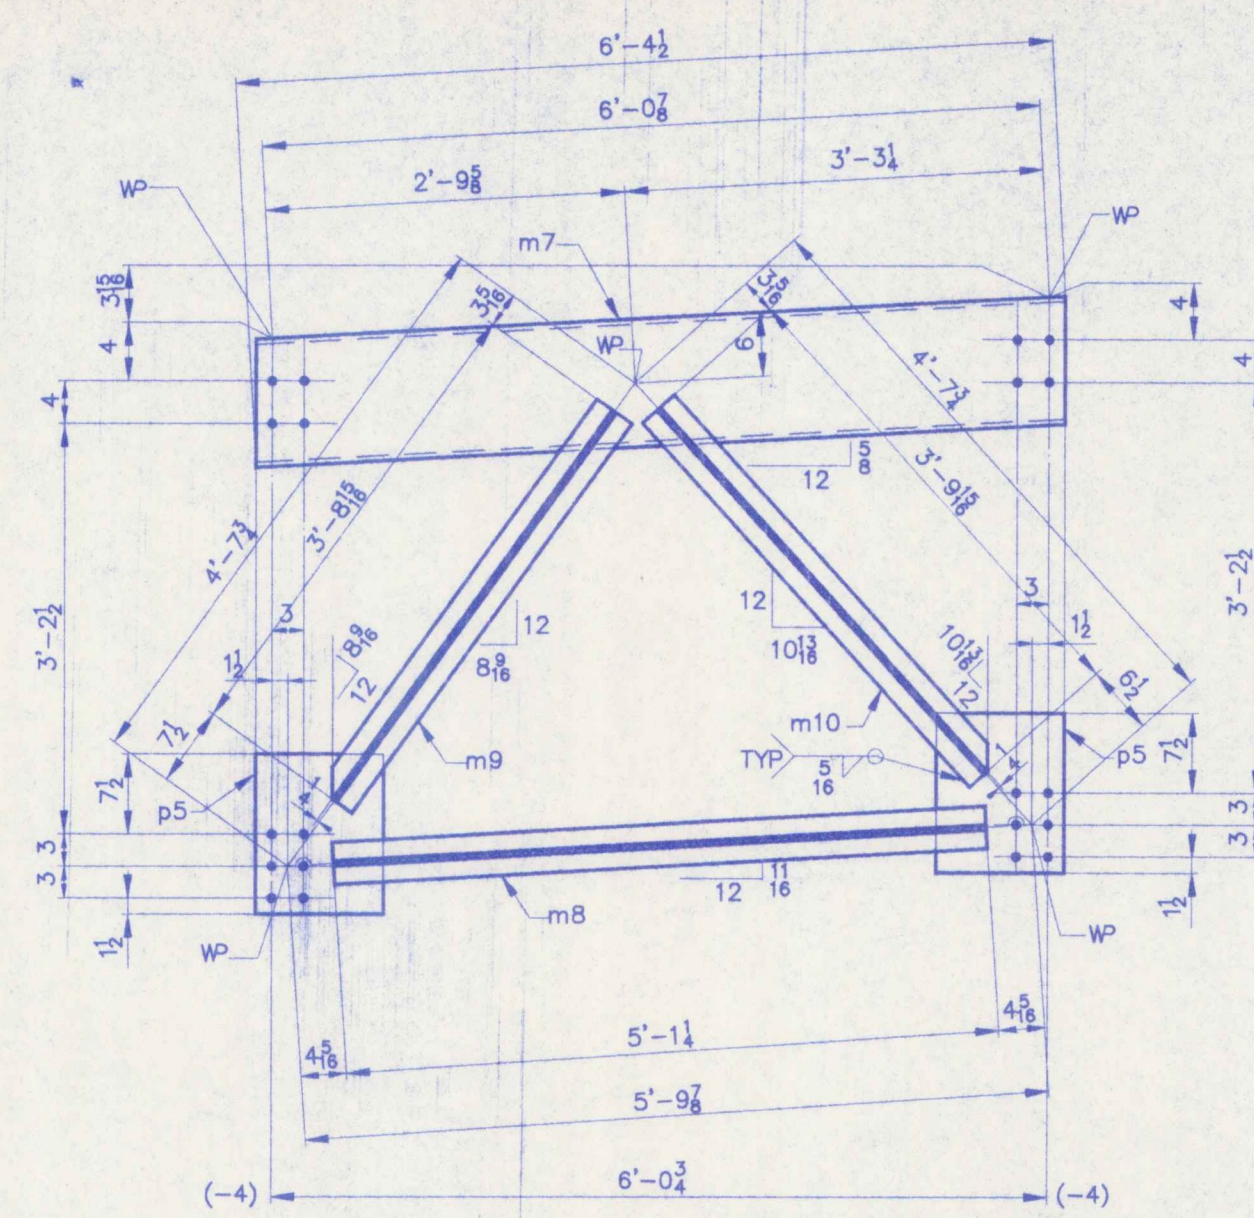


ONE ~ CROSS FRAME ~ F5

ECFSTR

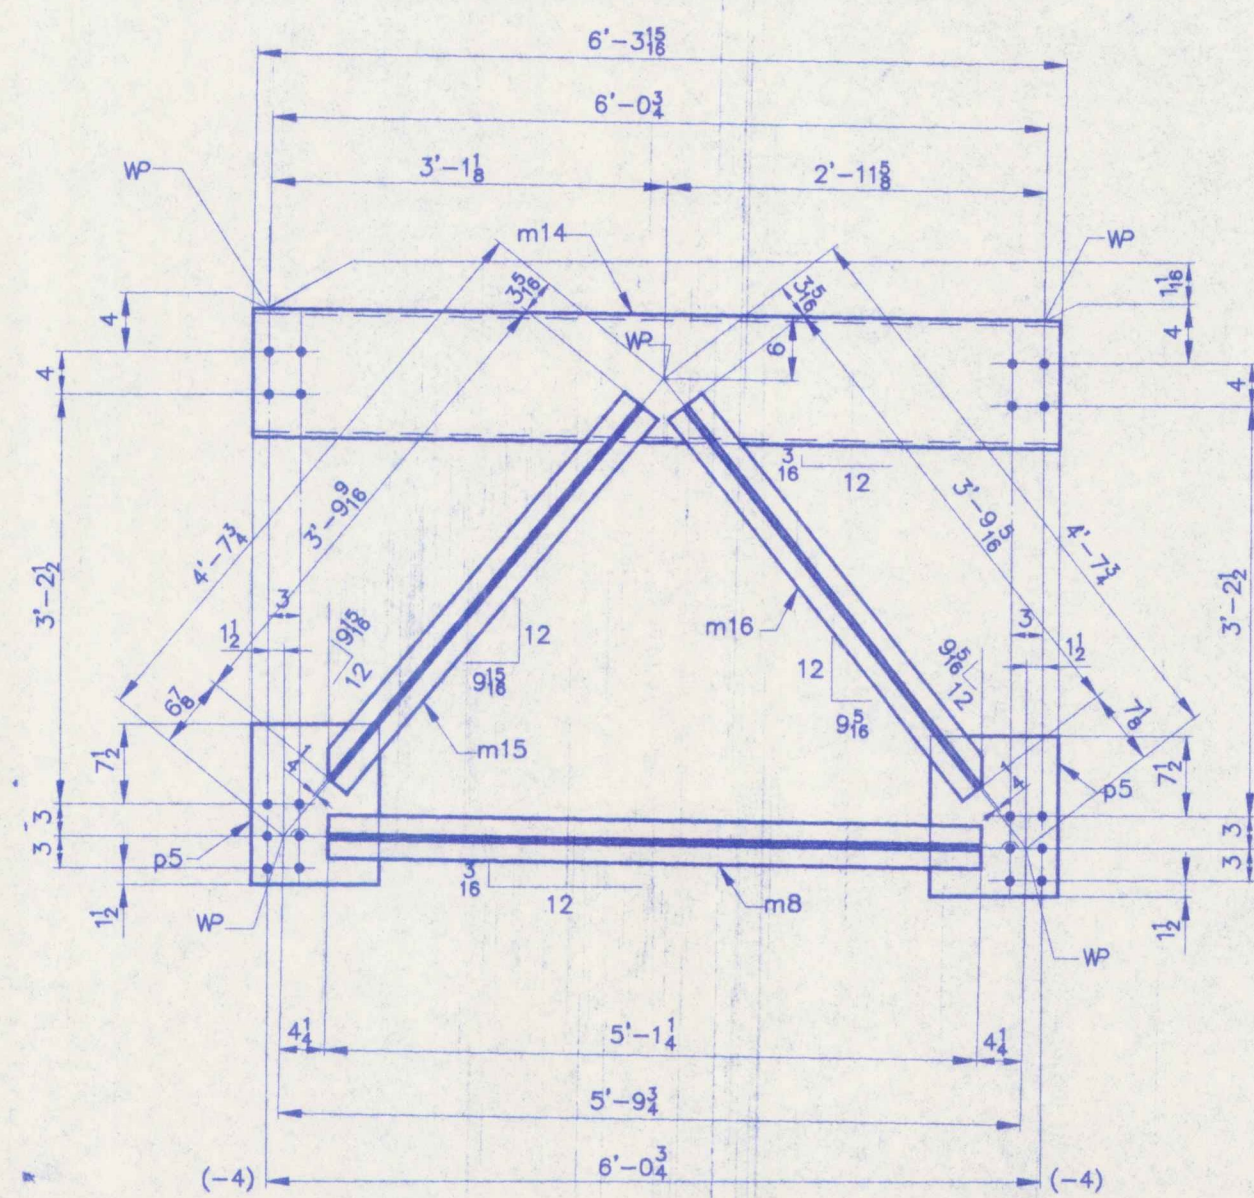

2 ~ CROSS FRAMES ~ F9

ECFSTR

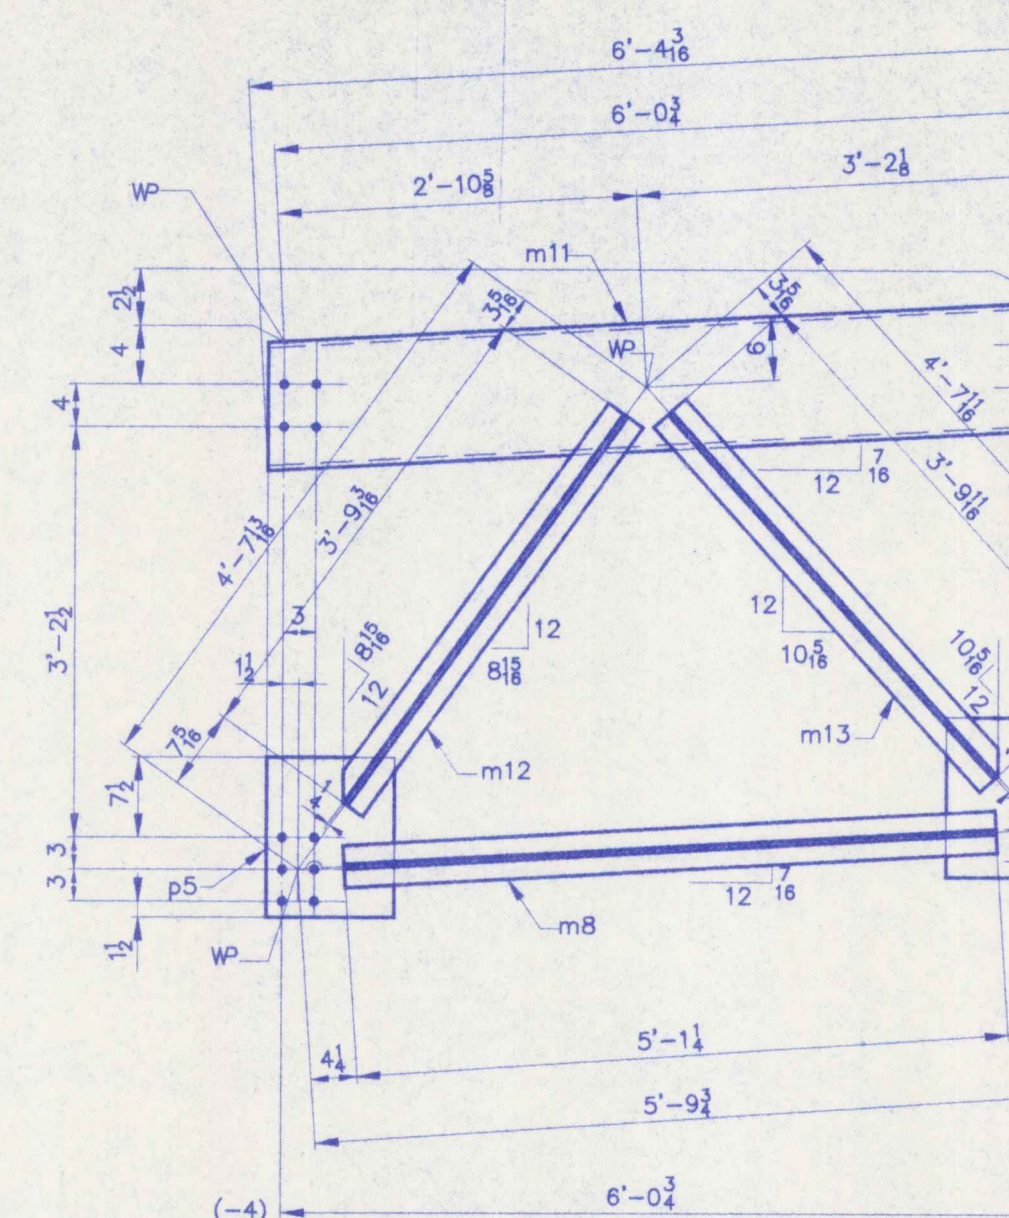

3 ~ CROSS FRAMES ~ F7

ECFSTR