


U.S. ROUTE 2
CABOT-DANVILLE
F028 - 3(26)

SECTION 1

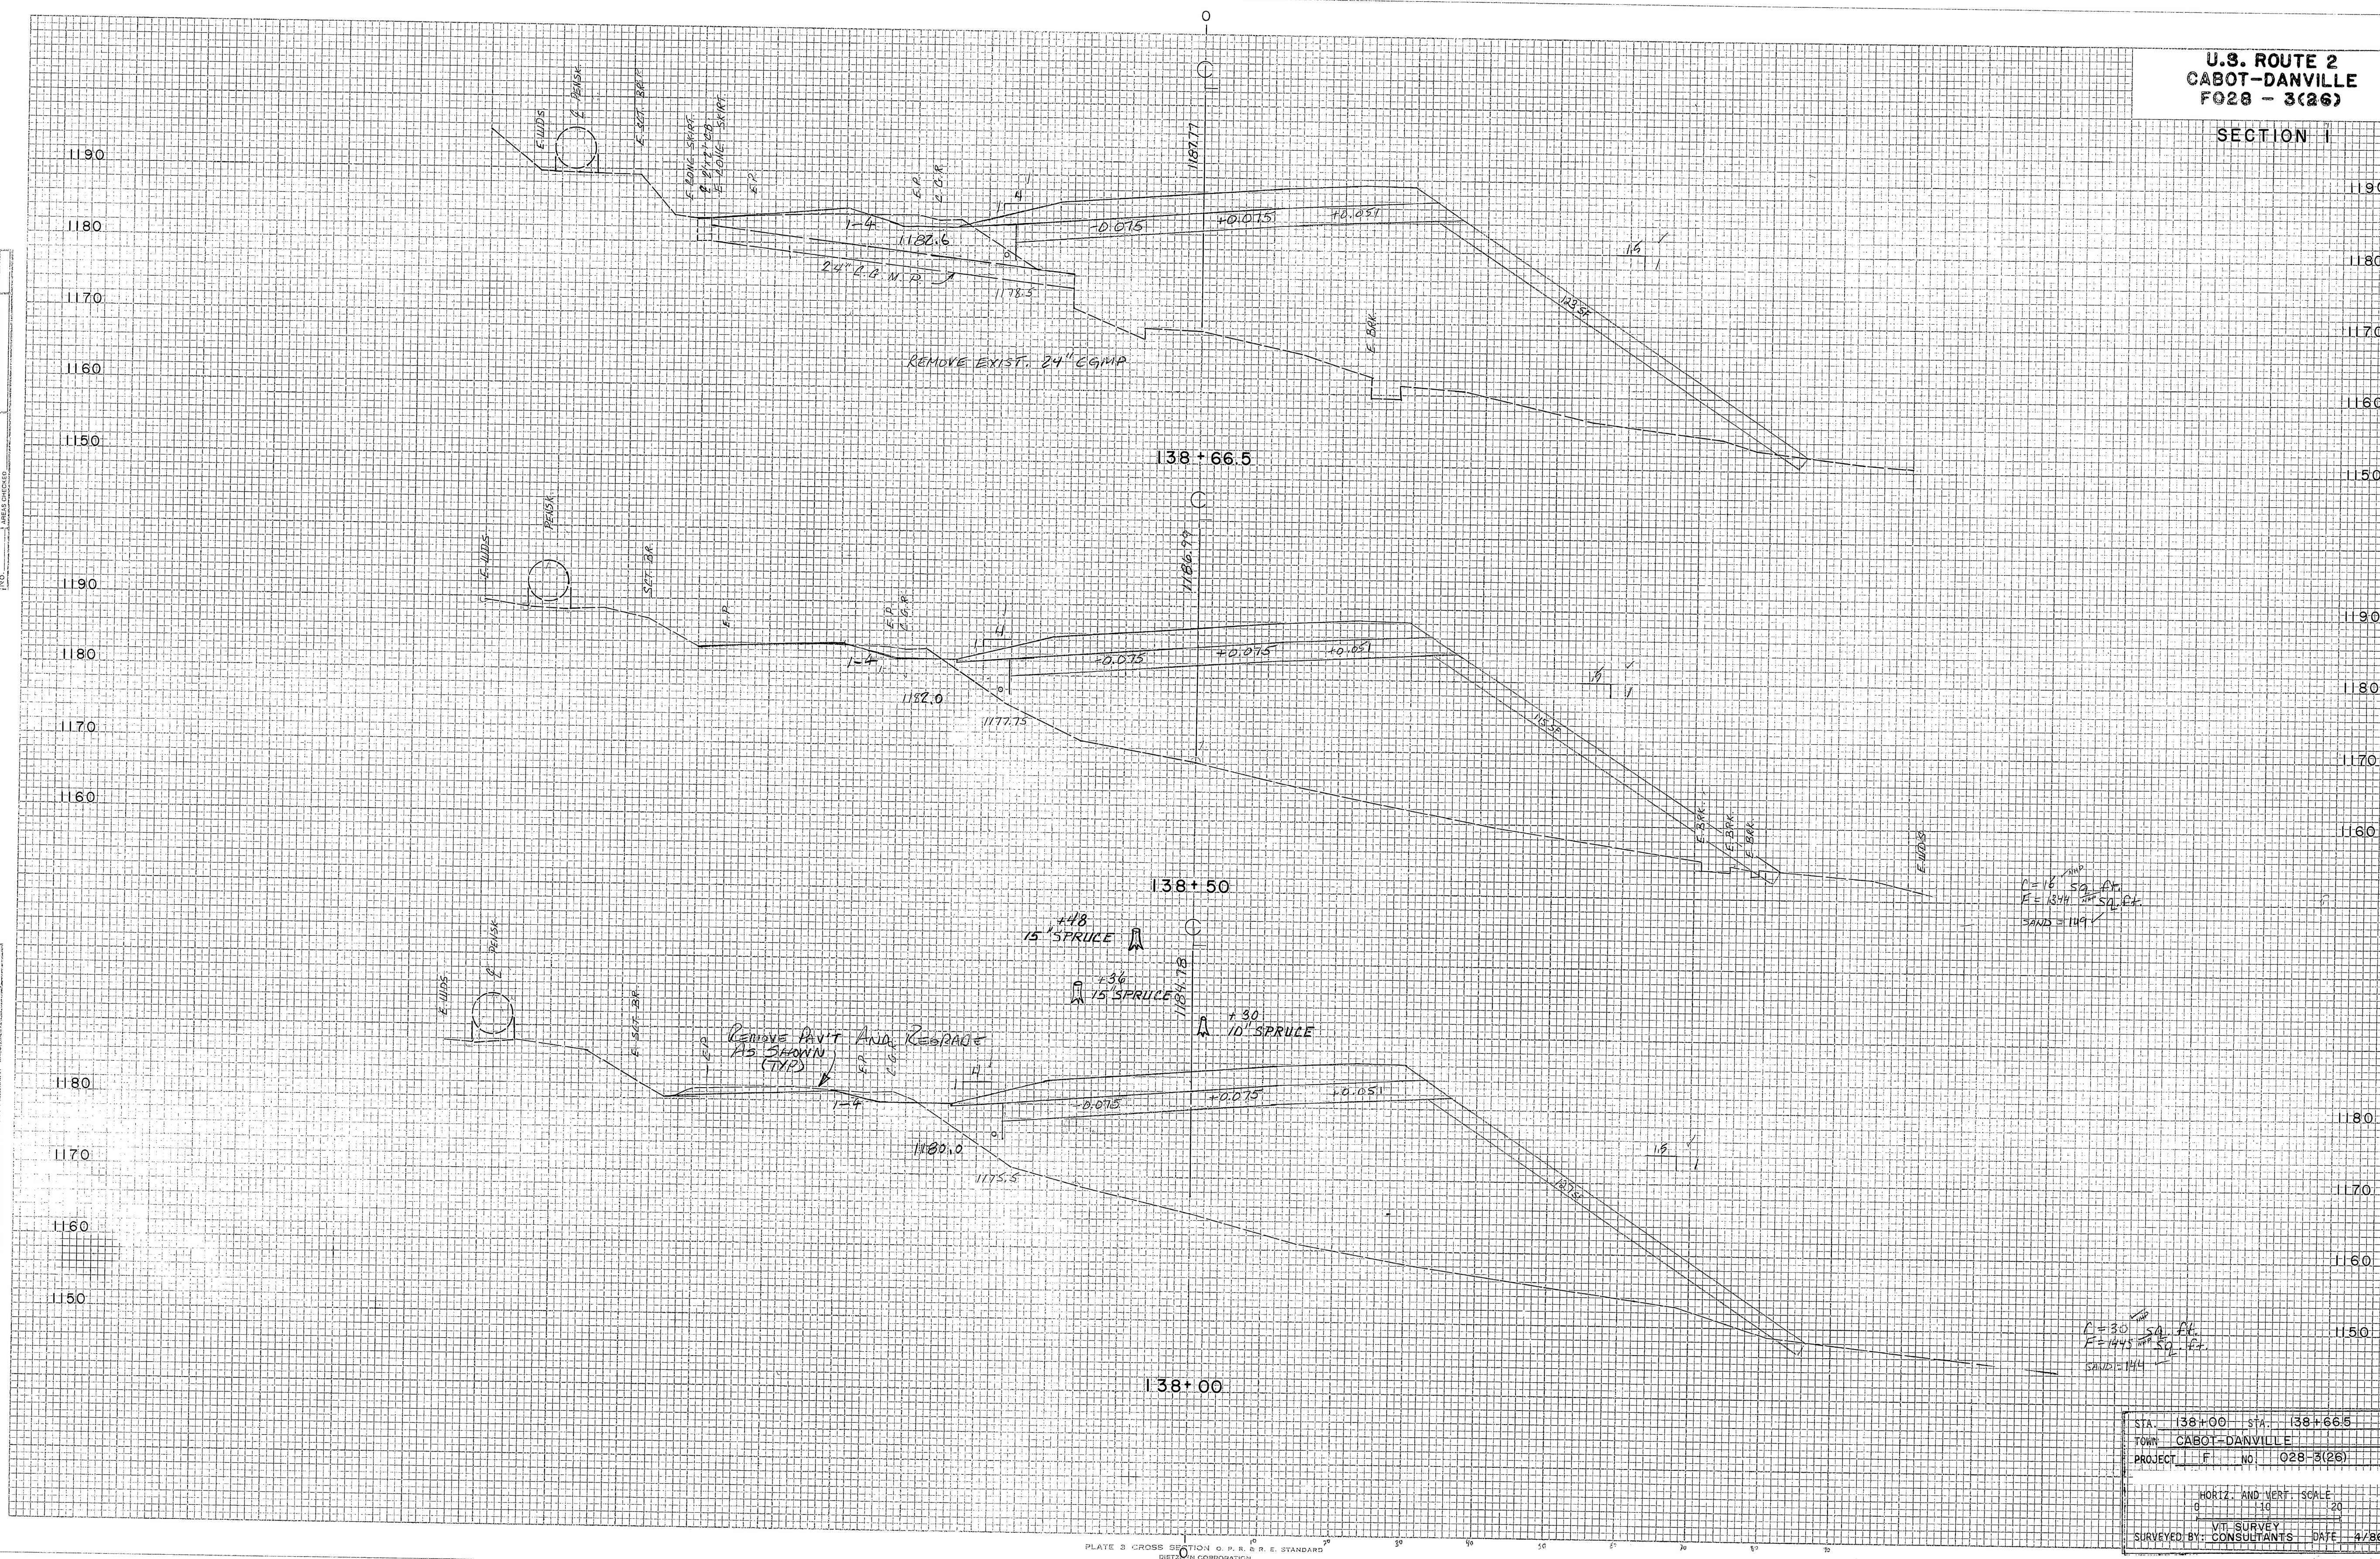

C=16 SA. AL.
E=1344 SQ. FT.
LAND=1194

C=30 SA. AL.
E=1445 SQ. FT.
LAND=1194

STA.	138+00	STA.	138+66.5
TOWN	CABOT-DANVILLE		
PROJECT	F	NO.	028-3(26)
HORIZ. AND VERT. SCALE			
1" = 10'			
VIT SURVEY			
SURVEYED BY: CONSULTANTS DATE: 4/86			

PROJECT NAME: CABOT-DANVILLE
PROJECT NUMBER: FECC F 028-3(26) C/1
FILE NAME: 78d058xs.dgn
PROJECT LEADER: K. ROBBE
DESIGNED BY: I. SHEA
MAINLINE CROSS SECTIONS 29
PLOT DATE: 06-
DRAWN BY: I. S.
CHECKED BY: S. M.
SHEET 161 OF