


U.S. ROUTE 2
CABOT-DANVILLE
FO28 - 3(26)

SECTION 1

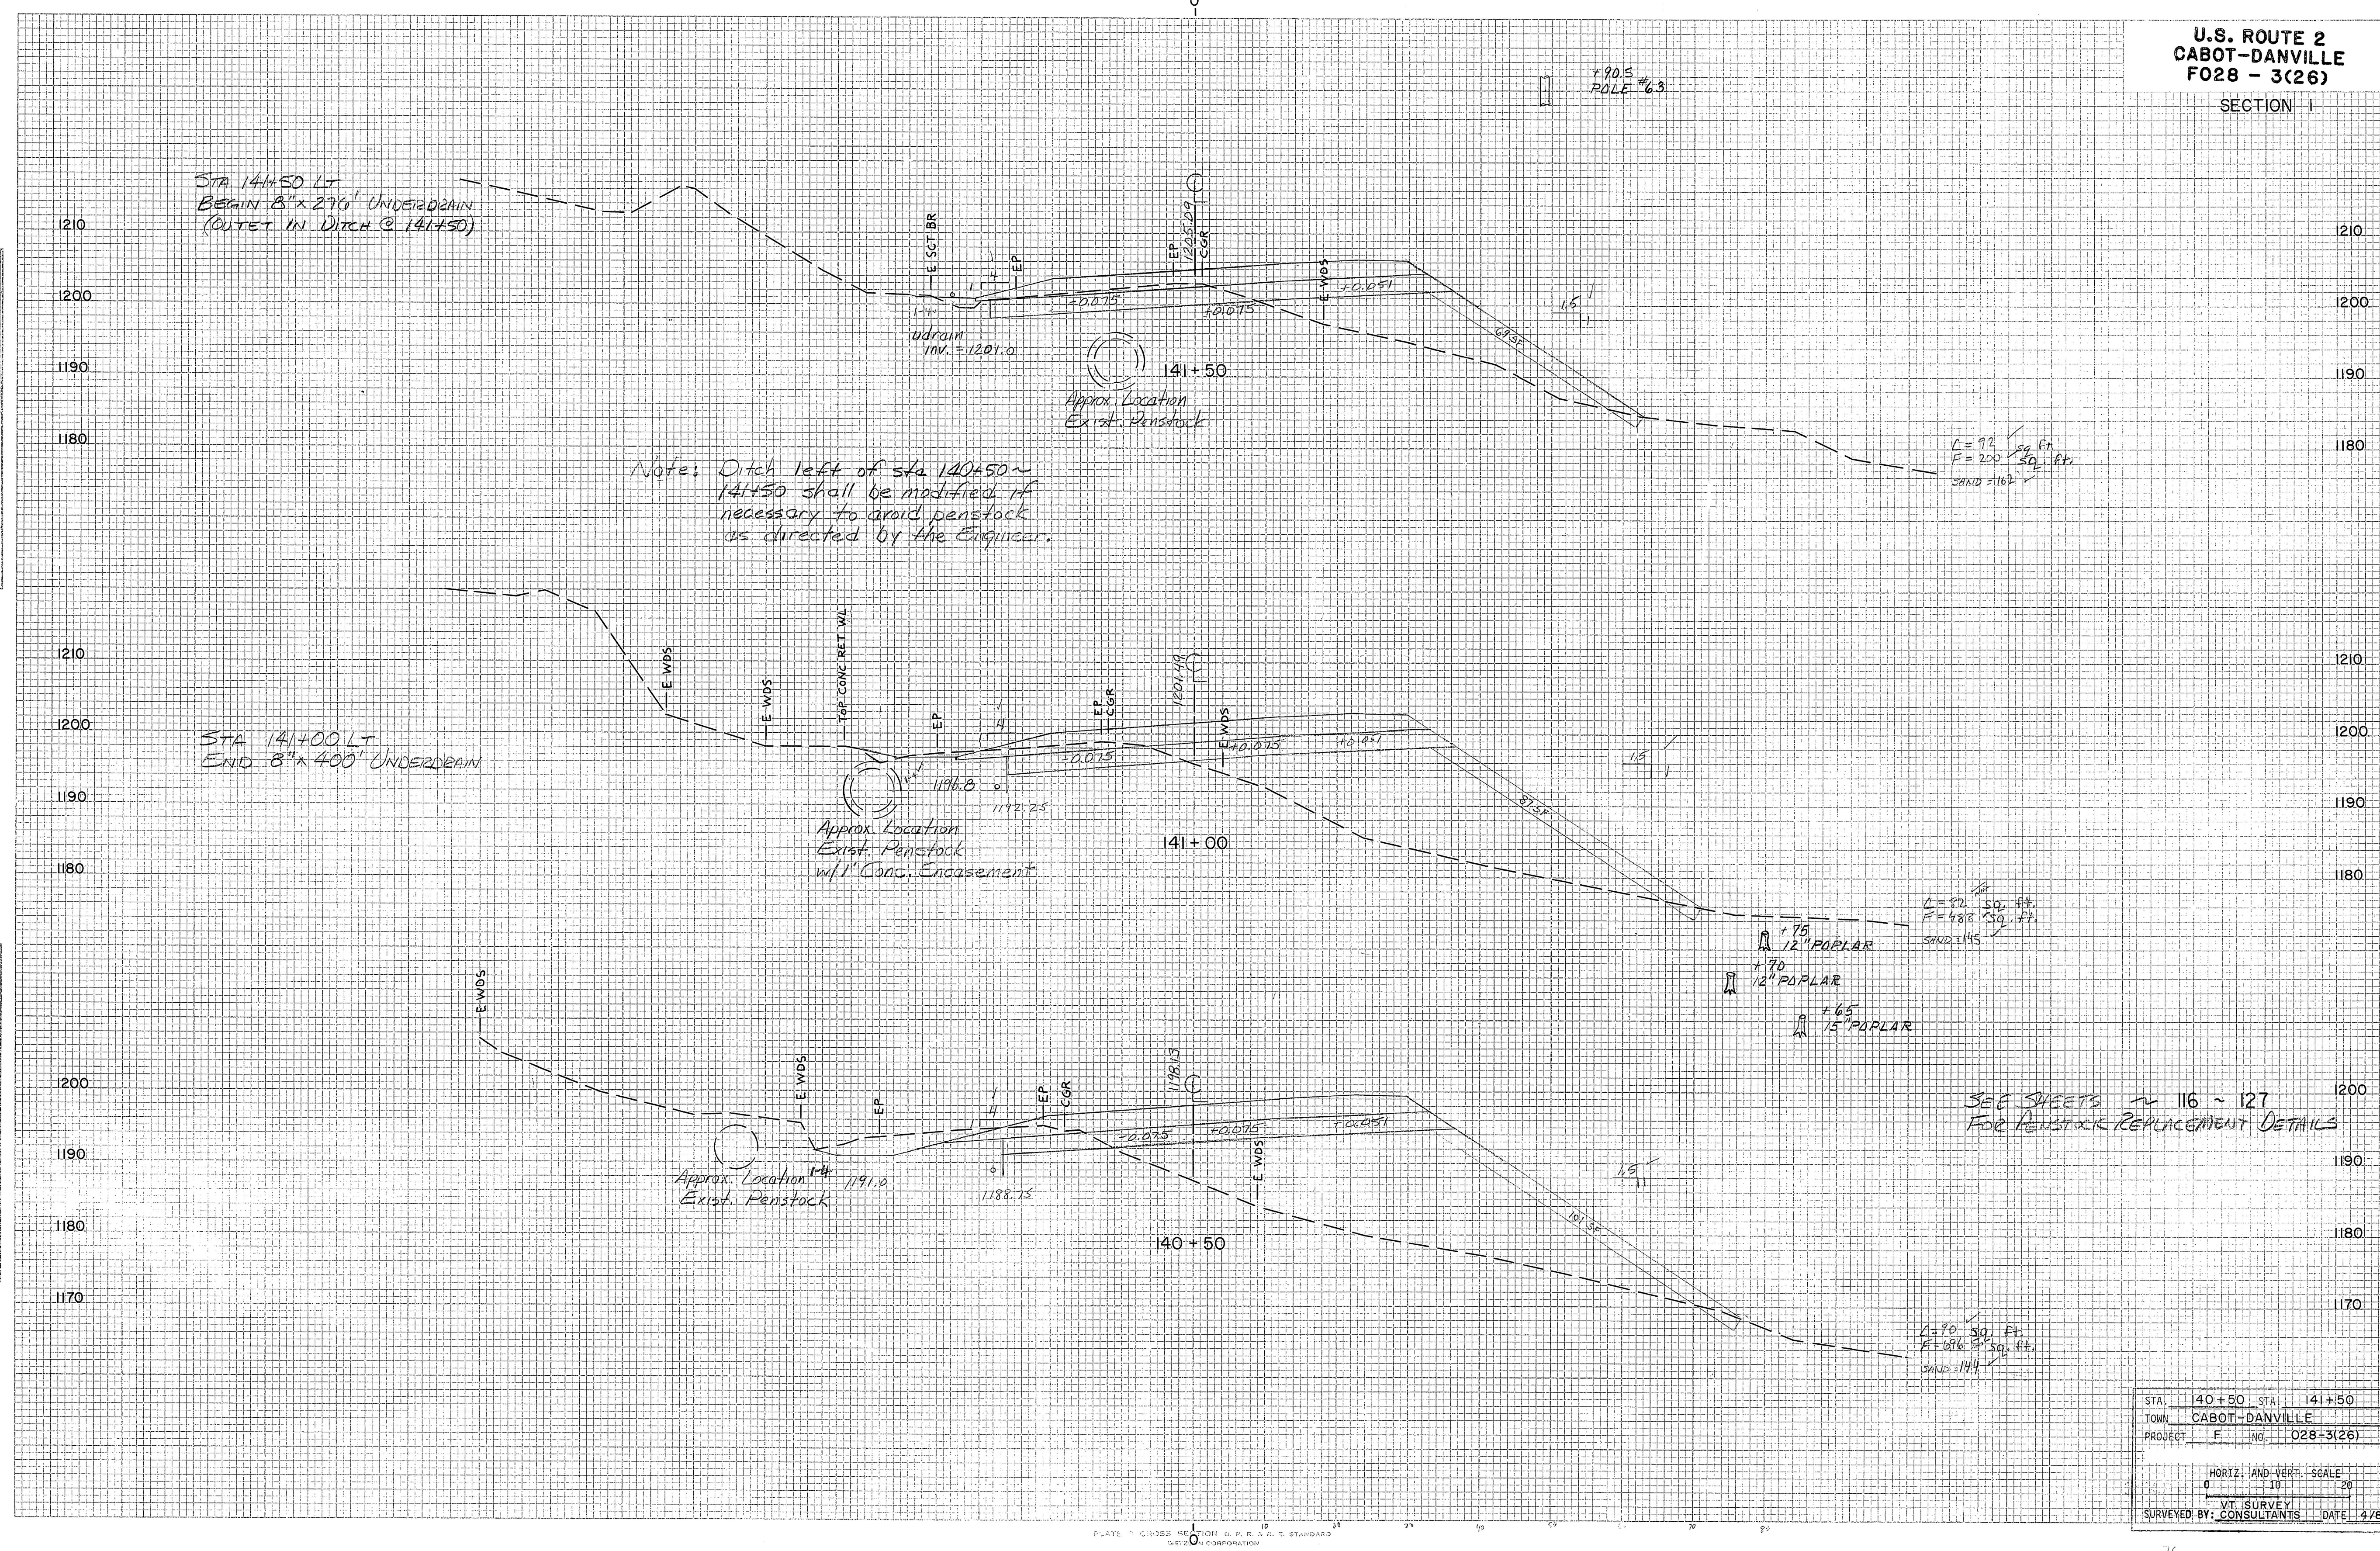

PROJECT NAME: CABOT-DANVILLE
PROJECT NUMBER: FECC F 028-3(26) C/1
FILE NAME: 78d058xs.dgn
PROJECT LEADER: K. ROBBIE
DESIGNED BY: I. SHEA
MAINLINE CROSS SECTIONS 31
PLOT DATE: 06-OCT-2010
DRAWN BY: I. SHEA
CHECKED BY: S. MENARD
SHEET 163 OF 250