

SECTION

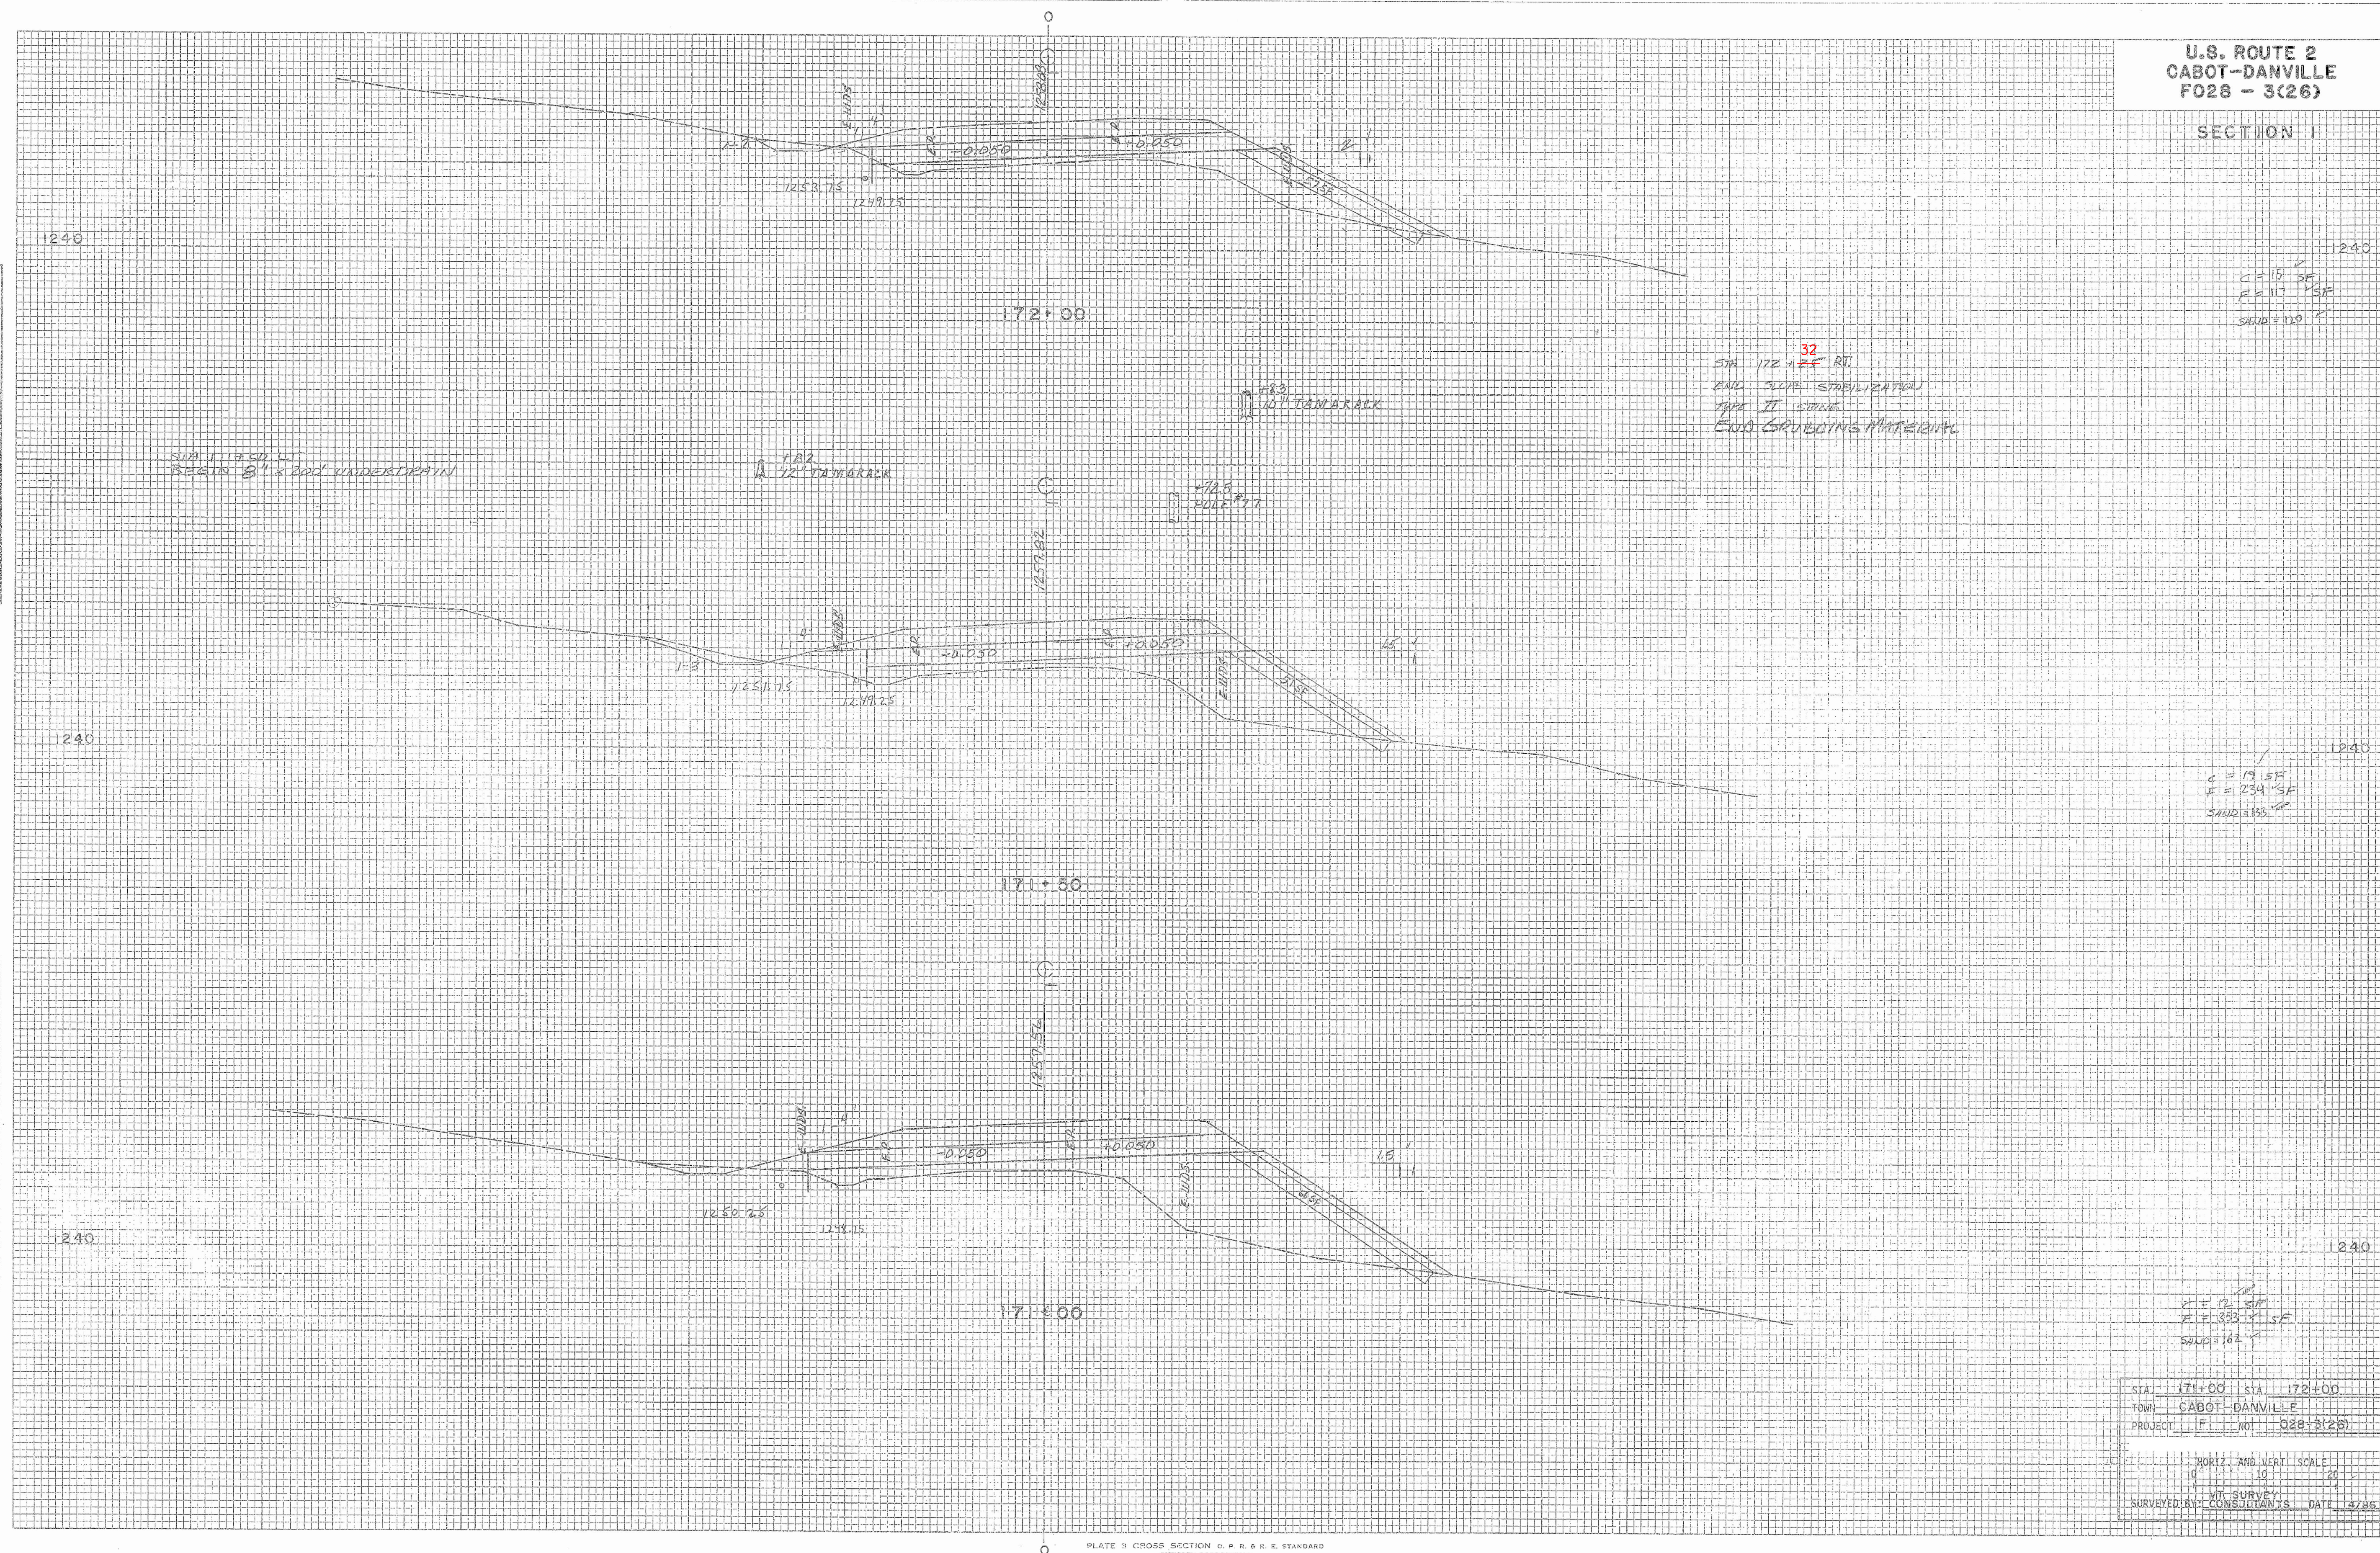
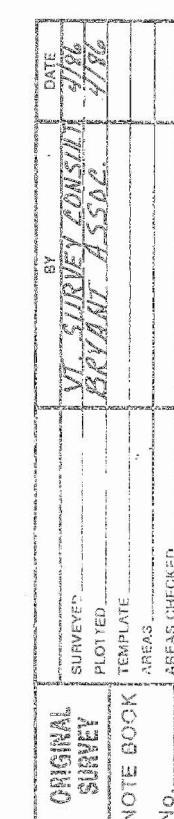
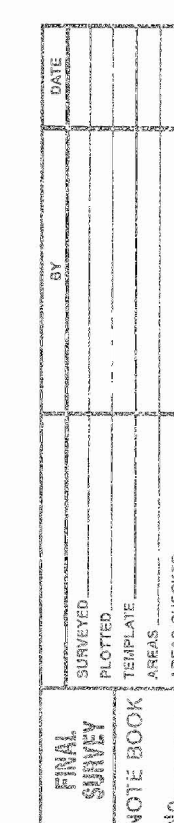


PLATE 3 CROSS SECTION O. P. R. & R. E. STANDARD
DIET-IRON CORROSION

FILE NAME: 78d058xs.dgn
PROJECT LEADER: K. ROBIE
DESIGNED BY: J. SHEA
MAINLINE CROSS SECTIONS 54

PLOT DATE: 06-OCT-2010
DRAWN BY: I. SHEA
CHECKED BY: S. MENARD
SHEET 186 OF 250