

SECTION

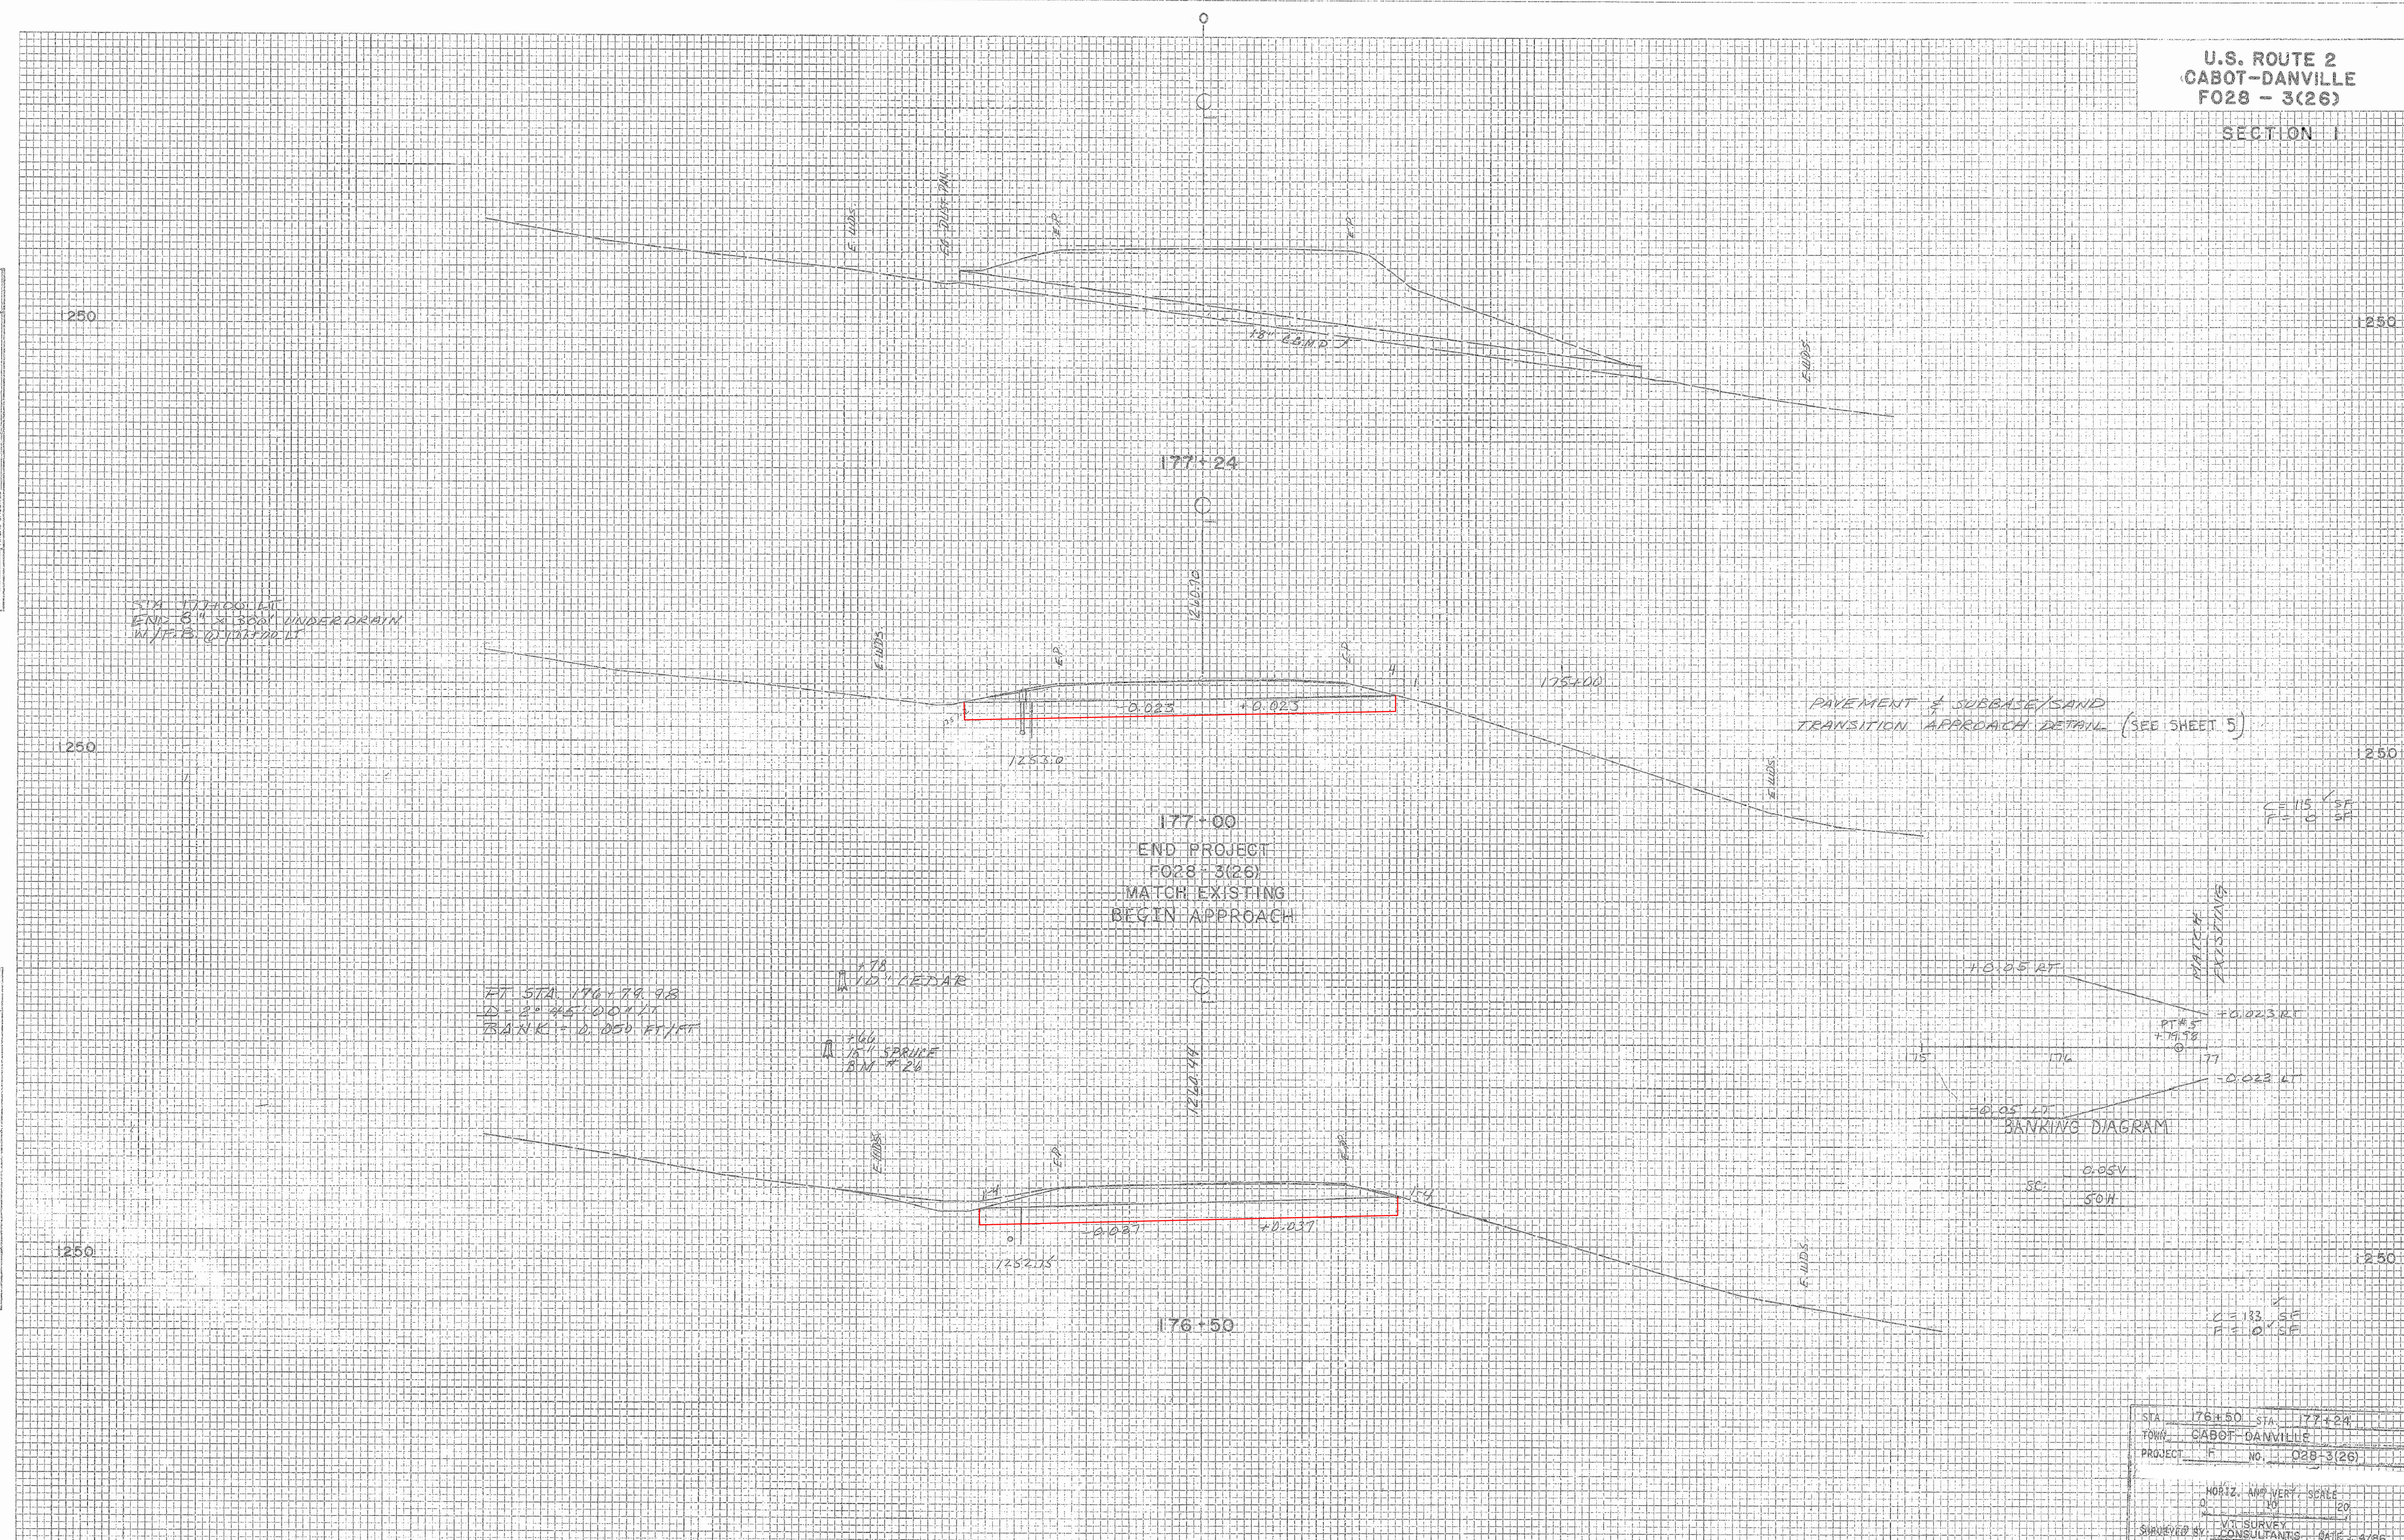
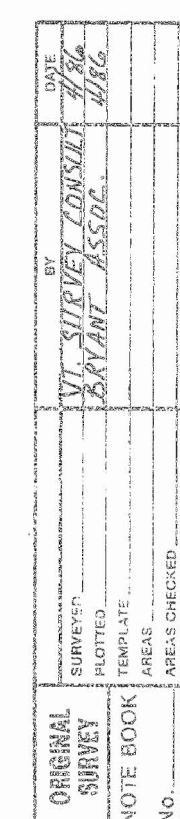
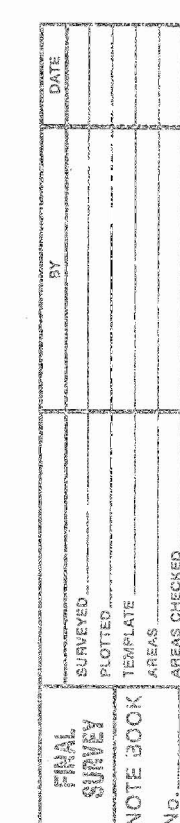


PLATE 3 CROSS SECTION O. P. R. ± R. E. STANDARD
SHEET CORPORATION

PLOT DATE: 06-OCT-2010
DRAWN BY: I. SHEA
CHECKED BY: S. MENARD
SHEET 190 OF 250