



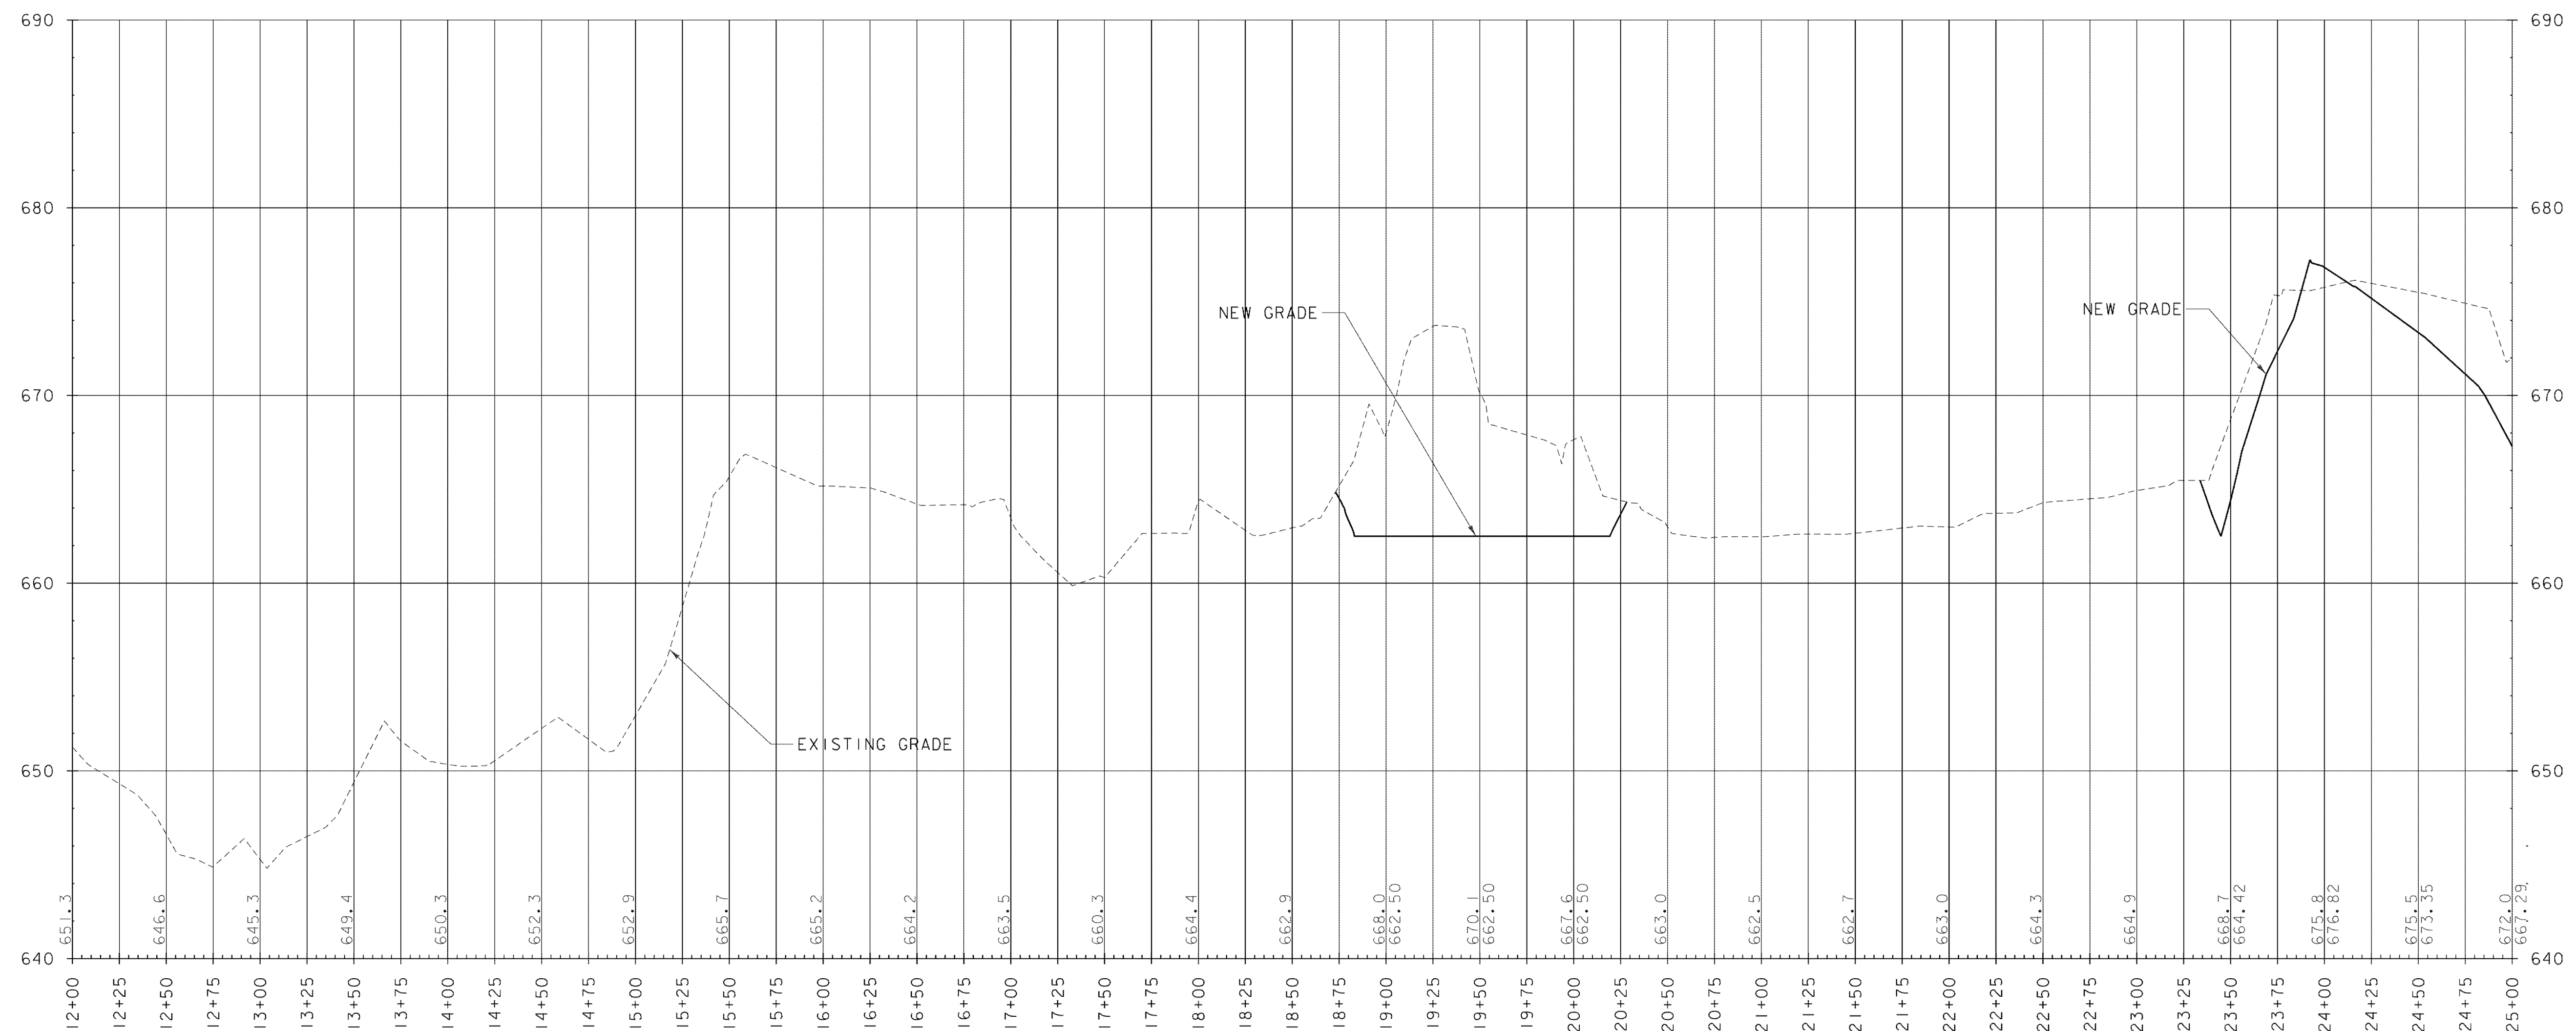

DATUM	
VERTICAL	NAVD 88
HORIZONTAL	NAD 83 (92)

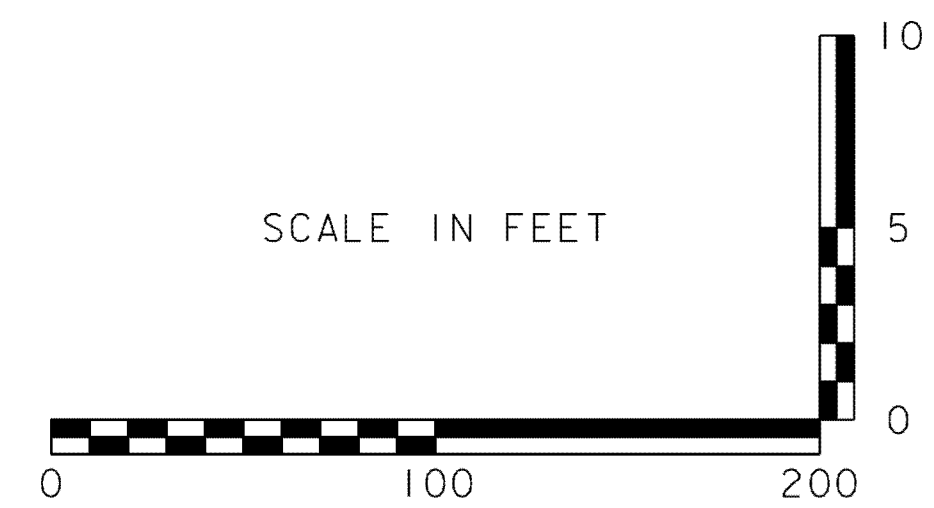

PROJECT NAME: CABOT-DANVILLE	
PROJECT NUMBER: FEGC F 028-3(26)	
FILE NAME: xd079xsl.dgn	PLOT DATE: 9/30/2010
PROJECT LEADER: C.W. BRODIE	DRAWN BY: E.B. SMALL
DESIGNED BY: C.W. BRODIE	CHECKED BY: J.K. BENSON
PROFILE (2)	SHEET 208 OF 250