
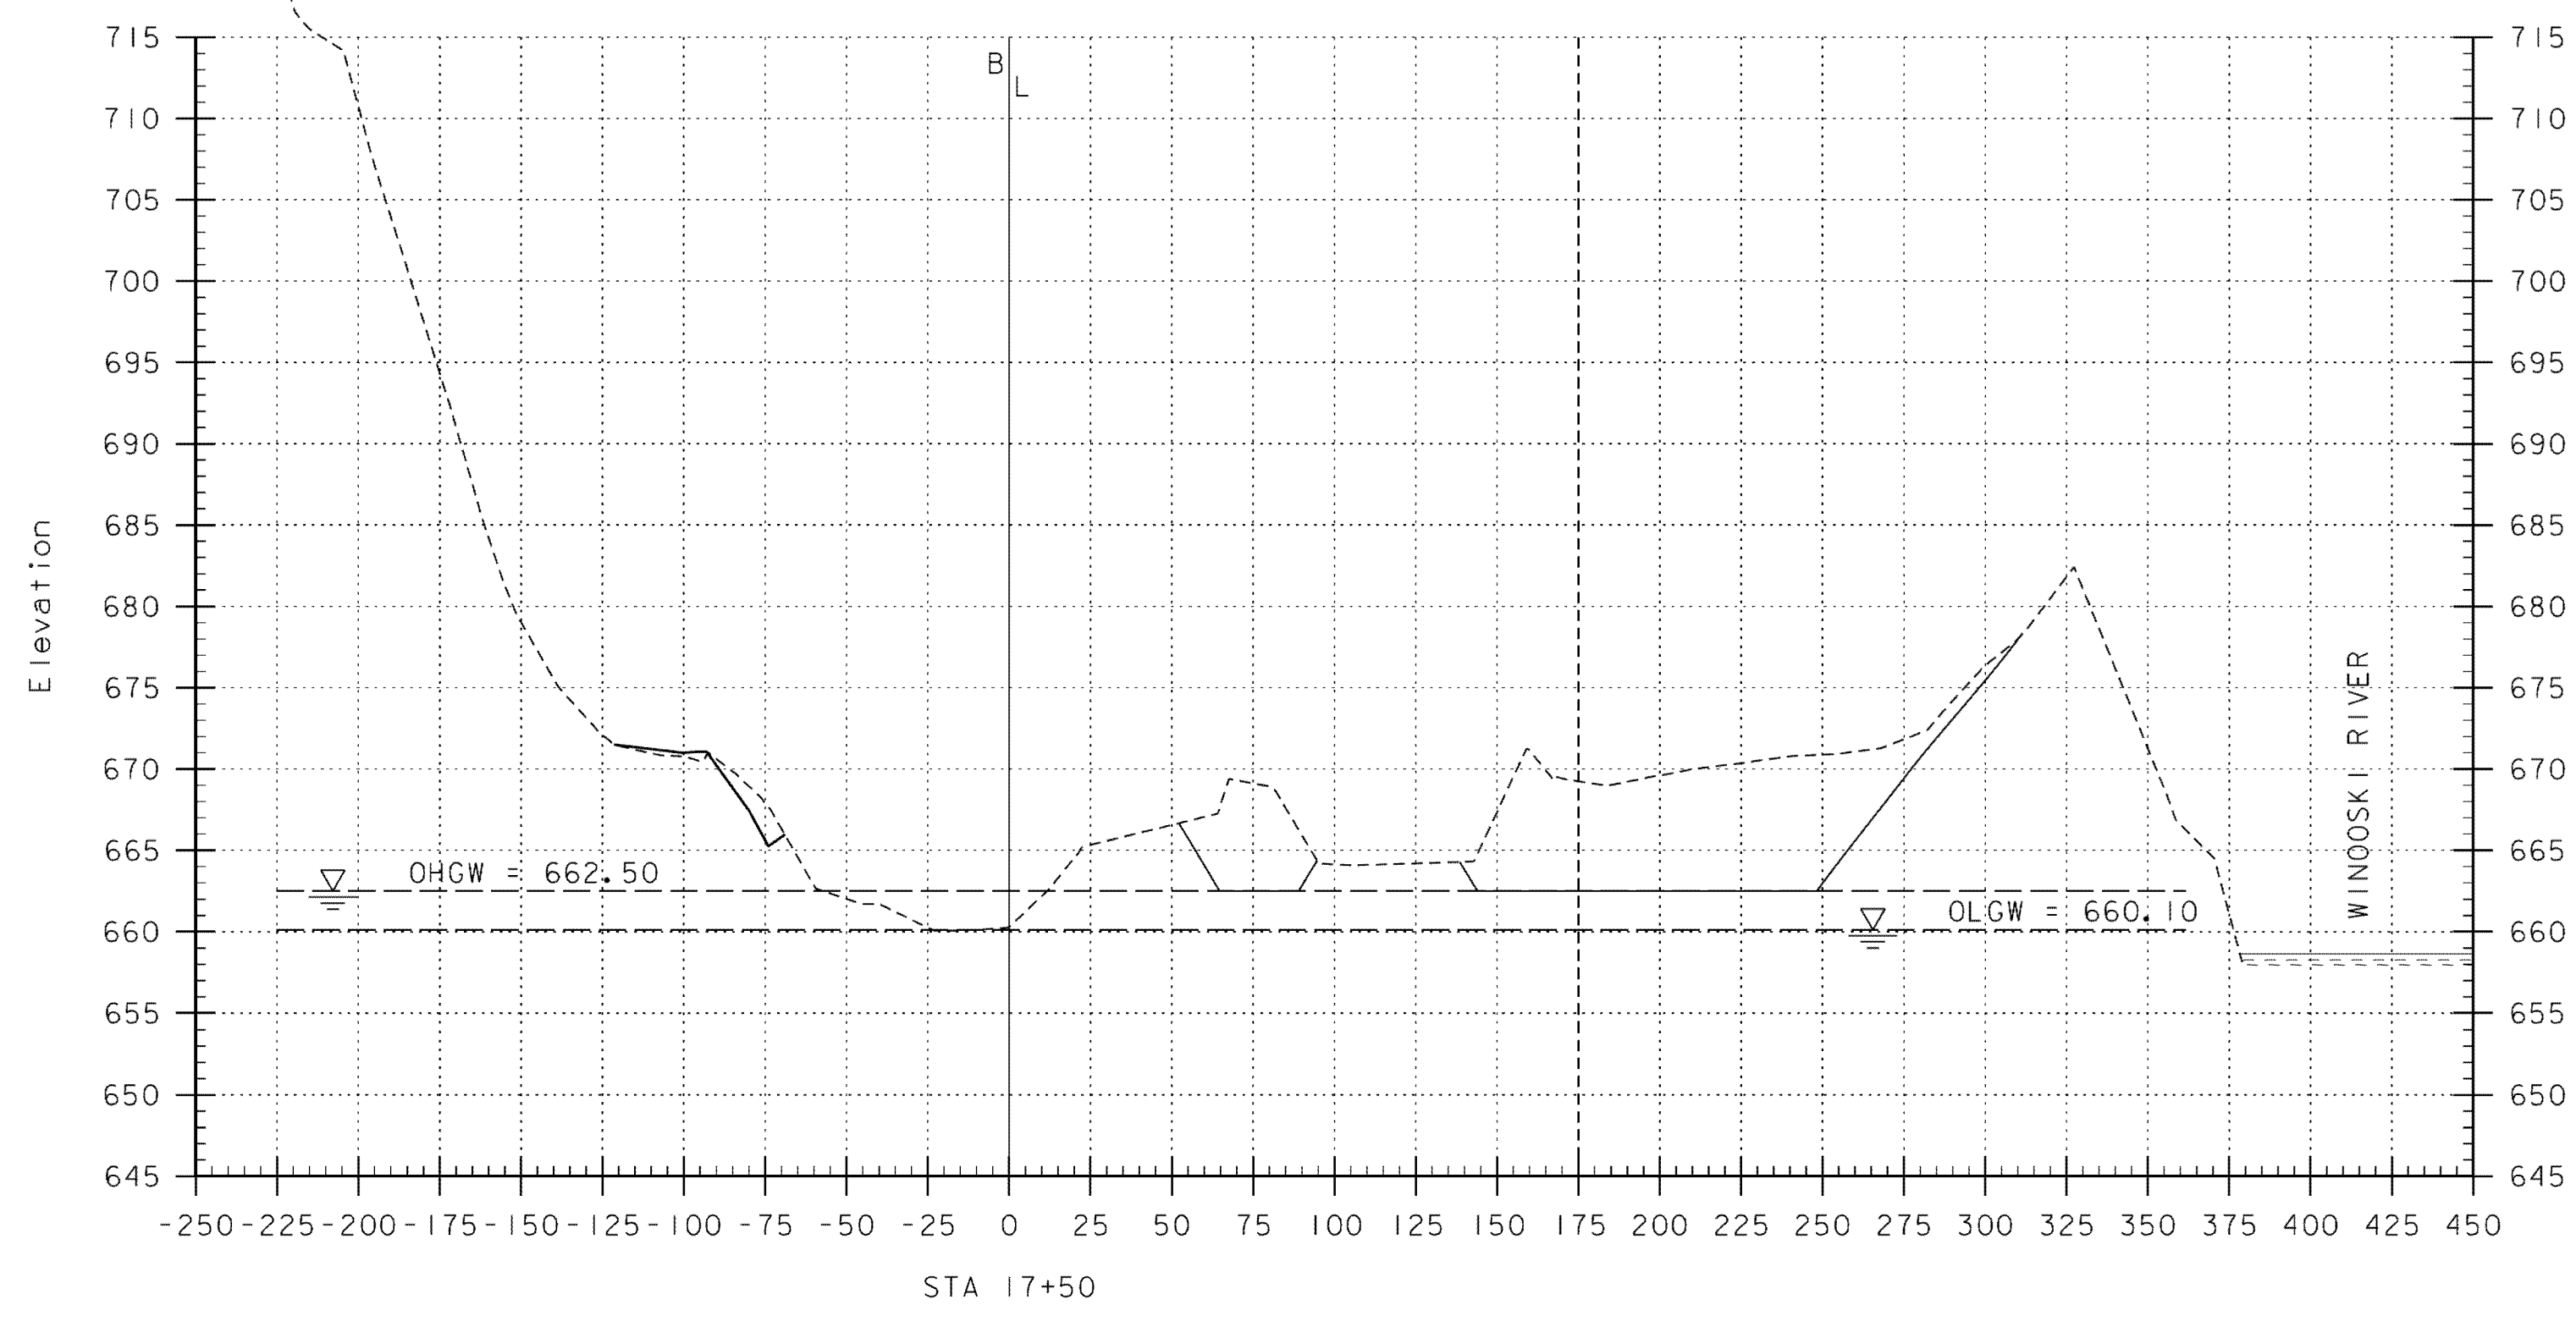
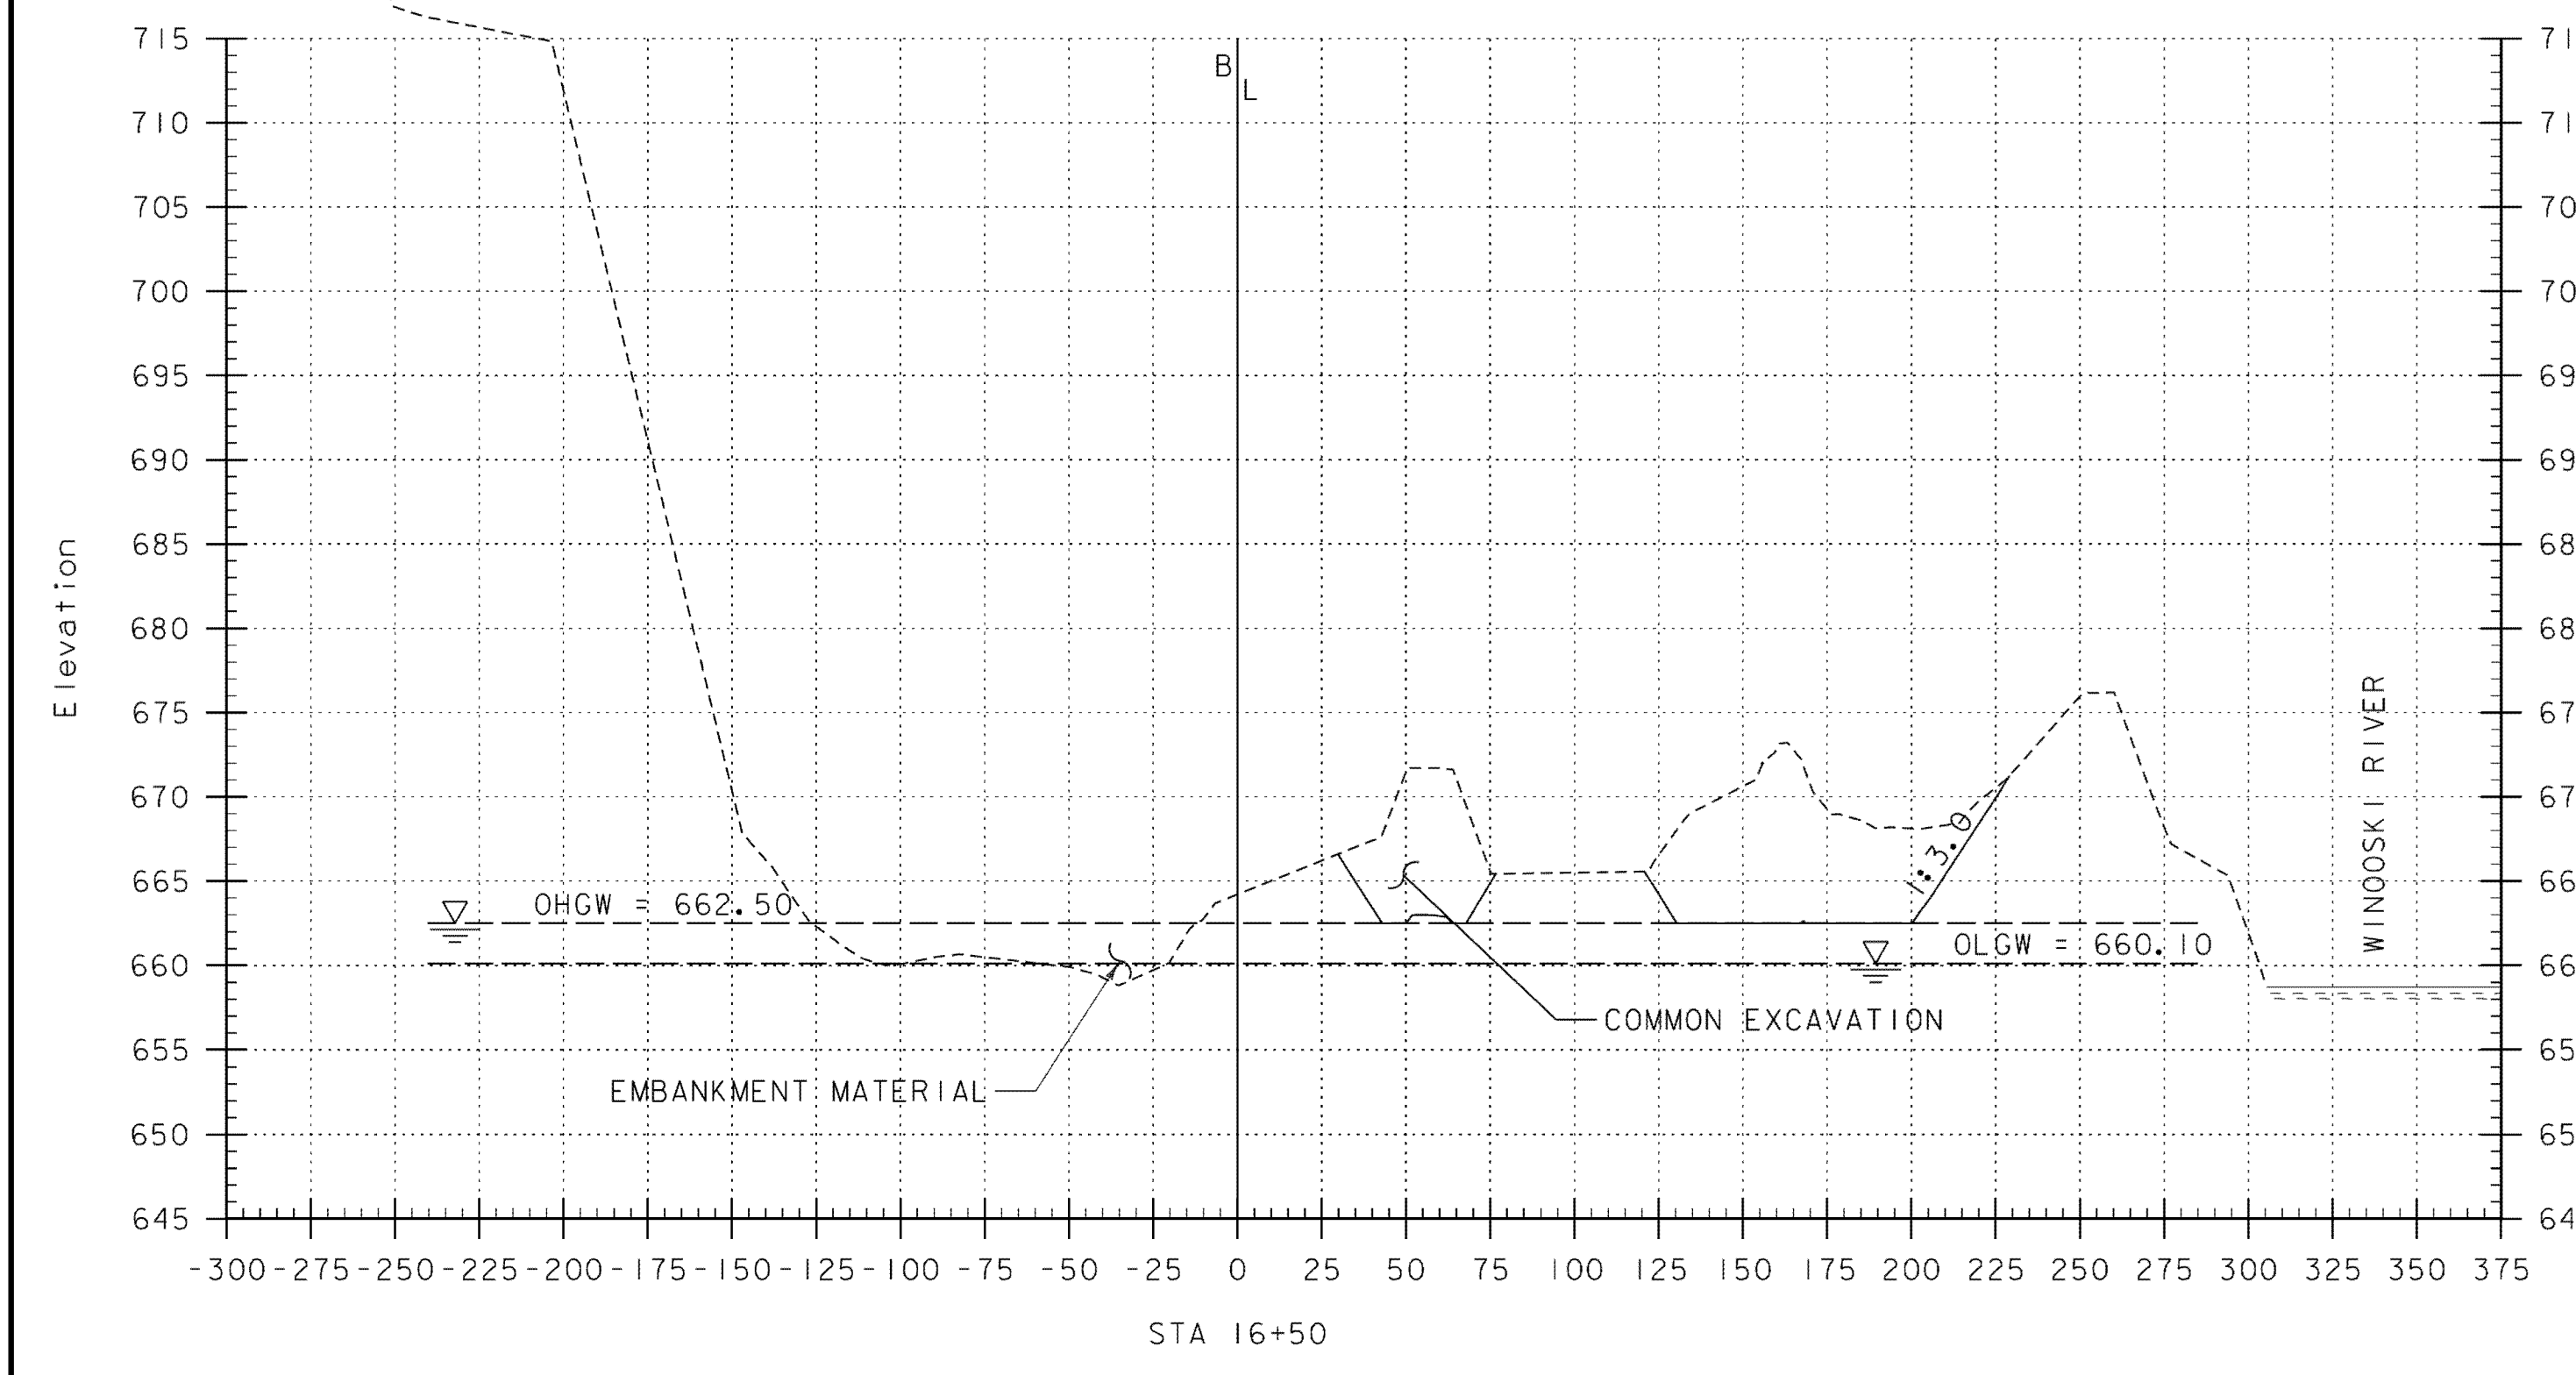
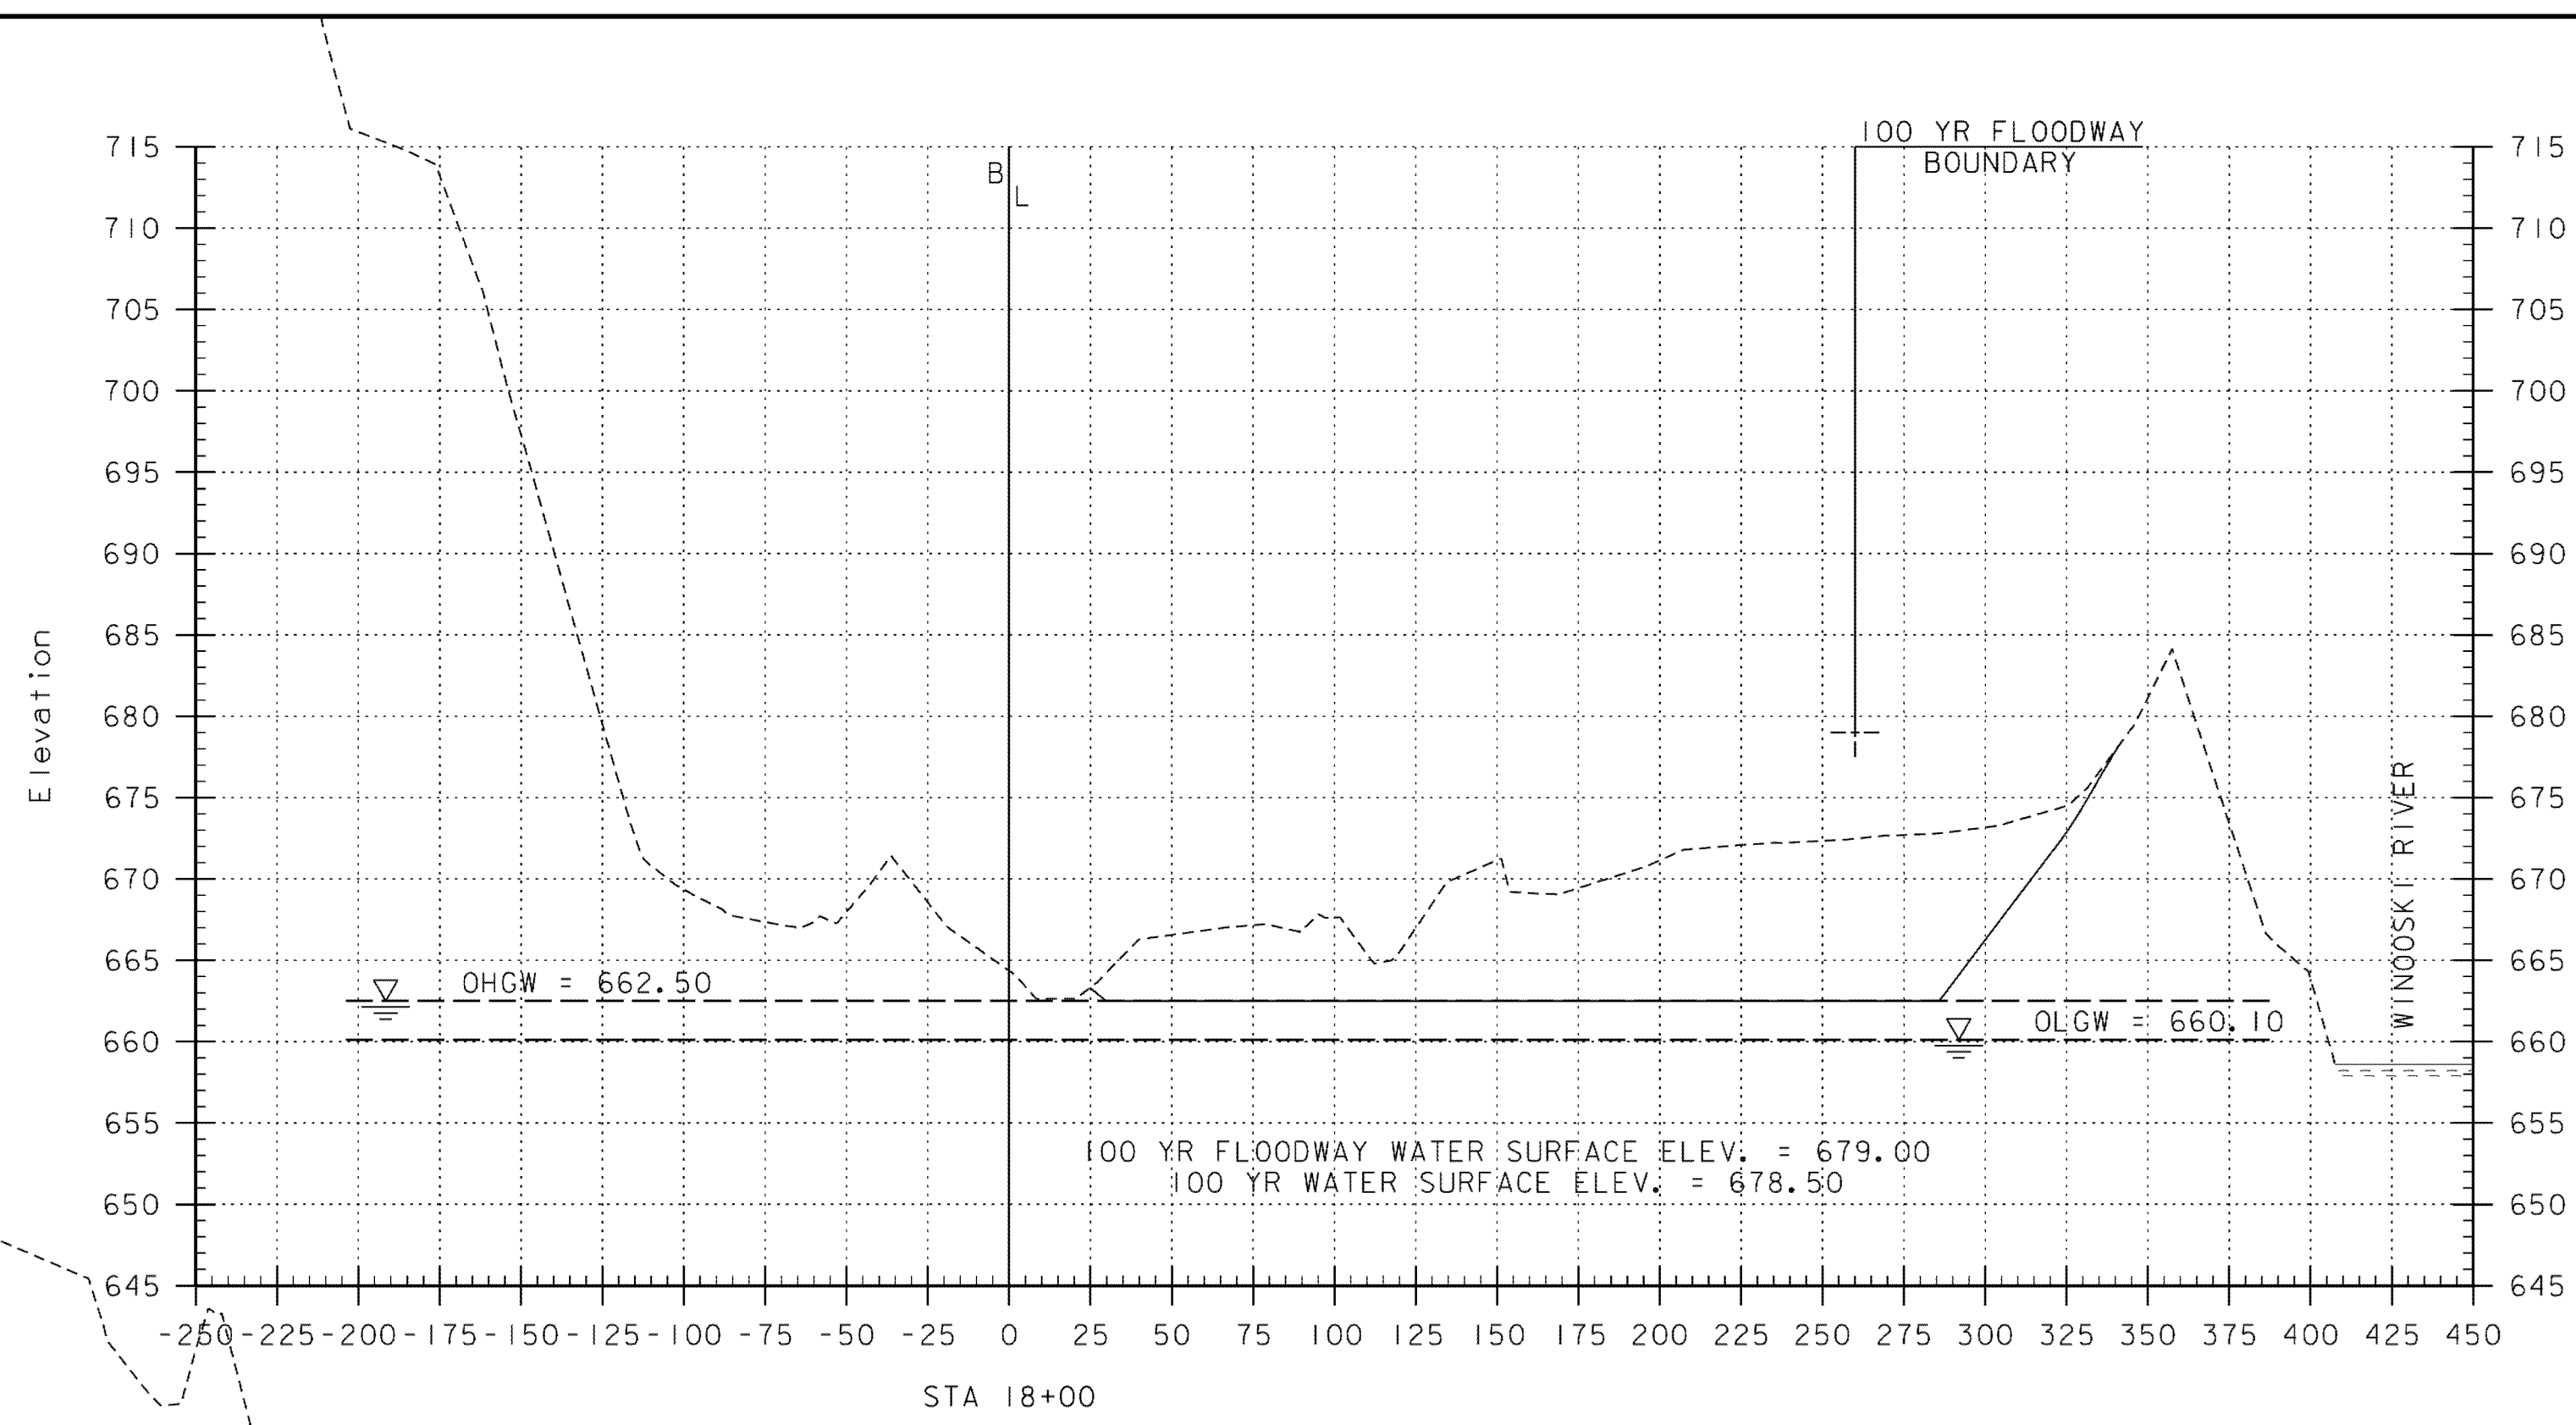


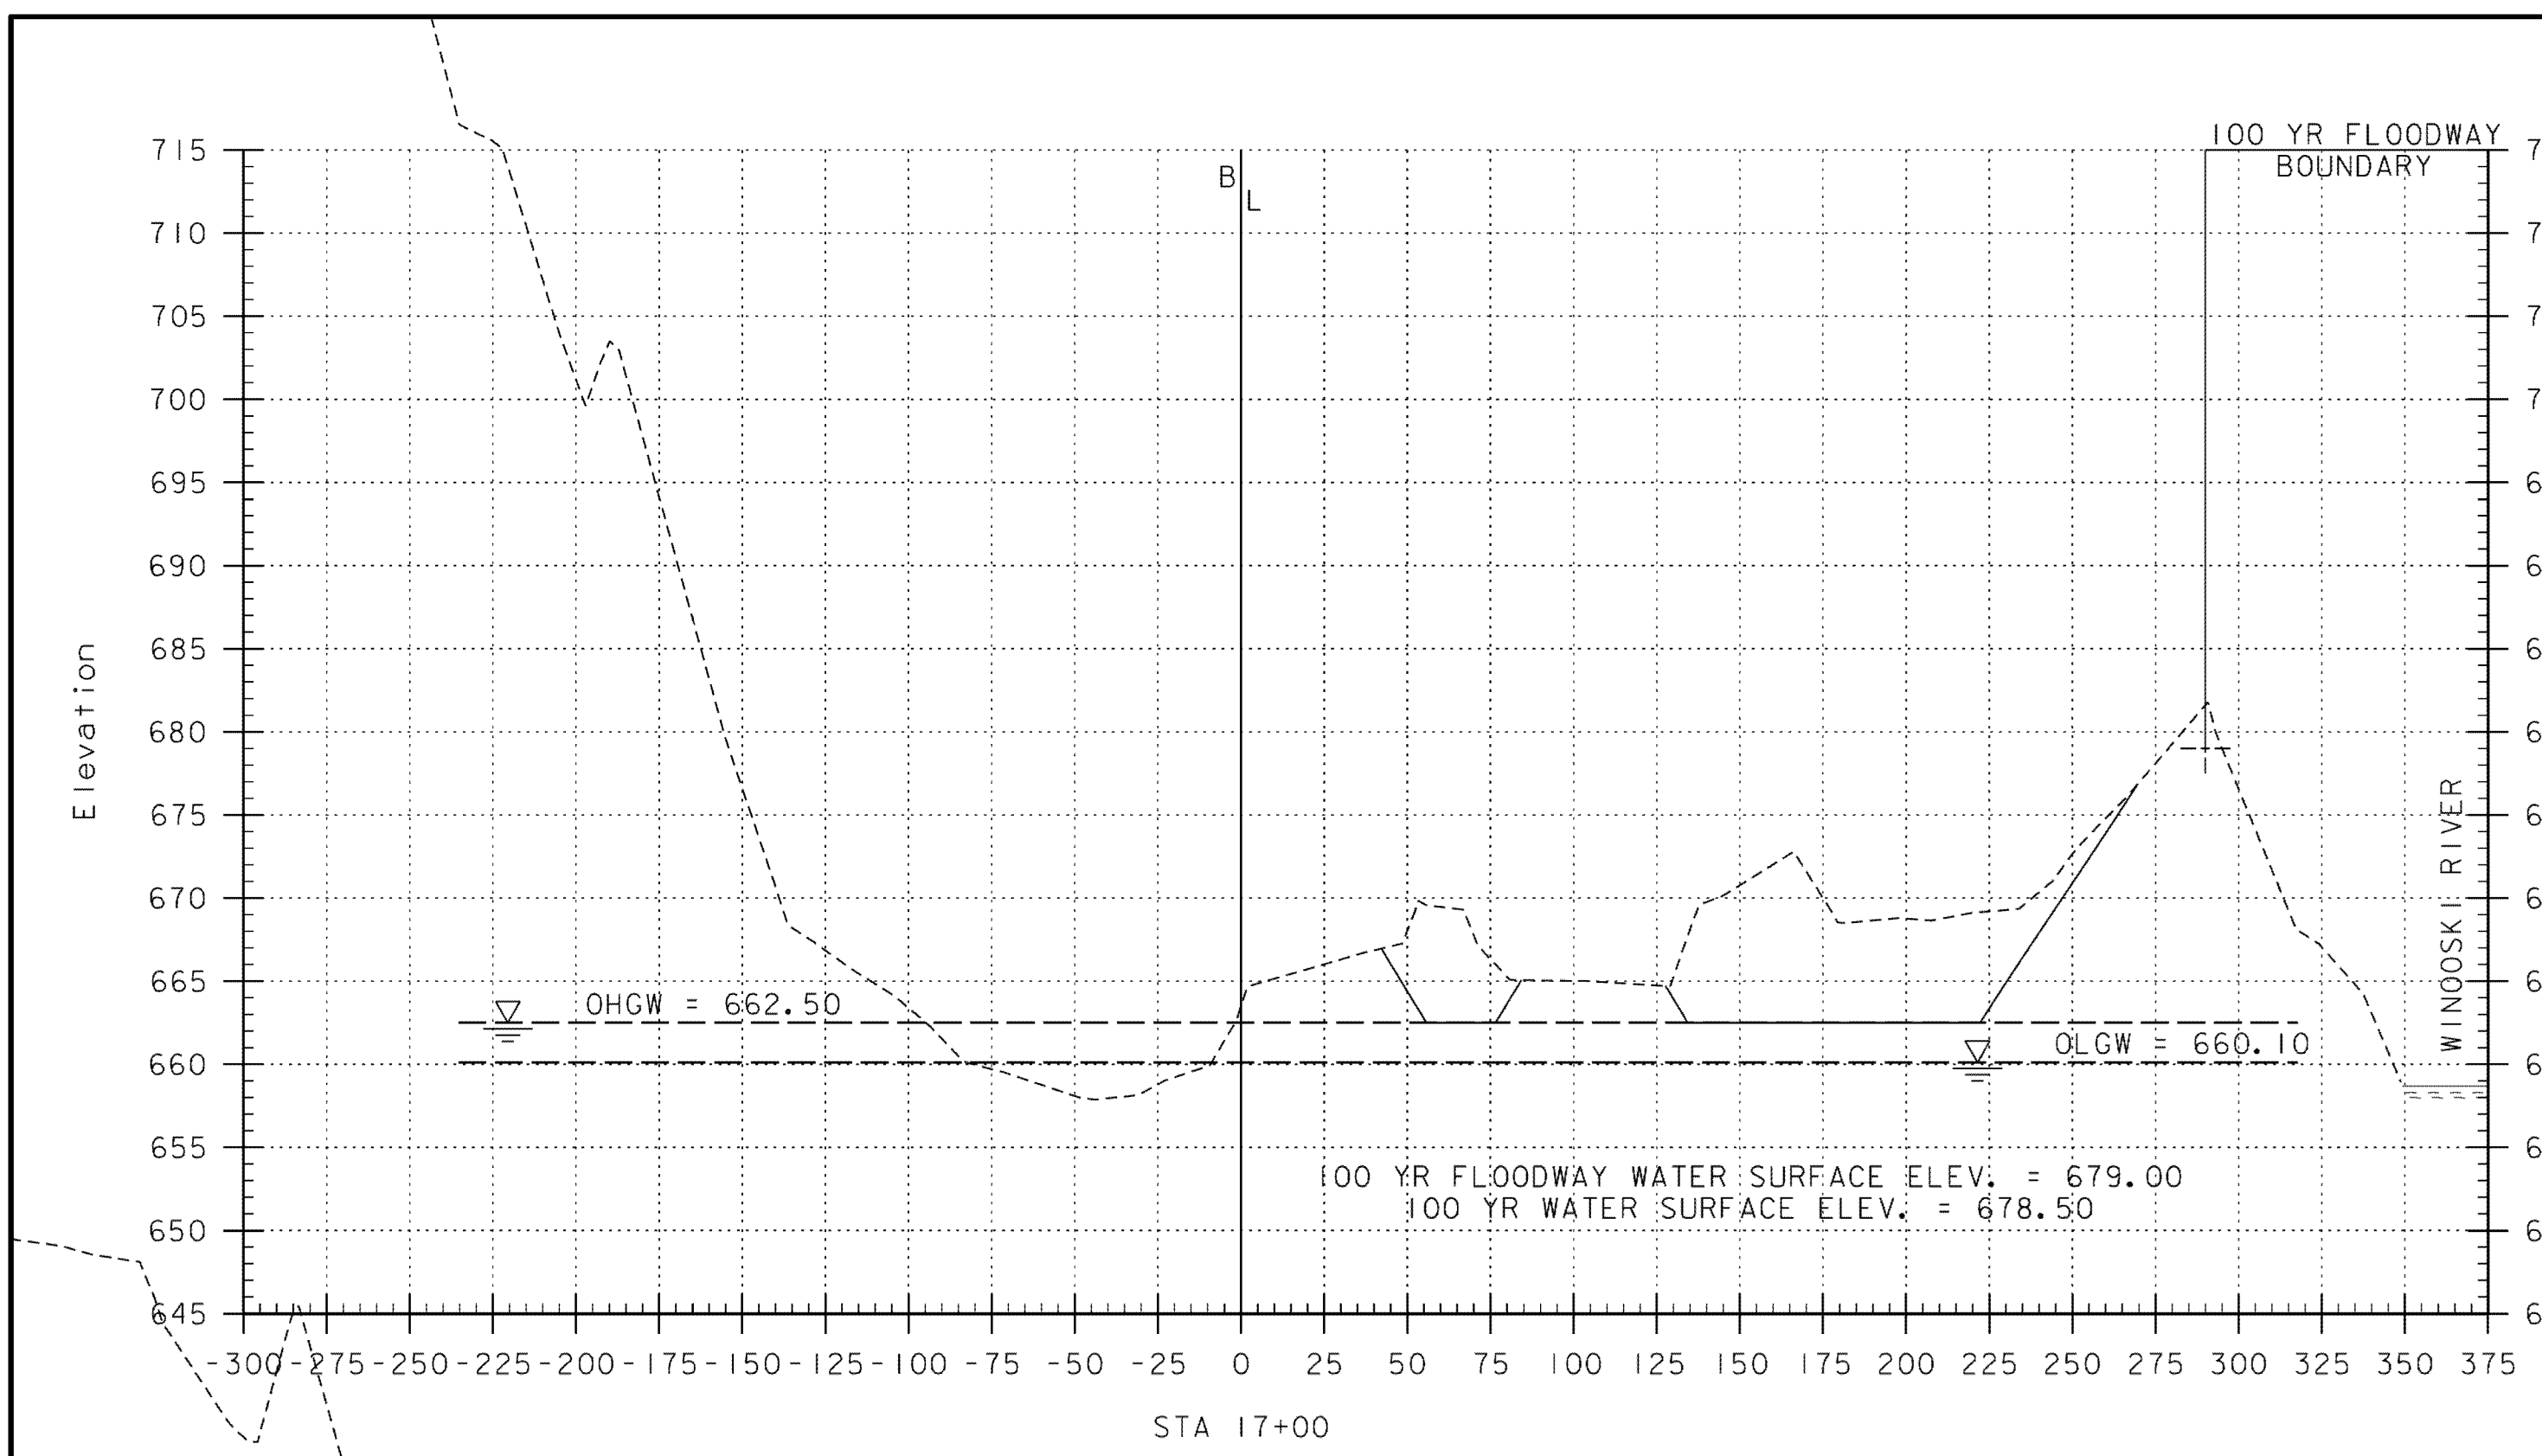

DATUM

VERTICAL	NAVD 88
HORIZONTAL	NAD 83 (92)

LEGEND

EXISTING GRADE	-----
NEW GRADE	—————
ORDINARY HIGH GROUND WATER	▽ — OHGW =
ORDINARY LOW GROUND WATER	▽ — OLGW =
WINOSKI RIVER	=====

SCALE IN FEET

PROJECT NAME:	CABOT-DANVILLE	PLOT DATE:	9/30/2010
PROJECT NUMBER:	FECG F 028-3(26)	DRAWN BY:	E.B. SMALL
FILE NAME:	xd079xsl.dgn	DESIGNED BY:	C.W. BRODIE
CROSS SECTIONS (10)		CHECKED BY:	J.K. BENSON
		SHEET	239 OF 250