

GEOTEXTILE FOR SILT FENCE

STA 88+09 - 88+18 LT
STA 88+27 - 88+33 LT
STA 88+42 - 88+49 LT
STA 88+64 - 88+69 LT
STA 88+96 - 89+08 LT
STA 89+43 - 89+50 LT
STA 89+52 - 90+09 LT

GEOTEXTILE FOR SILT FENCE,
WOVEN WIRE REINFORCED

STA 93+00 LT
STA 93+21 LT
STA 93+44 LT
STA 93+54 - 93+66 LT
STA 93+86 - 94+12 LT
STA 94+22 - 94+35 LT
STA 94+56 - 94+60 LT
STA 94+98 - 95+06 LT
STA 95+43 - 95+53 LT
STA 95+53 - 96+00 LT

TEMPORARY STONE CHECK DAM, TYPE I

STA 11+87 - 12+15 LT (BIKE-PATH WEST)
STA 12+23 - 13+36 RT (BIKE-PATH WEST)
STA 11+87 - 11+97 RT (BIKE-PATH WEST)
STA 12+20 - 13+36 LT (BIKE-PATH WEST)
STA 3+50 - 4+00 LT (BIKE-PATH EAST)
STA 3+50 - 6+00 RT (BIKE-PATH EAST)
STA 4+35 - 6+00 LT (BIKE-PATH EAST)
STA 20+20 - 20+75 RT & LT (PATH ACCESS)

TEMPORARY EROSION MATTING

STA 88+00 - 91+44 RT
STA 88+00 - 92+64 LT
STA 91+37 - 92+21 RT
STA 91+56 - 92+44 RT
STA 91+56 - 92+71 LT
STA 93+00 - 96+00 LT
STA 92+52 - 96+00 RT

BARRIER FENCE


STA 92+52 - 93+24 RT
STA 92+74 - 93+90 LT
STA 93+35 - 94+58 RT
STA 94+00 - 95+20 LT

INLET PROTECTION DEVICE, TYPE I

STA 89+00 LT (STONE & DROP BLOCK)
STA 89+00 RT (STONE & DROP BLOCK)
STA 91+40 LT & RT (STONE & DROP BLOCK)
STA 91+60 LT (2-STONE & DROP BLOCK)
STA 91+60 RT (STONE & DROP BLOCK)
STA 93+23 LT (STONE & DROP BLOCK)
STA 20+20 LT (PIPE INLET PROTECTION, BIKE PATH ACCESS)


PROJECT DEMARCATION FENCE

STA 88+00 - 91+21 RT
STA 88+00 - 92+74 LT
STA 91+35 - 92+40 RT
STA 94+58 - 96+00 RT
STA 95+20 - 96+00 LT

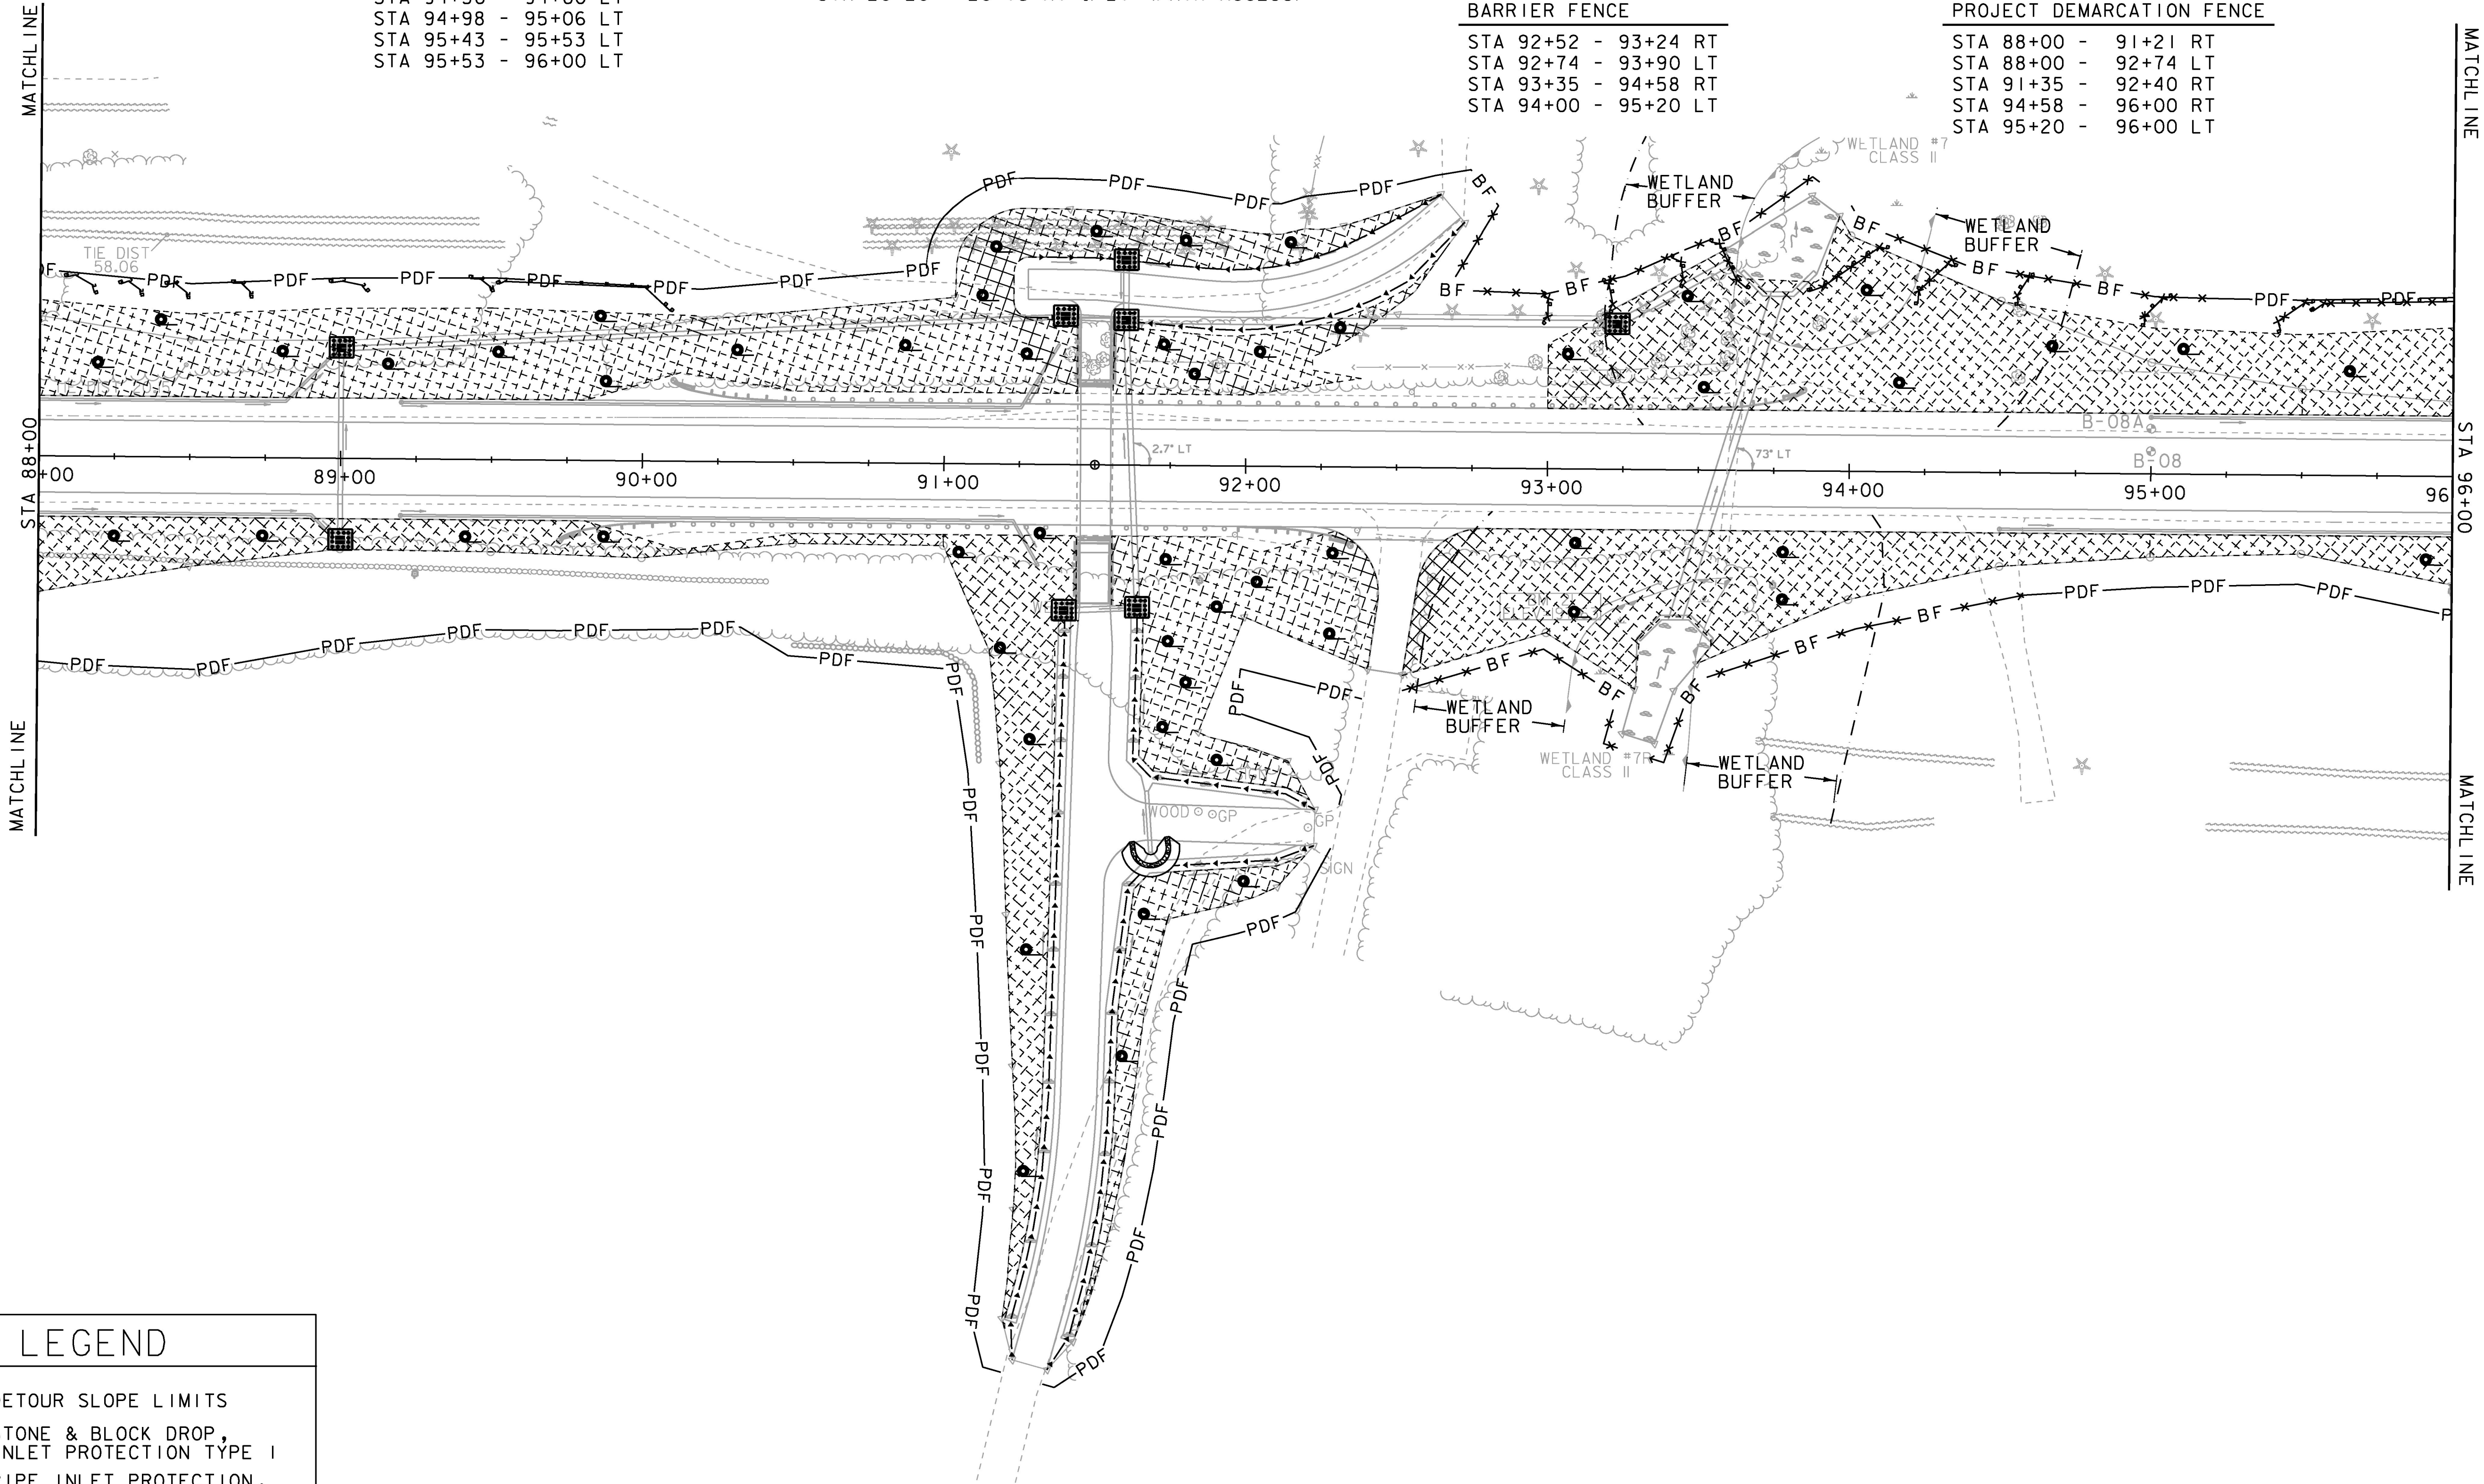

LEGEND

- DETOUR SLOPE LIMITS
- STONE & BLOCK DROP, INLET PROTECTION TYPE I
- PIPE INLET PROTECTION, INLET PROTECTION TYPE I

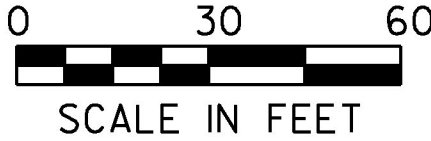

PROJECT NAME: CHARLOTTE	
PROJECT NUMBER: F EGC 019-4(20)	
FILE NAME: d78d062_ero_construction.bdr, dgn	PLOT DATE: 15-MAR-2016
PROJECT LEADER: K. UPMAL	DRAWN BY: B. KIPP
DESIGNED BY: B. KIPP	CHECKED BY: C. LEACH
EPSC CONSTRUCTION SHEET II	SHEET 148 OF 499