

GEOTEXTILE FOR SILT FENCE

STA 96+25 - 96+92 LT
STA 96+97 LT
STA 97+57 LT
STA 98+36 LT
STA 98+91 LT
STA 99+26 - 99+97 LT (5)
STA 100+13 LT
STA 100+77 LT
STA 101+08 LT
STA 101+37 - 102+05 LT (6)

GEOTEXTILE FOR SILT FENCE, WOVEN WIRE REINFORCED

STA 96+00 - 96+29 LT
STA 102+06 - 102+16 LT
STA 102+23 - 102+34 LT
STA 102+34 - 102+48 LT
STA 102+49 - 102+61 LT
STA 102+67 - 102+97 LT
STA 103+01 - 103+26 LT
STA 103+34 - 103+51 LT
STA 103+49 - 103+98 LT

BARRIER FENCE

STA 101+81 - 104+00 LT
STA 103+74 - 104+00 RT

PROJECT DEMARCATION FENCE



STA 96+00 - 103+75 RT
STA 96+00 - 101+78 LT

TEMPORARY EROSION MATTING

STA 96+00 - 102+00 LT
STA 96+00 - 104+00 RT


TEMPORARY STONE CHECK DAM, TYPE I

STA 96+00 TO 103+25 LT
STA 96+00 TO 103+64 RT

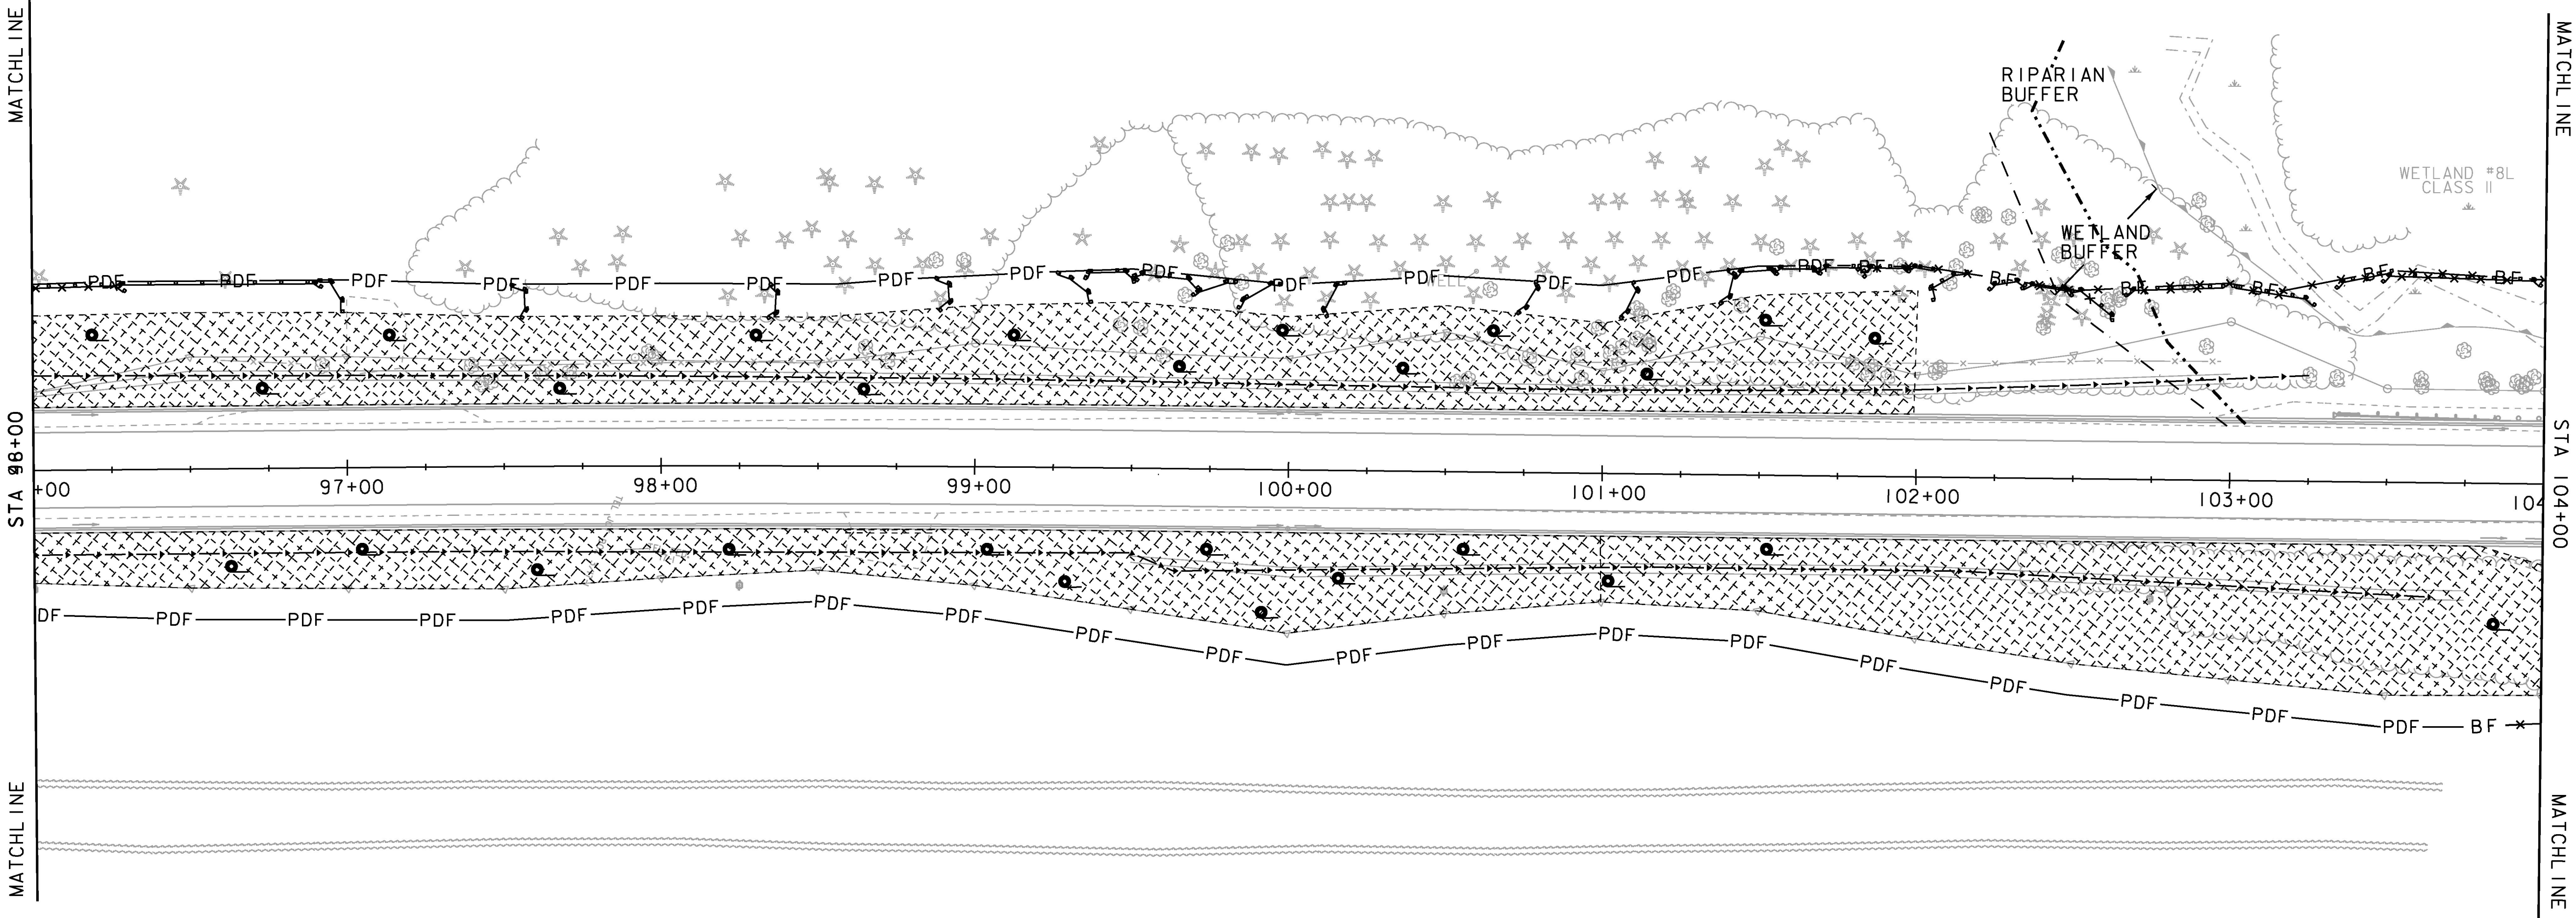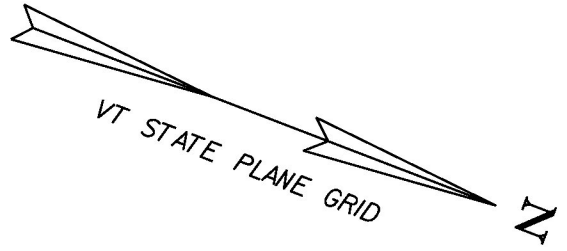

LEGEND

- DETOUR SLOPE LIMITS
- STONE & BLOCK DROP, INLET PROTECTION TYPE I
- PIPE INLET PROTECTION, INLET PROTECTION TYPE I

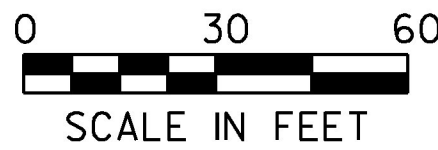

PROJECT NAME:	CHARLOTTE
PROJECT NUMBER:	F EGC 019-4(20)
FILE NAME:	d78d062_ero_construction.bdr, dgn
PLOT DATE:	15-MAR-2016
PROJECT LEADER:	K. UPMAL
DRAWN BY:	N. PAPPAS
DESIGNED BY:	N. PAPPAS
CHECKED BY:	C. LEACH
EPSC CONSTRUCTION SHEET 12	SHEET 149 OF 499