



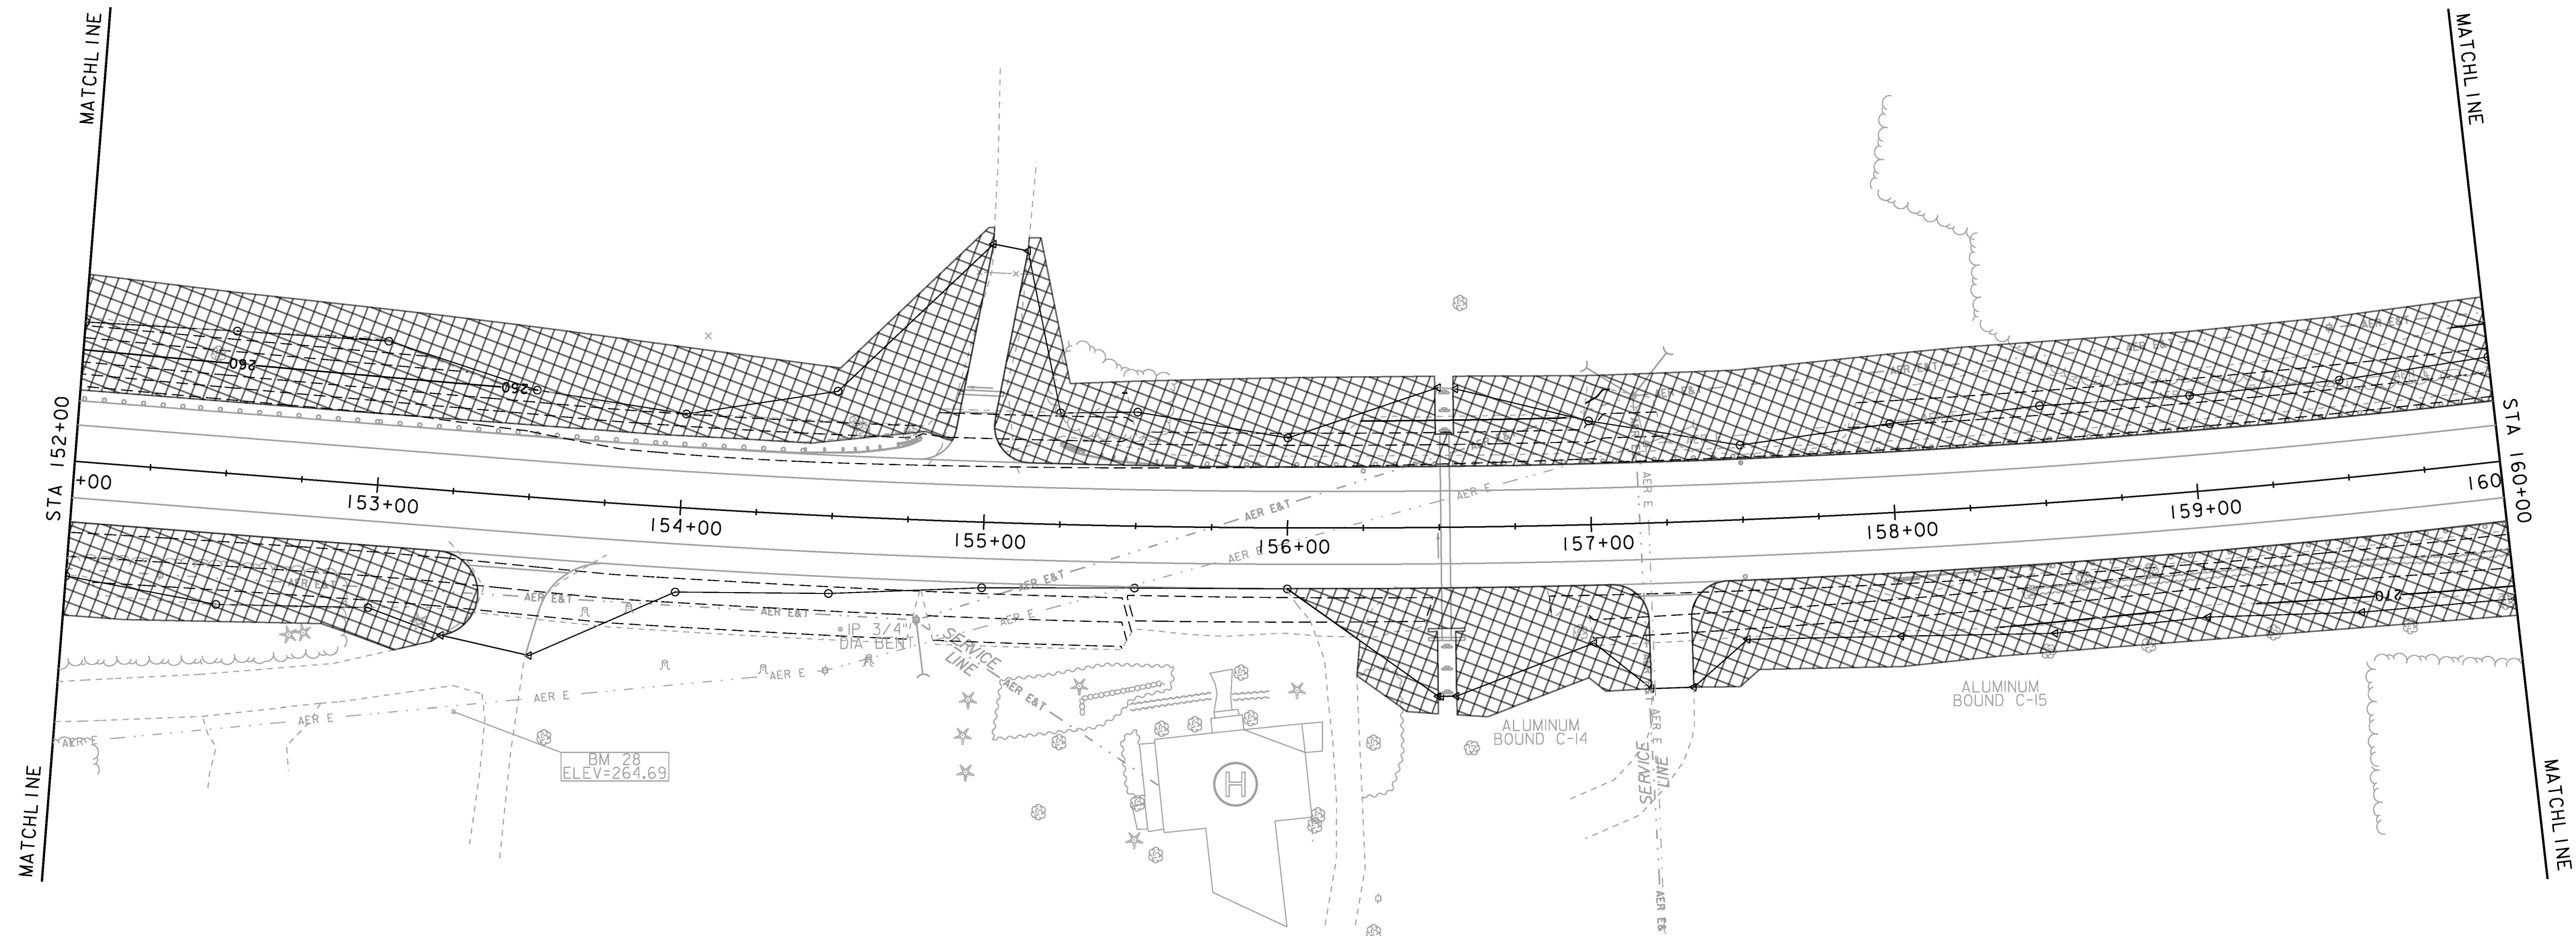

LEGEND

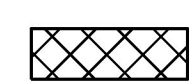

DISTURBED AREAS
REQUIRING RE-VEGETATION

0 30 60
SCALE IN FEET

PROJECT NAME: CHARLOTTE
PROJECT NUMBER: F EGC 019-4(20)

FILE NAME: d78d062_ero_final.bdr.dgn	PLOT DATE: 15-MAR-2016
PROJECT LEADER: K. UPMAL	DRAWN BY: N. PAPPAS
DESIGNED BY: N. PAPPAS	CHECKED BY: C. LEACH
EPSC FINAL CONDITIONS SHEET 19	SHEET 176 OF 499