



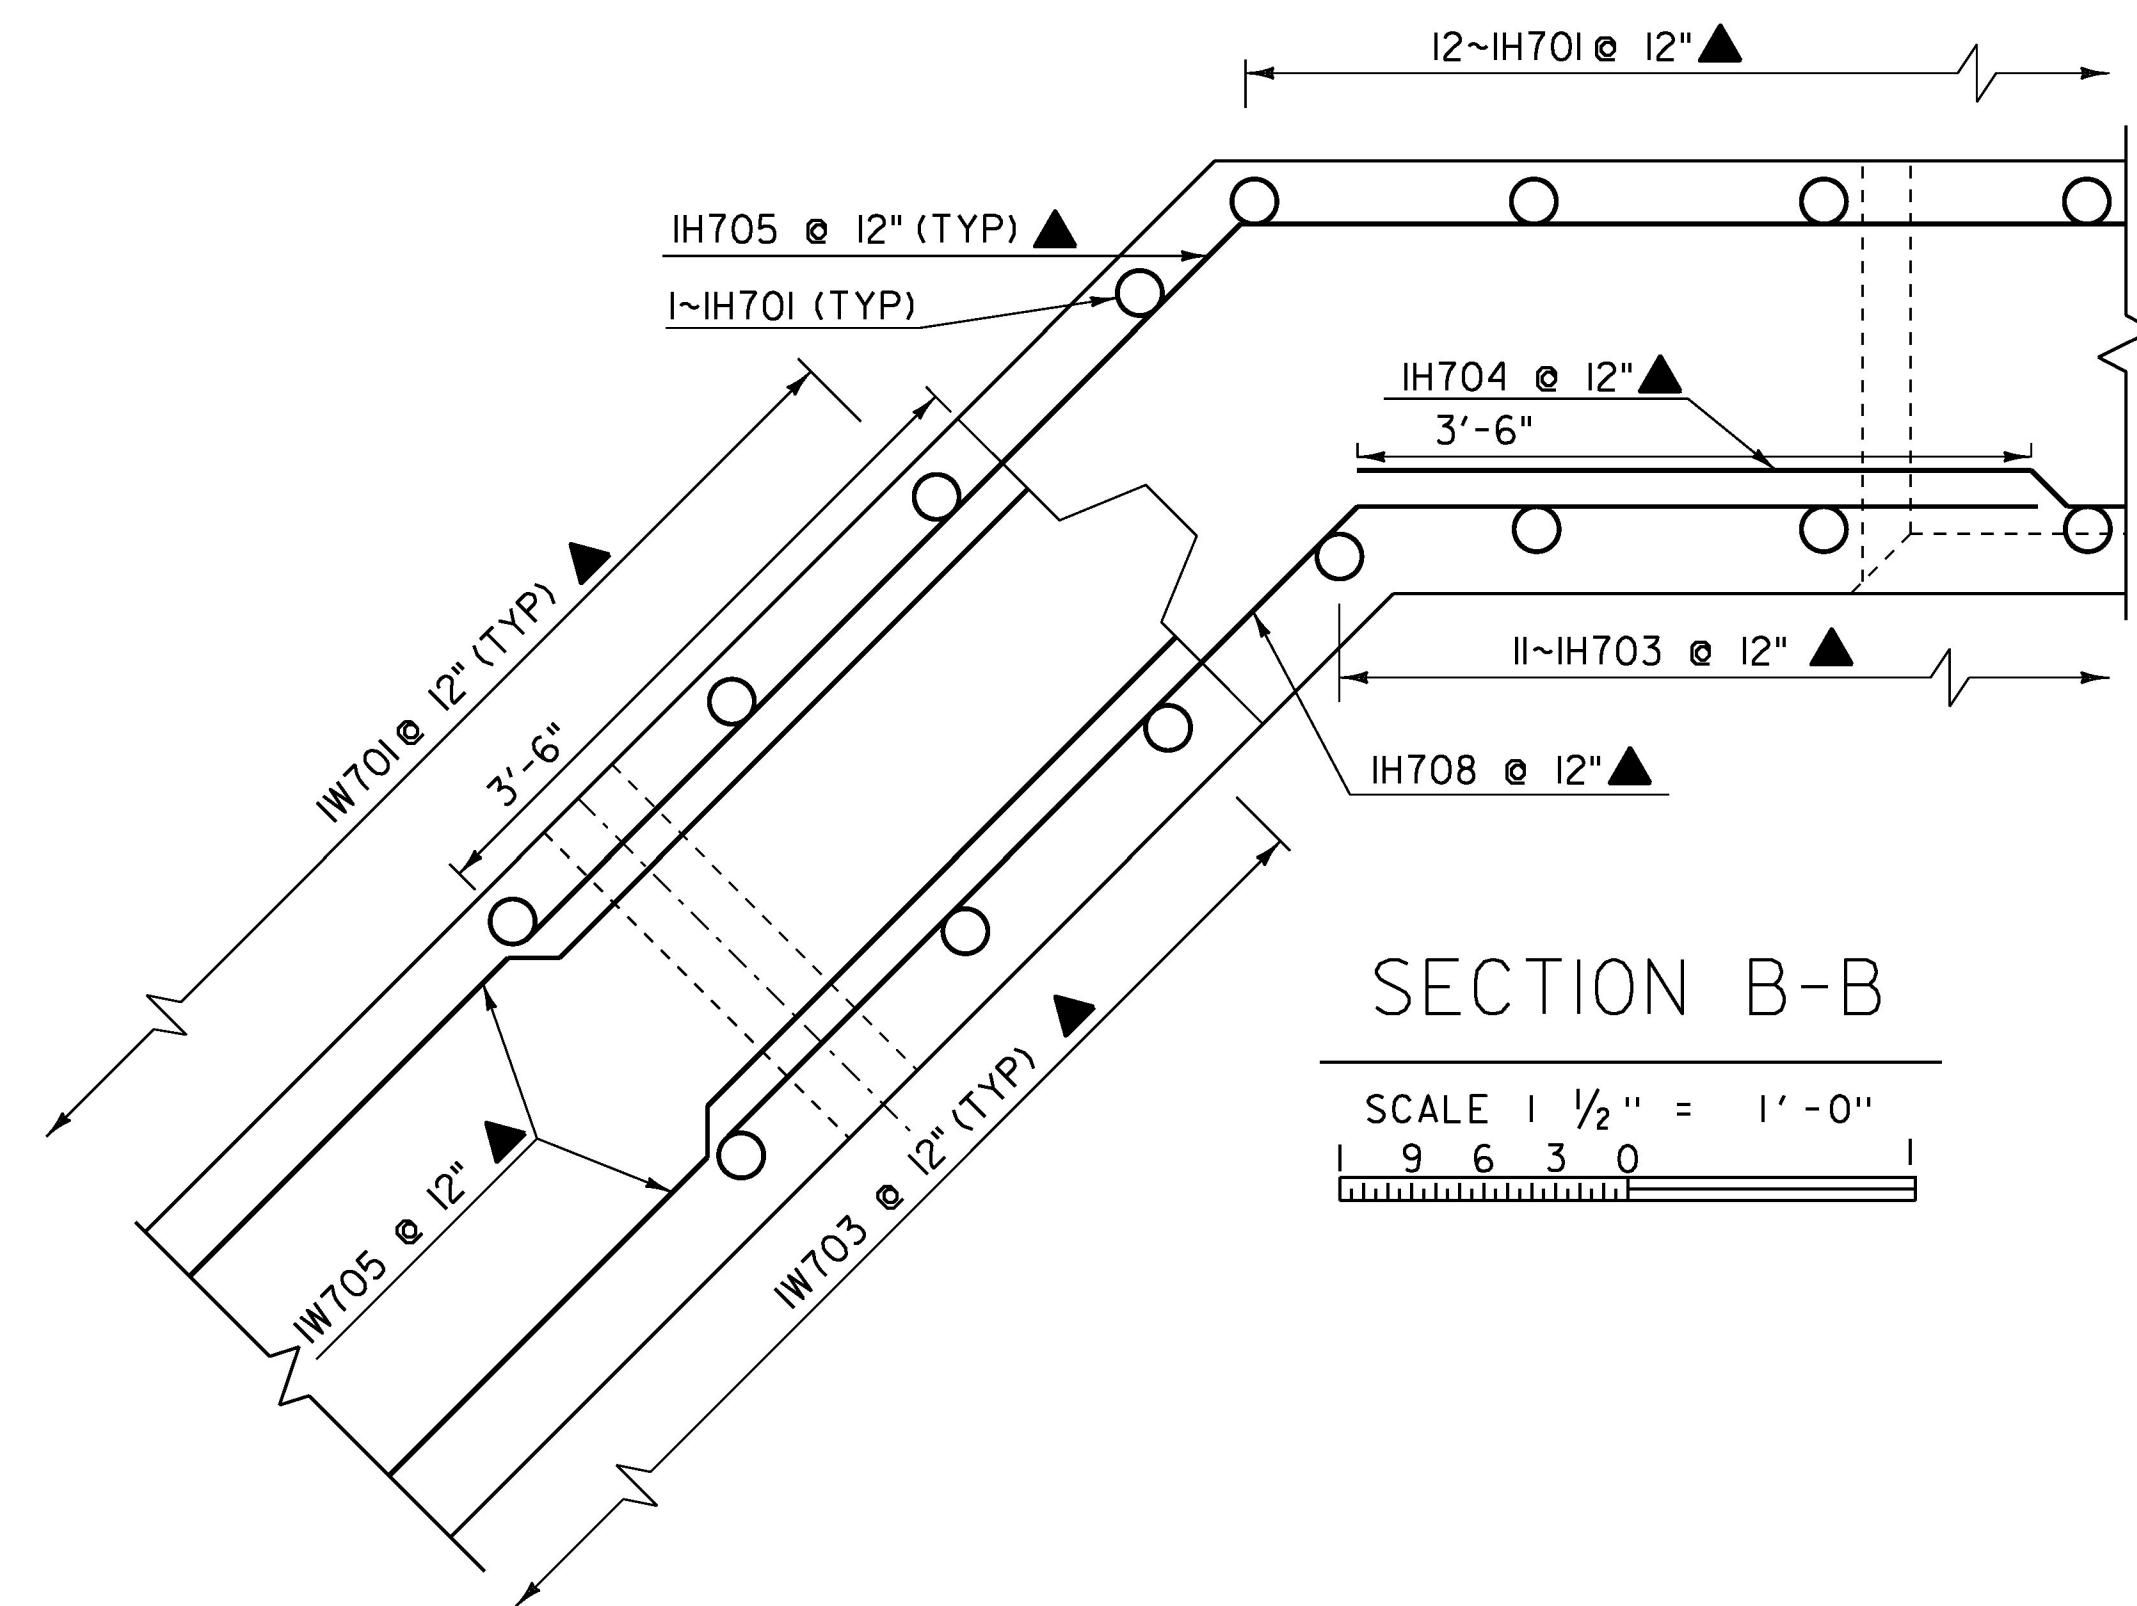


SECTION B-B

SCALE 1 1/2" = 1'-0"

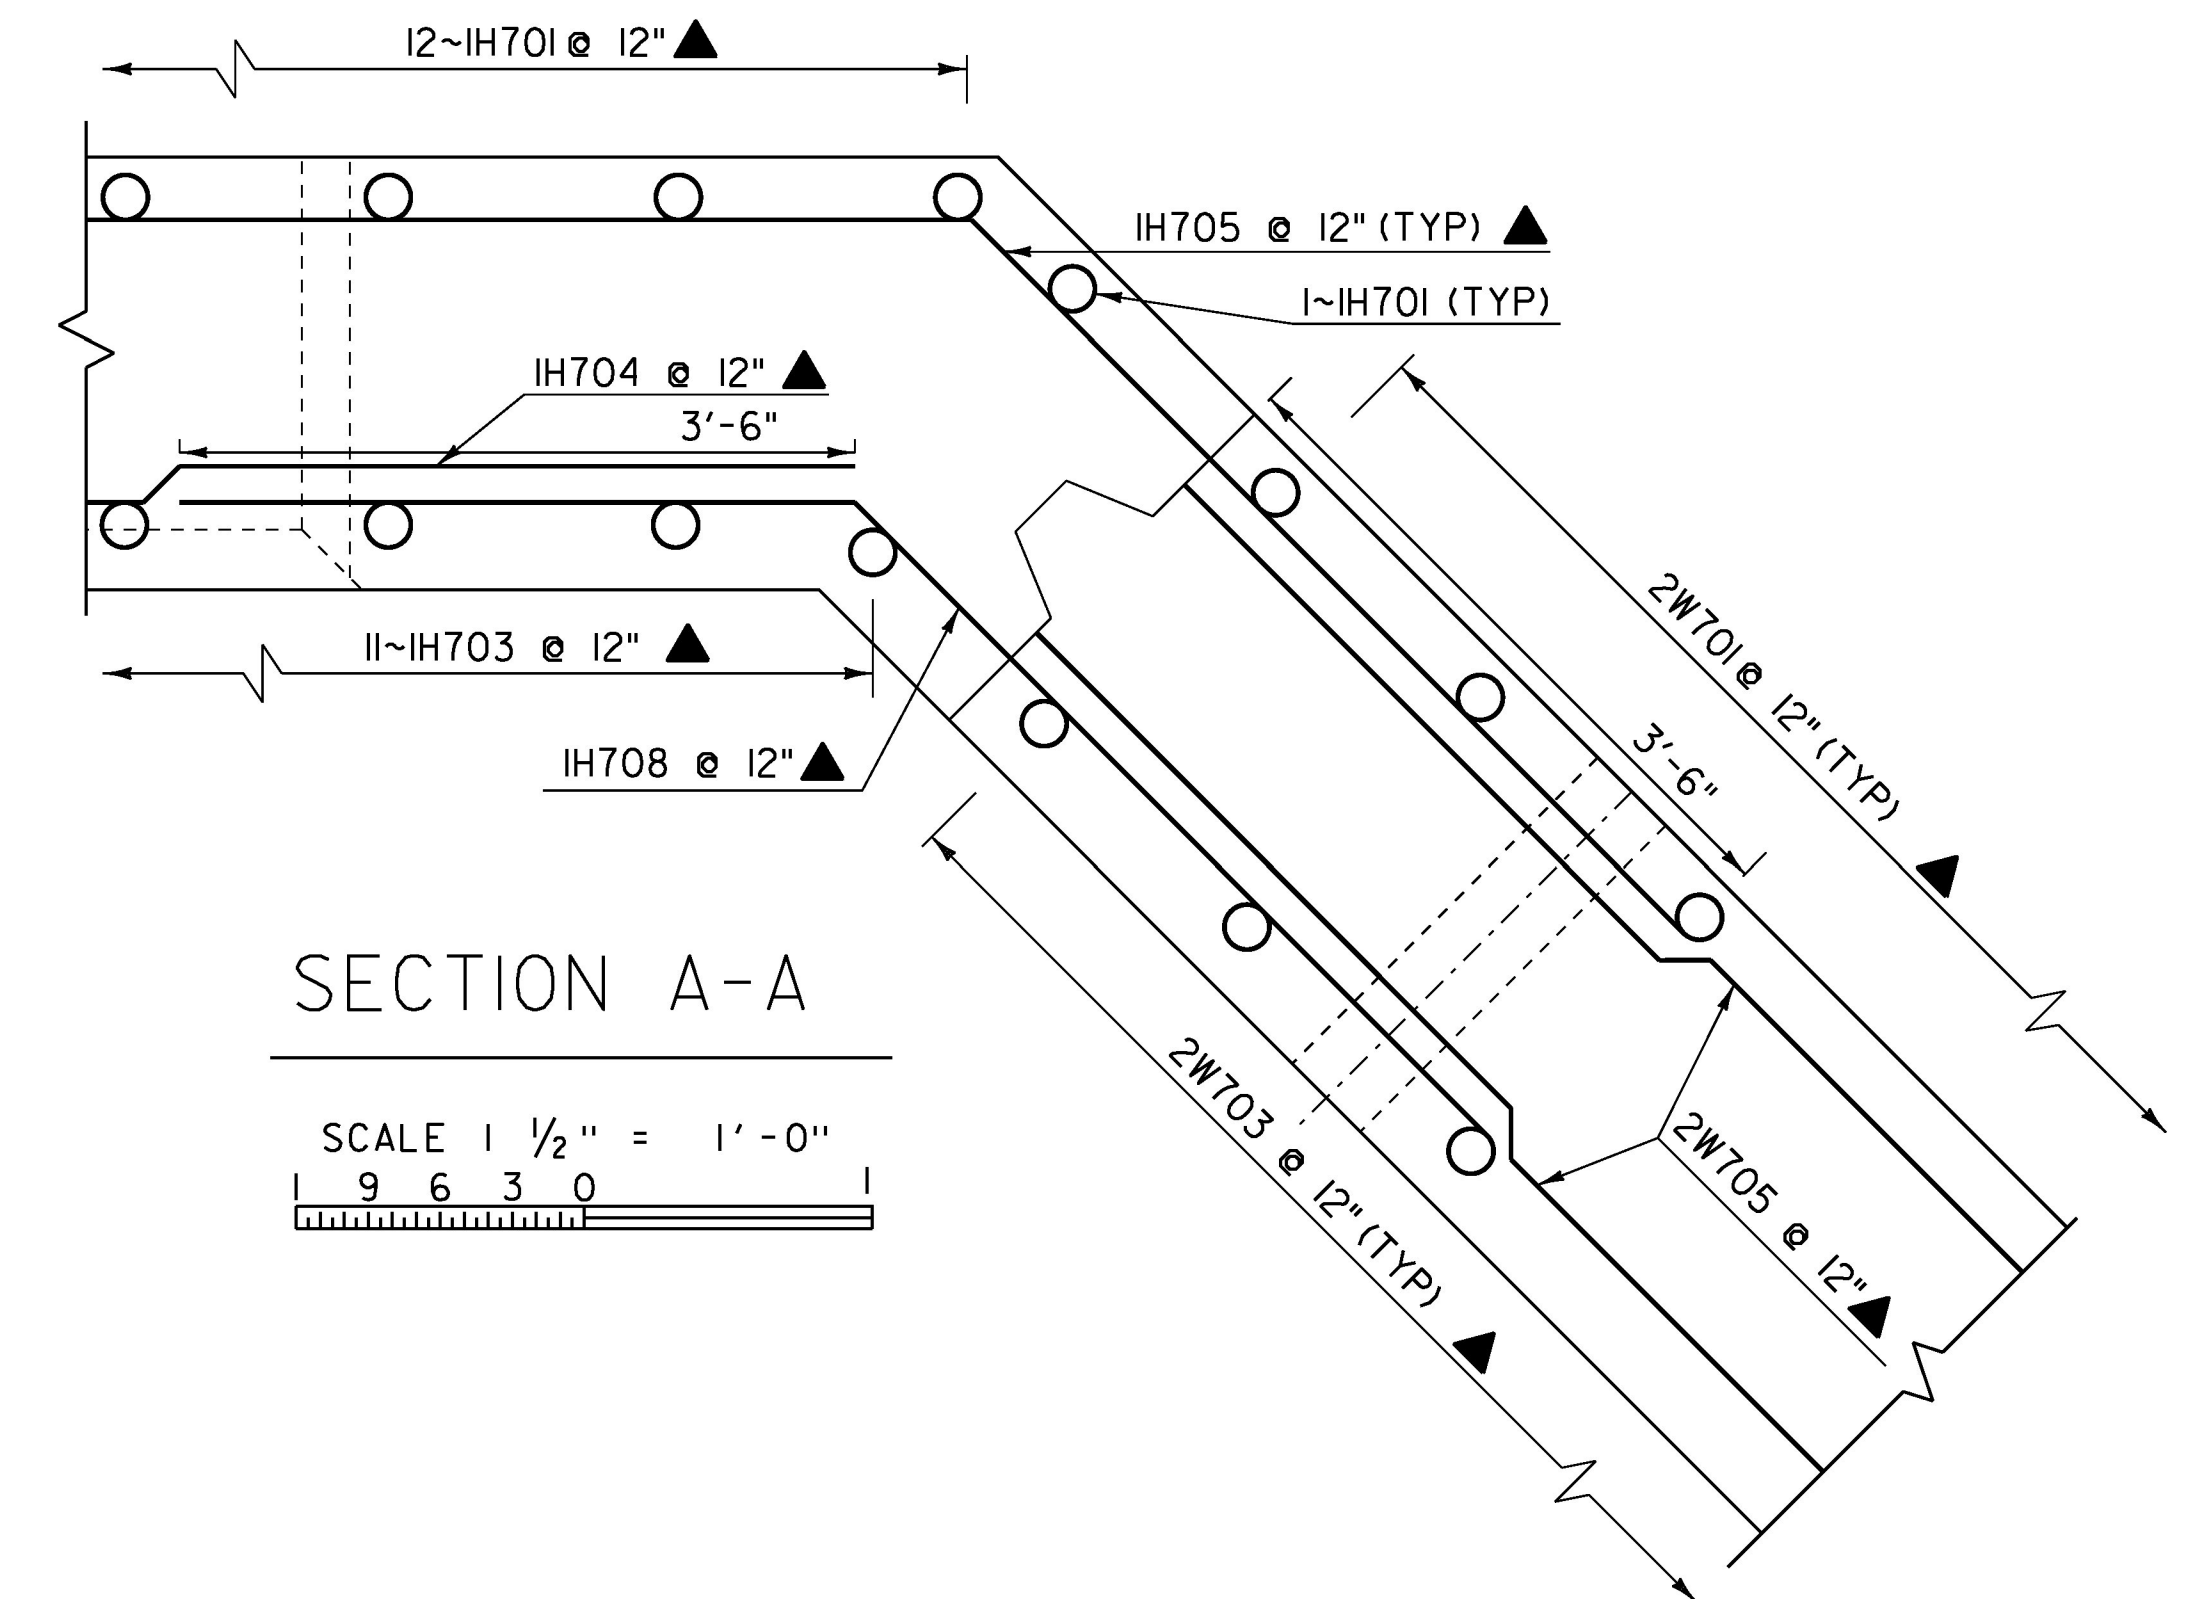

SECTION A-A

SCALE 1 1/2" = 1'-0"

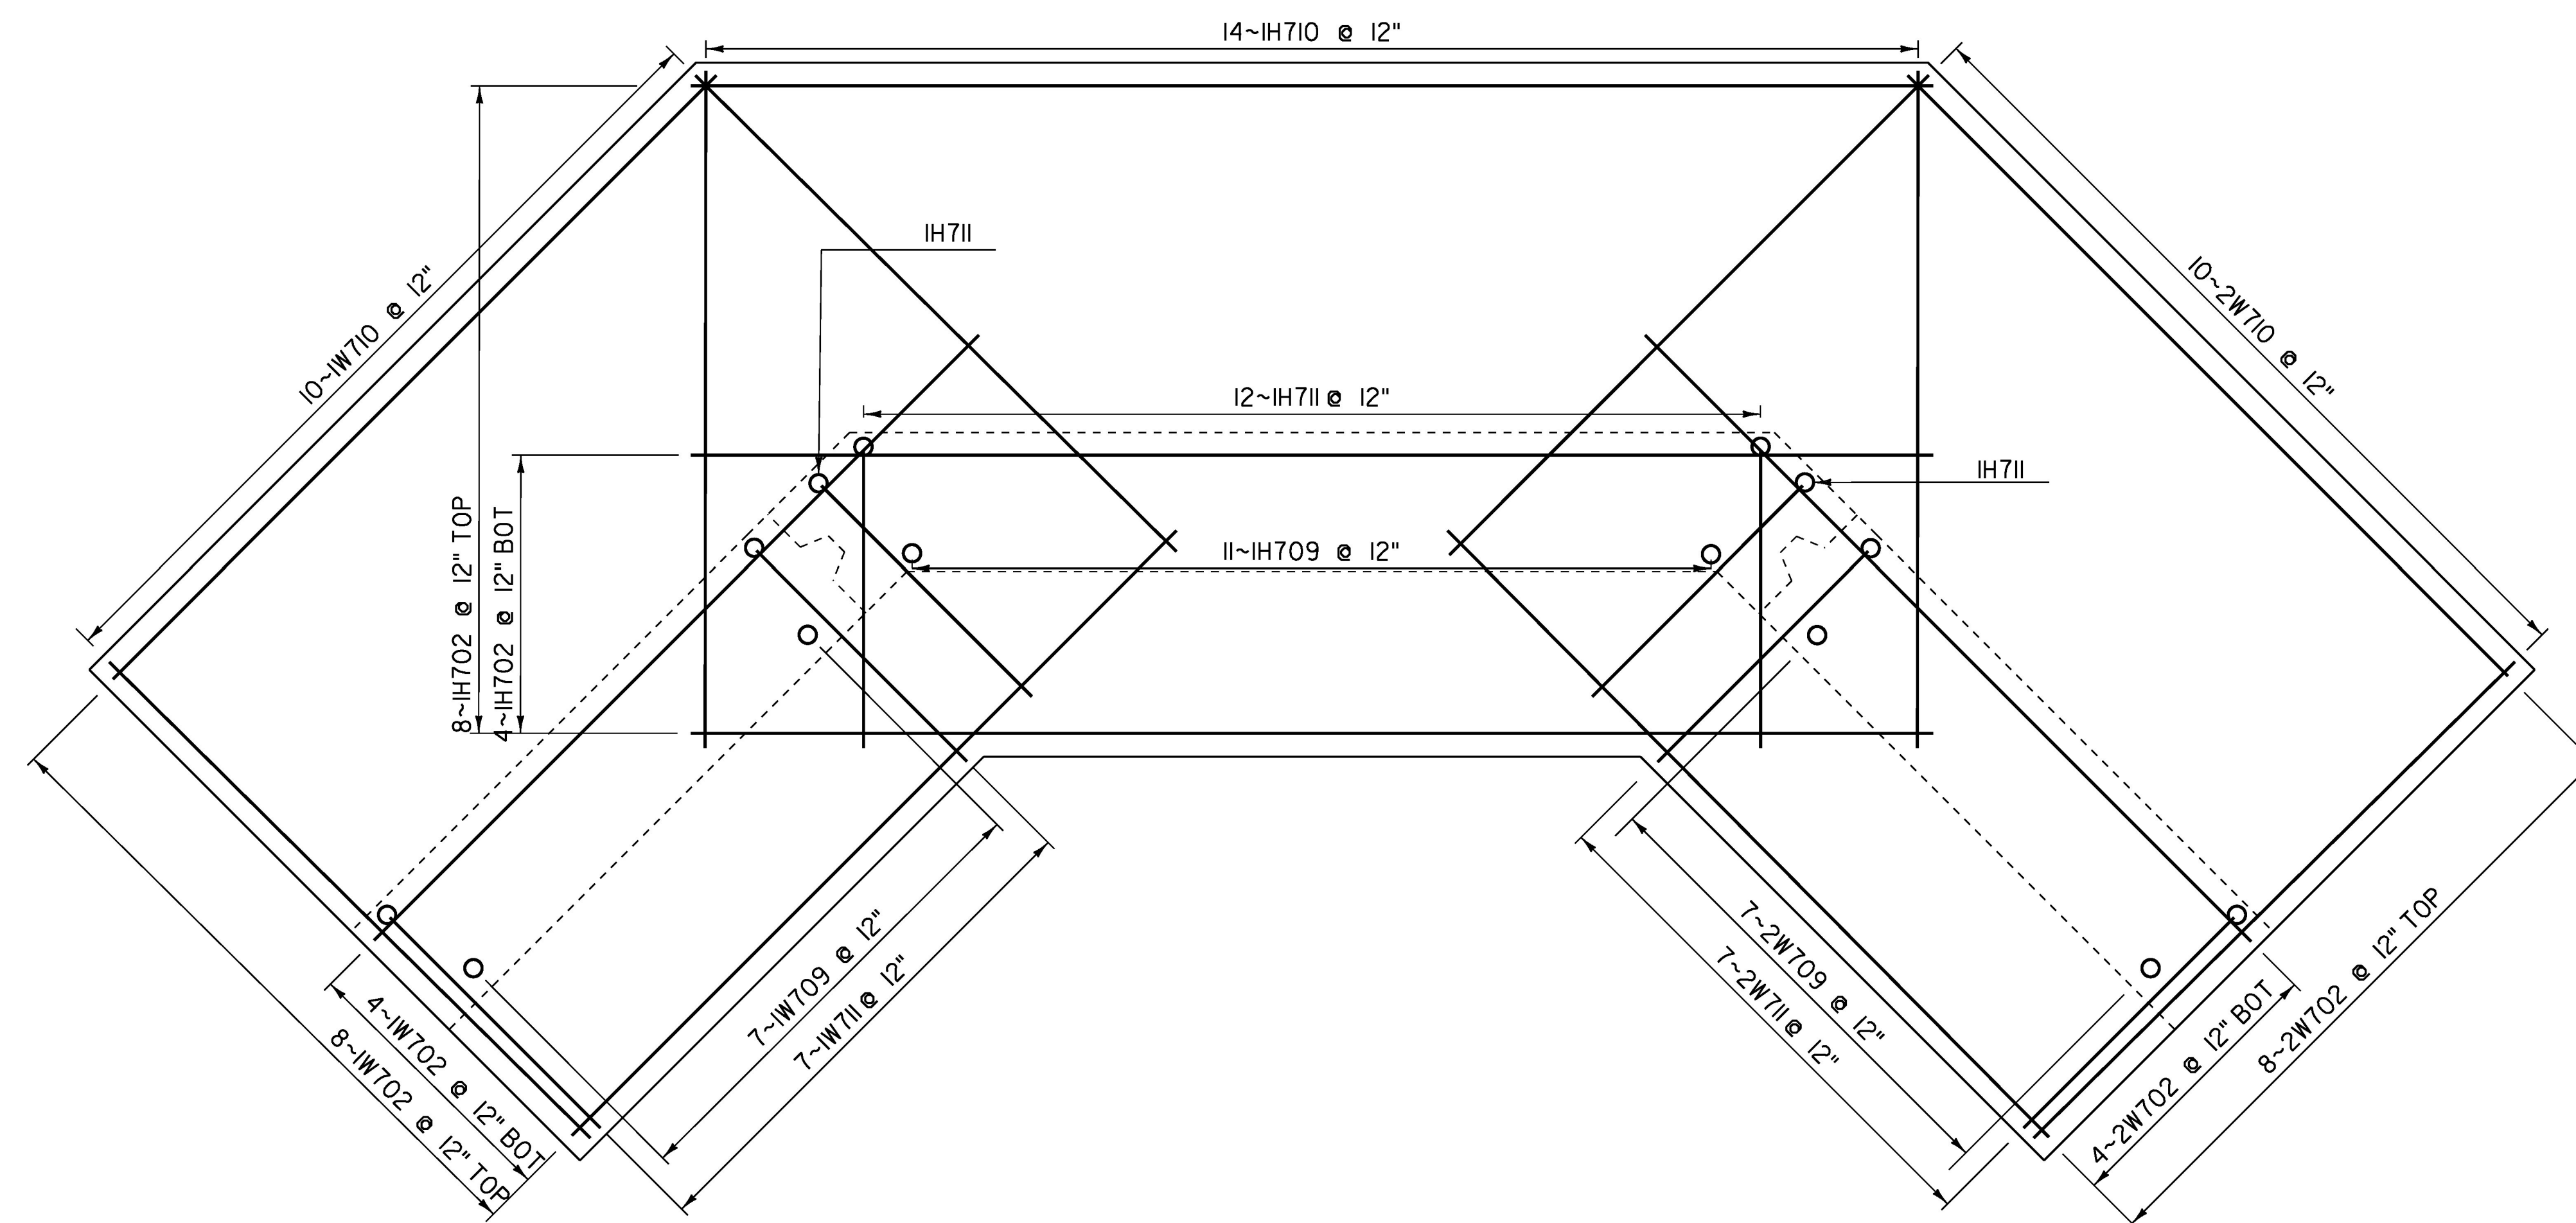

OUTLET FOOTING STEEL

SCALE 3/4" = 1'-0"

NOTE:

NF = NEAR FACE
FF = FAR FACE
EF = EACH FACE
▲ = CUT TO FIT IN FIELD
3" CLR, UNLESS OTHERWISE
SPECIFIED ON THE PLANS.

PROJECT NAME: CHARLOTTE	
PROJECT NUMBER: F EGC 019-4(20)	
FILE NAME: d78d062.typ.dgn	PLOT DATE: 15-MAR-2016
PROJECT LEADER: K. UPMAL	DRAWN BY: A. KEMPTON
DESIGNED BY: A. KEMPTON	CHECKED BY: C. LEACH
STA 40+42 OUTLET FOOTING DETAILS SHEET SHEET 238 OF 499	