




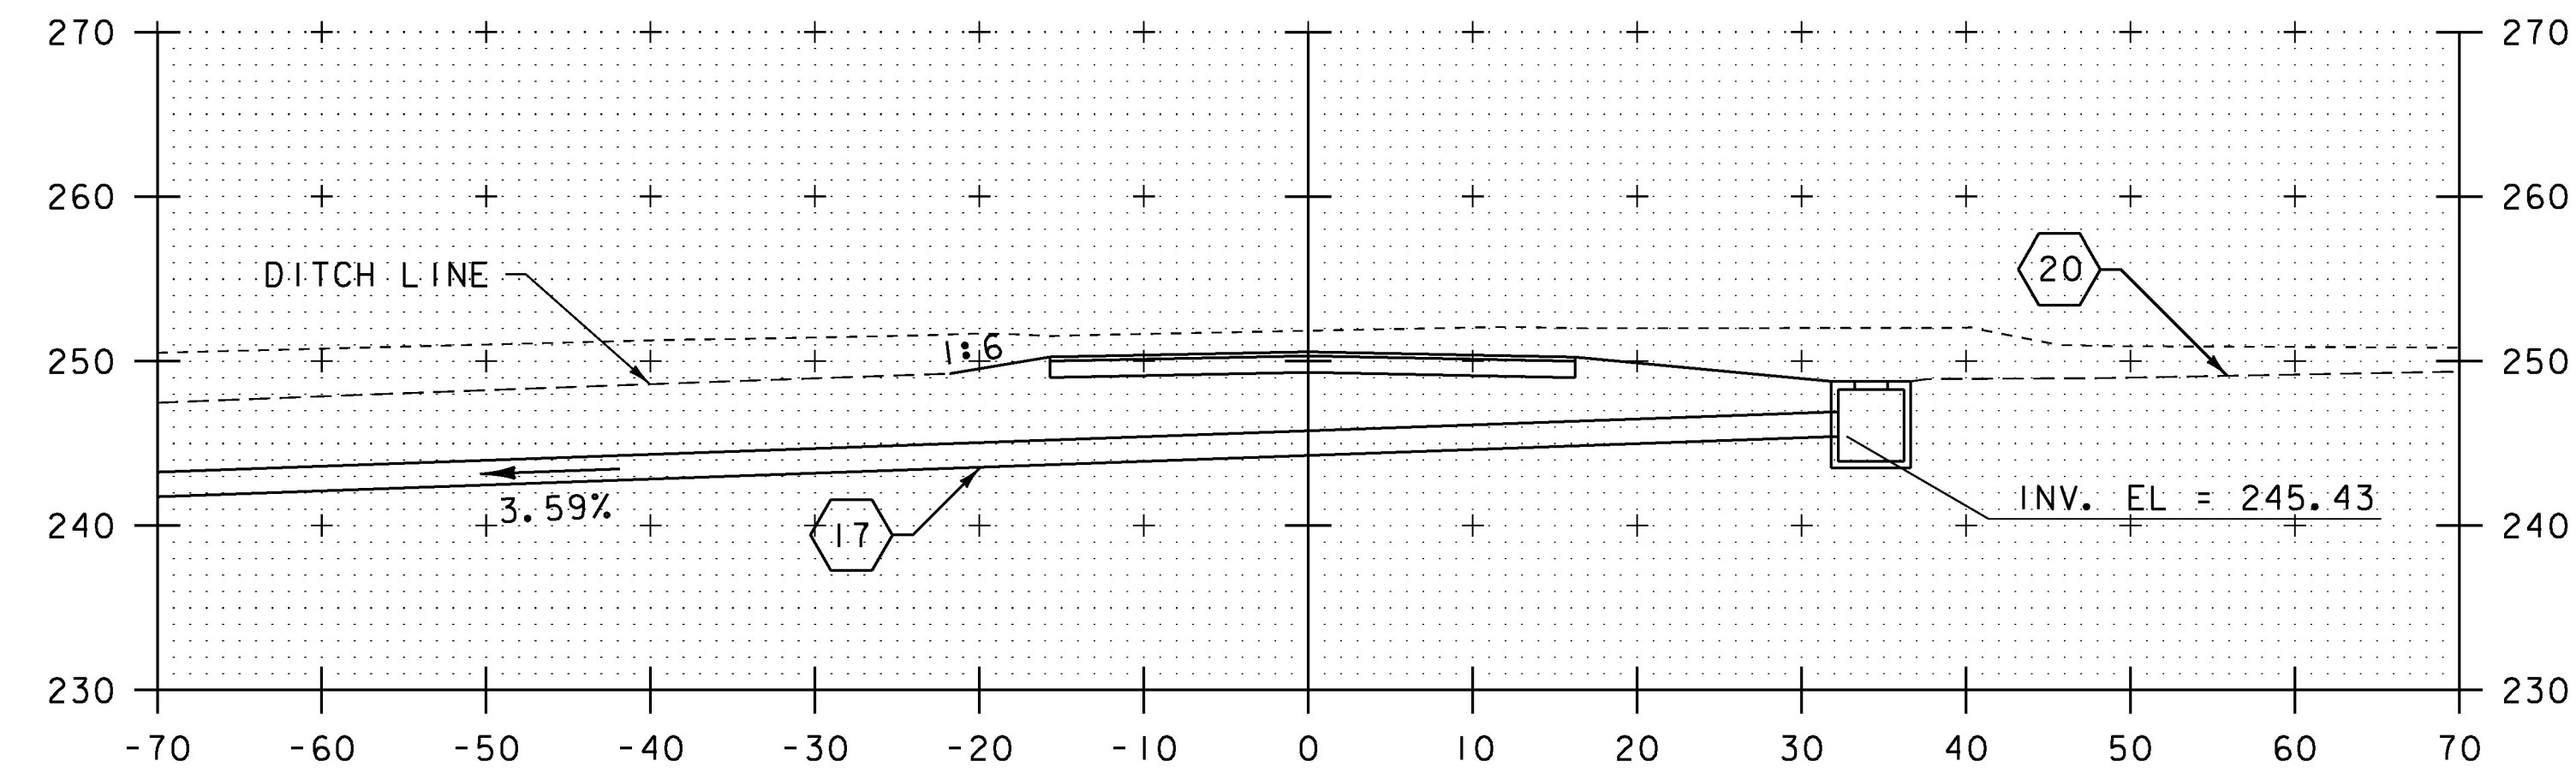


49+66 DRIVE LT SECTION A-A

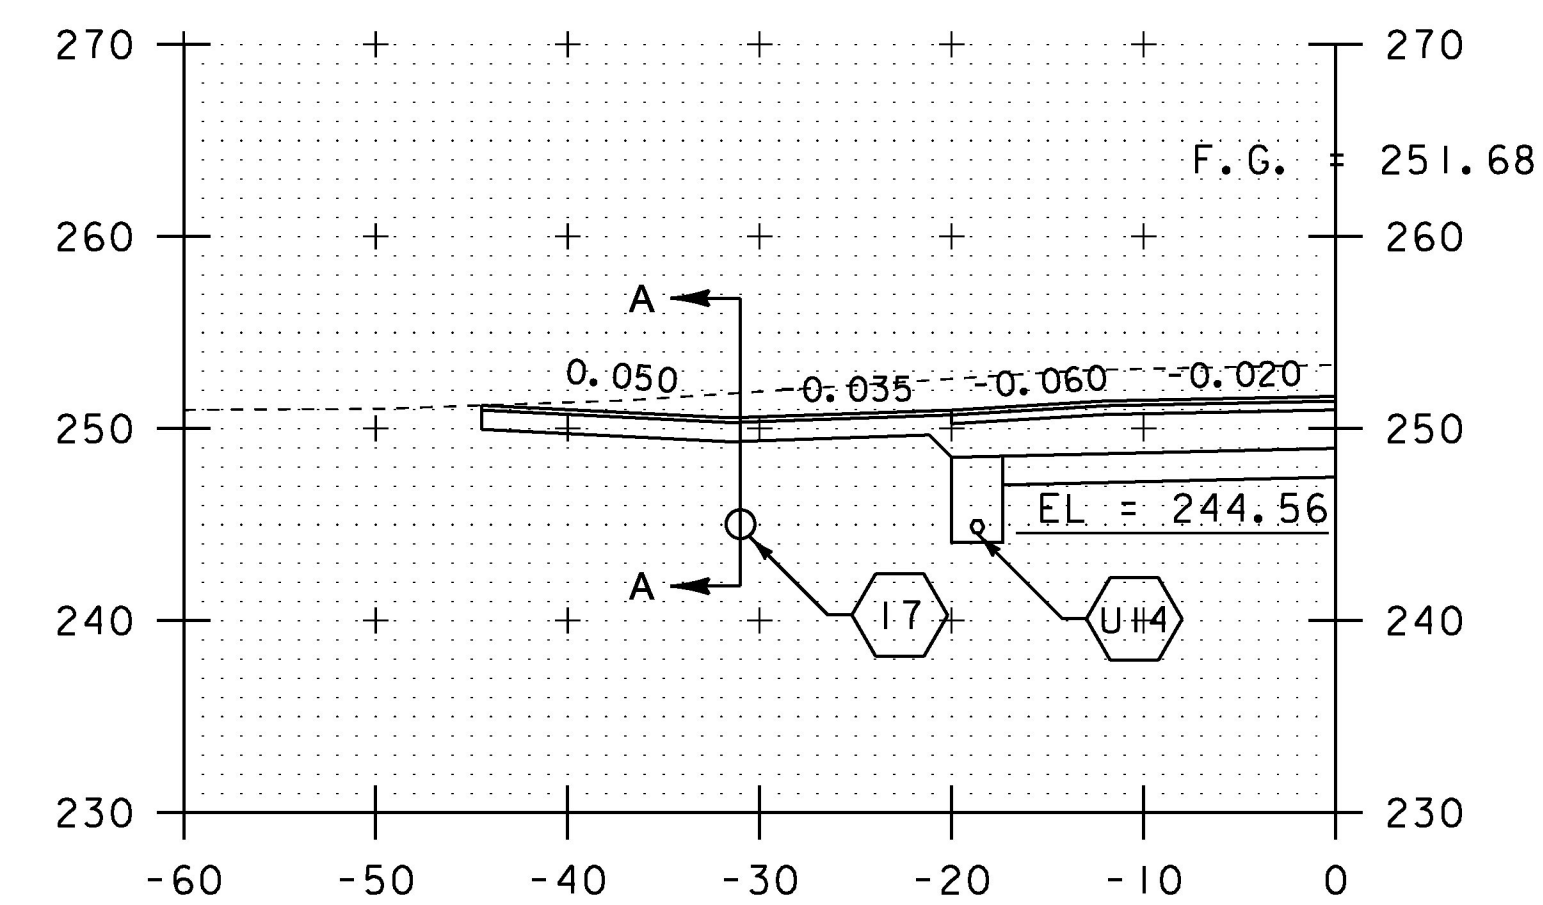


49+66 DRIVE LT

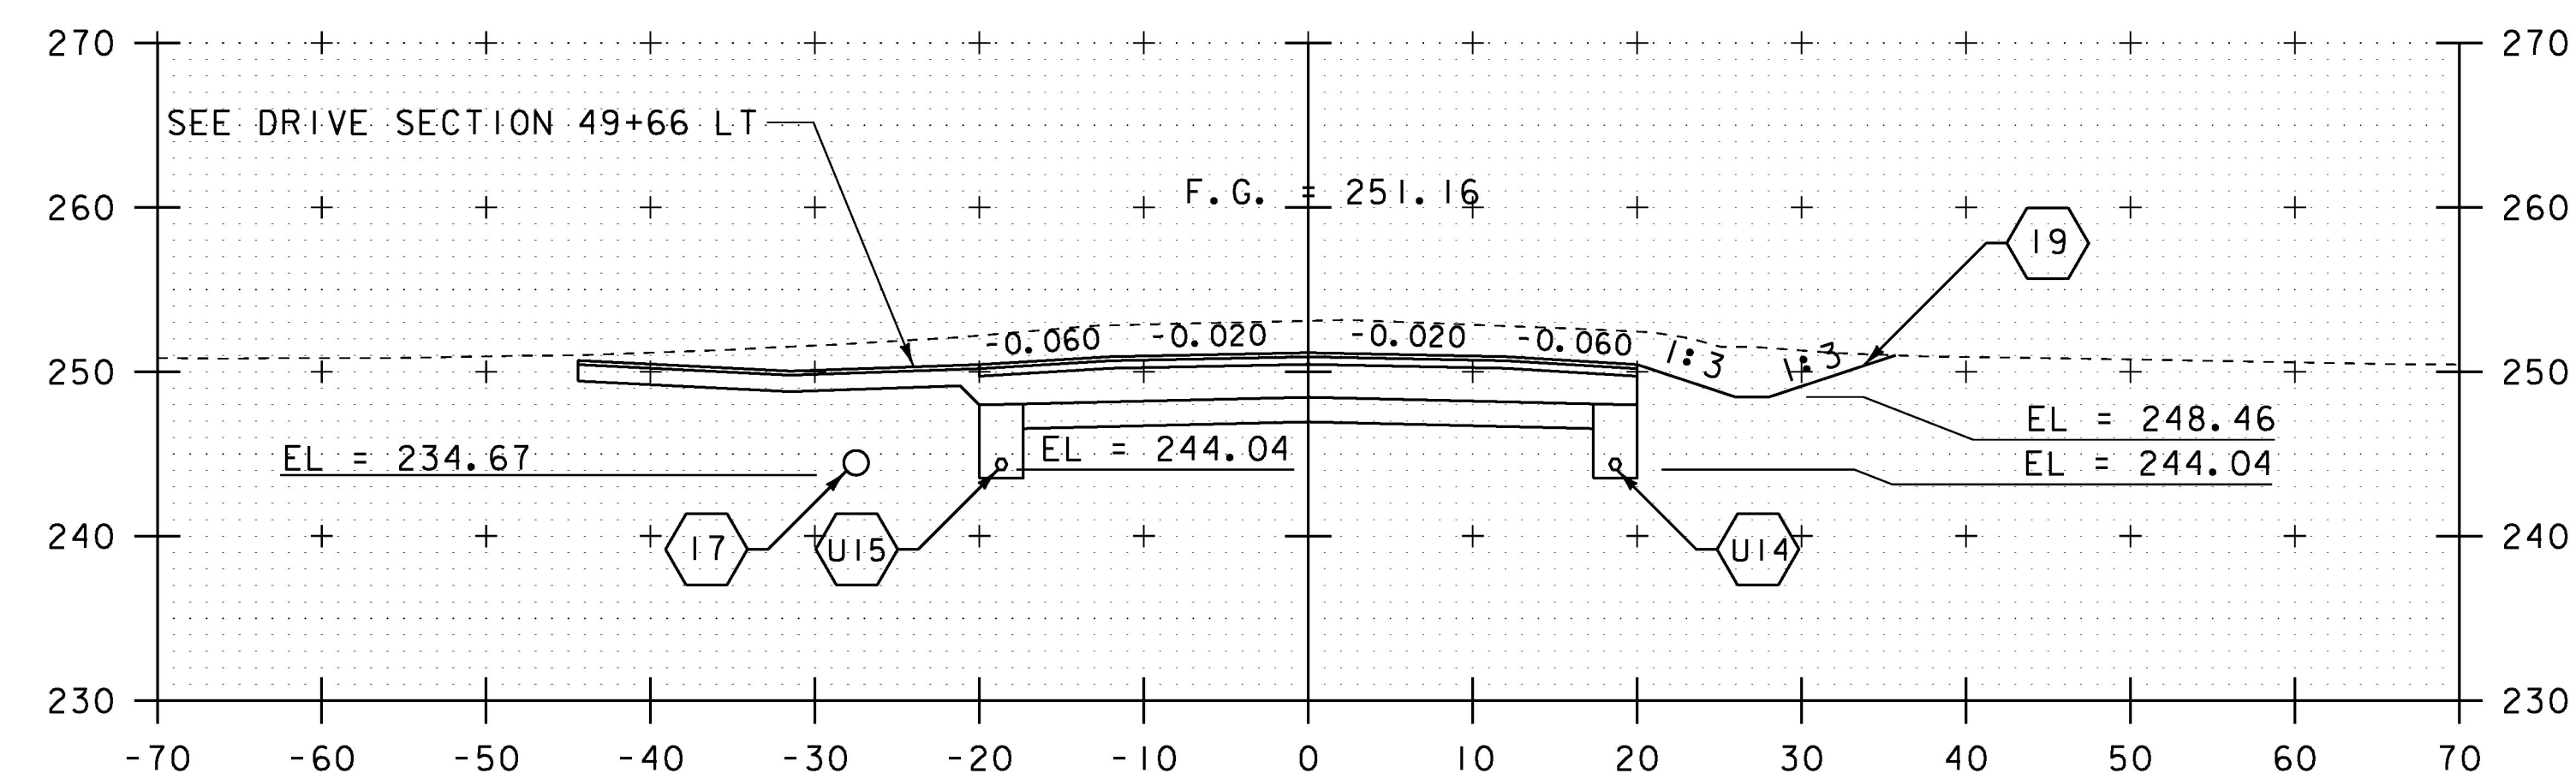


49+50

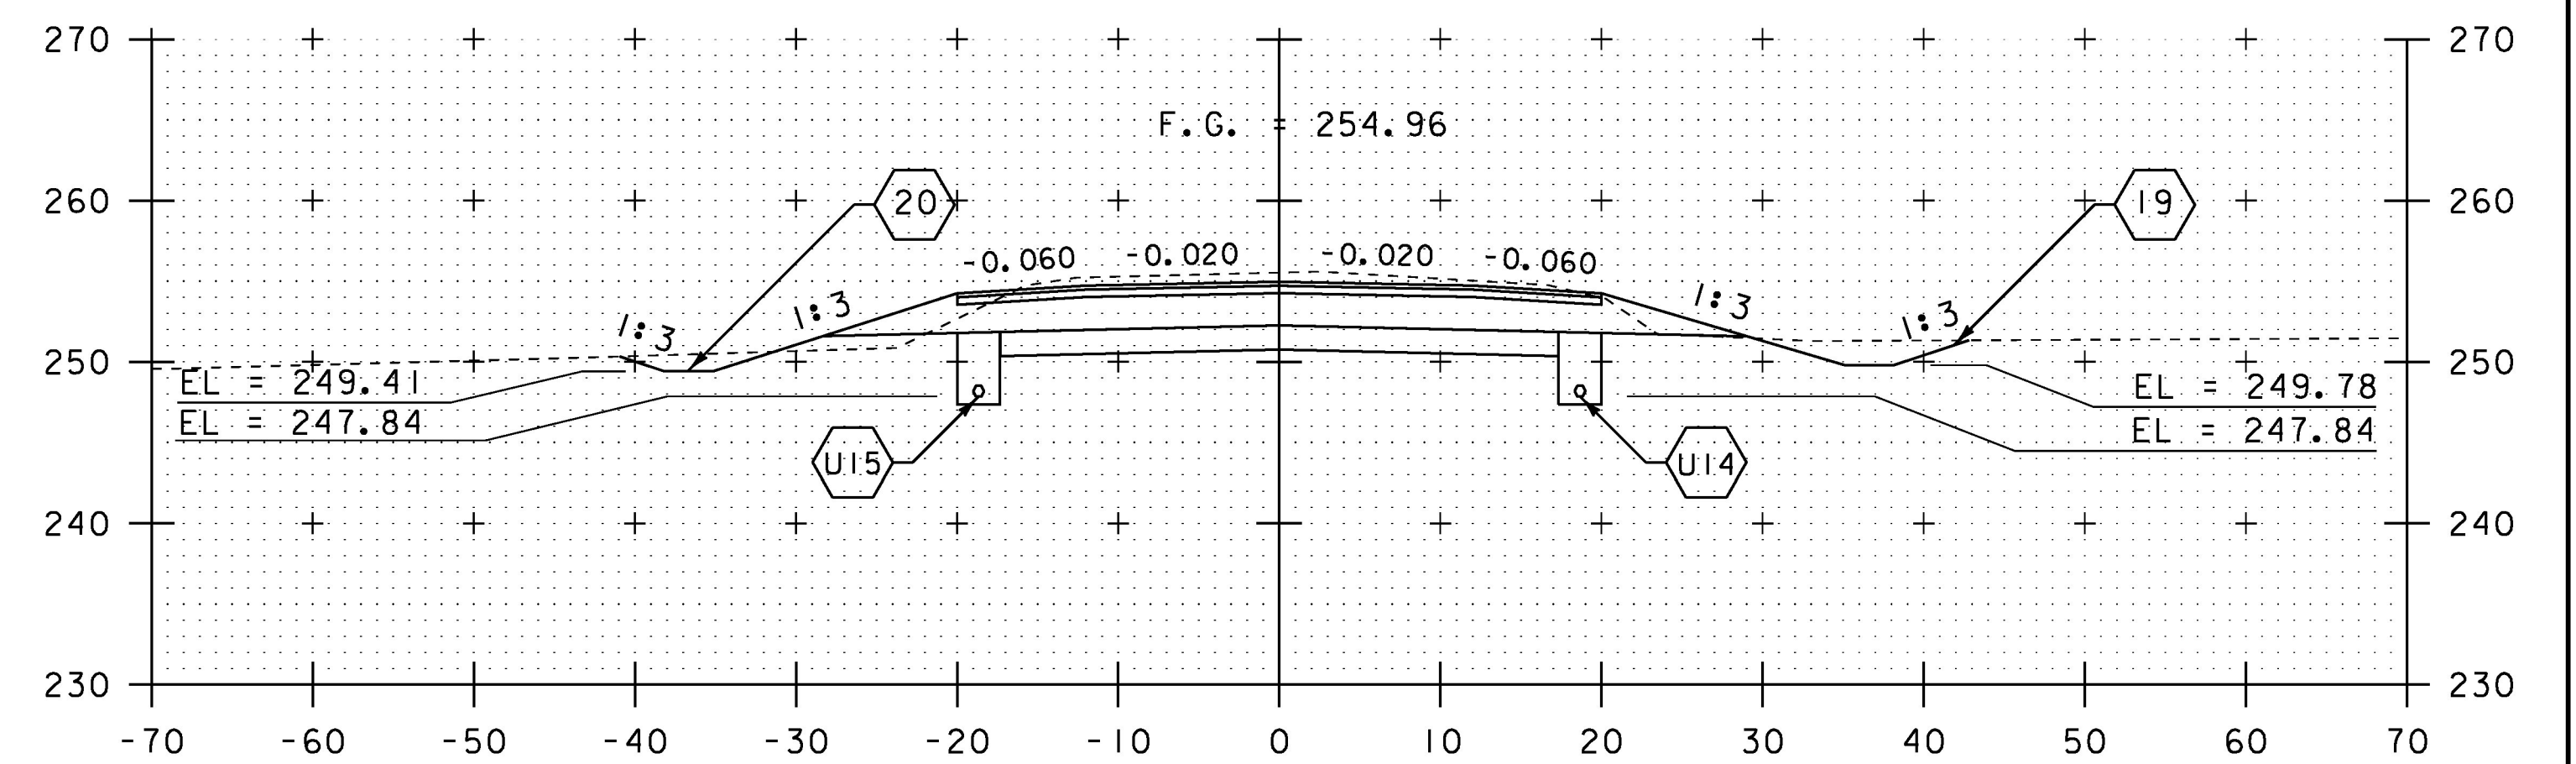

51+00

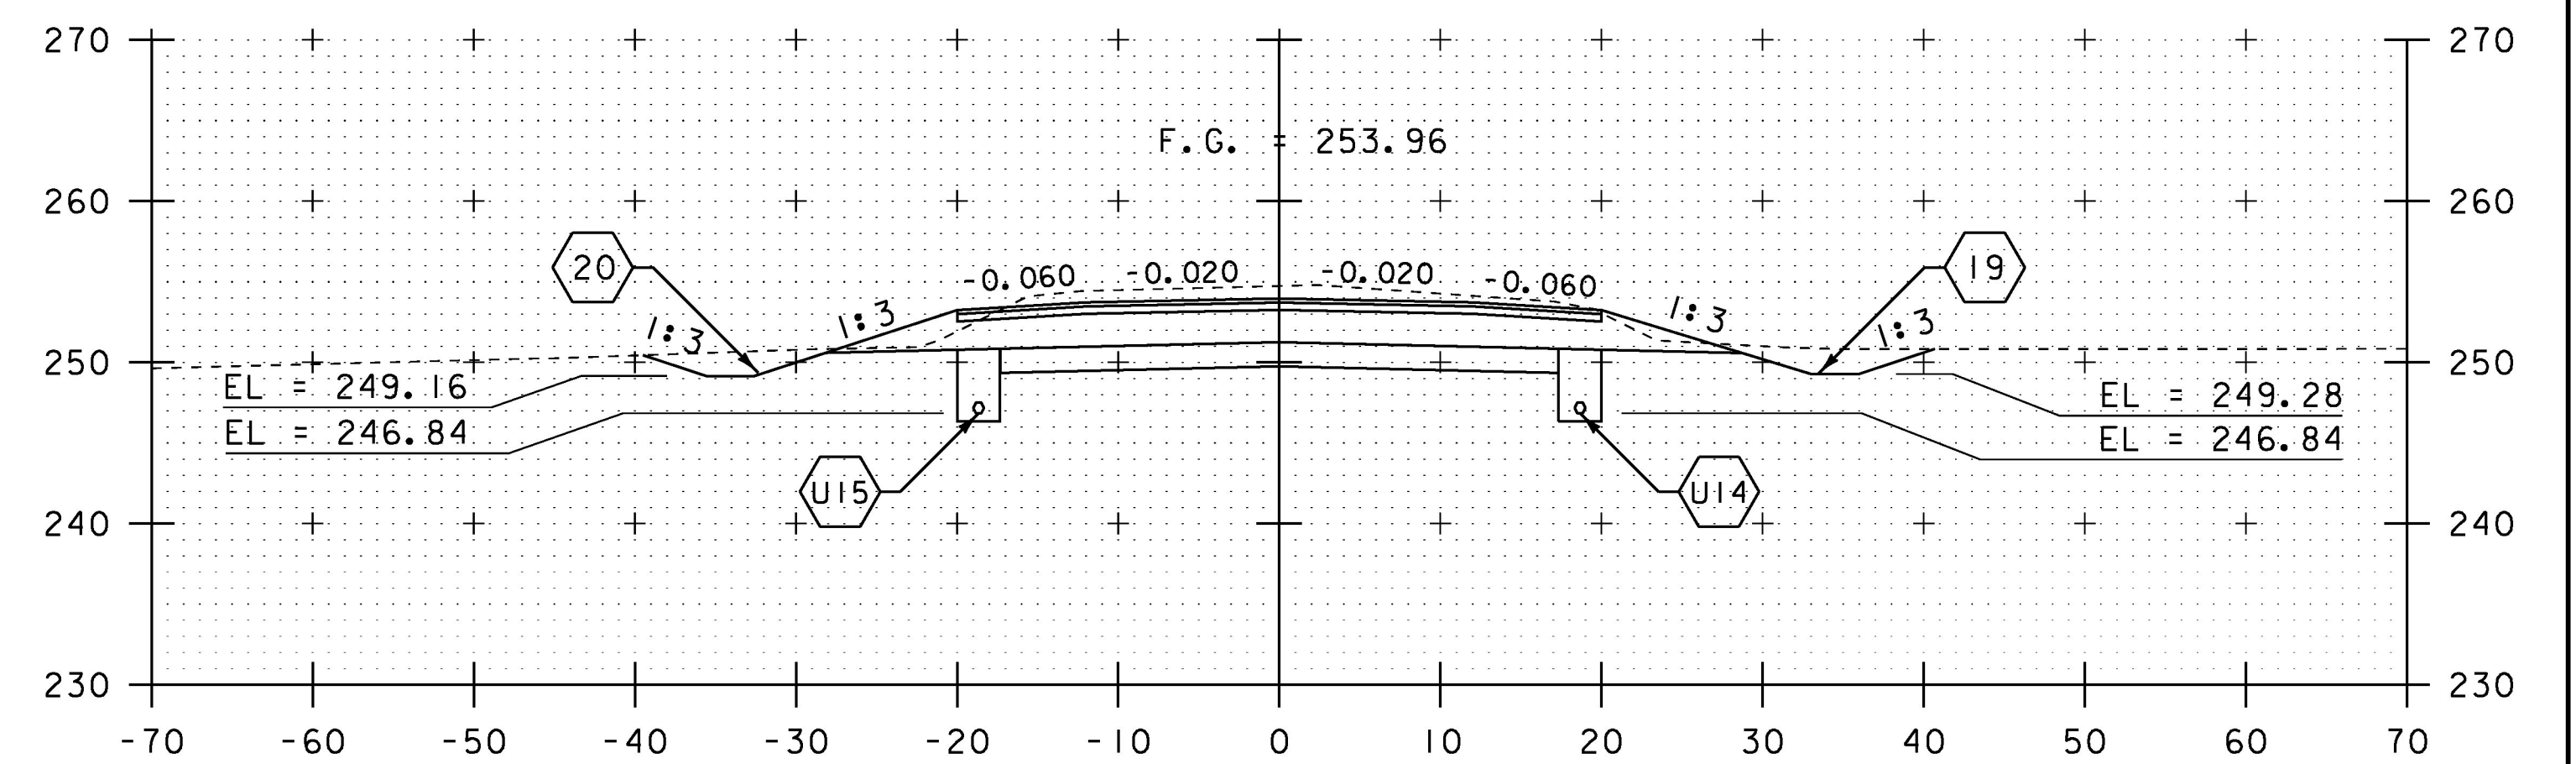

50+50

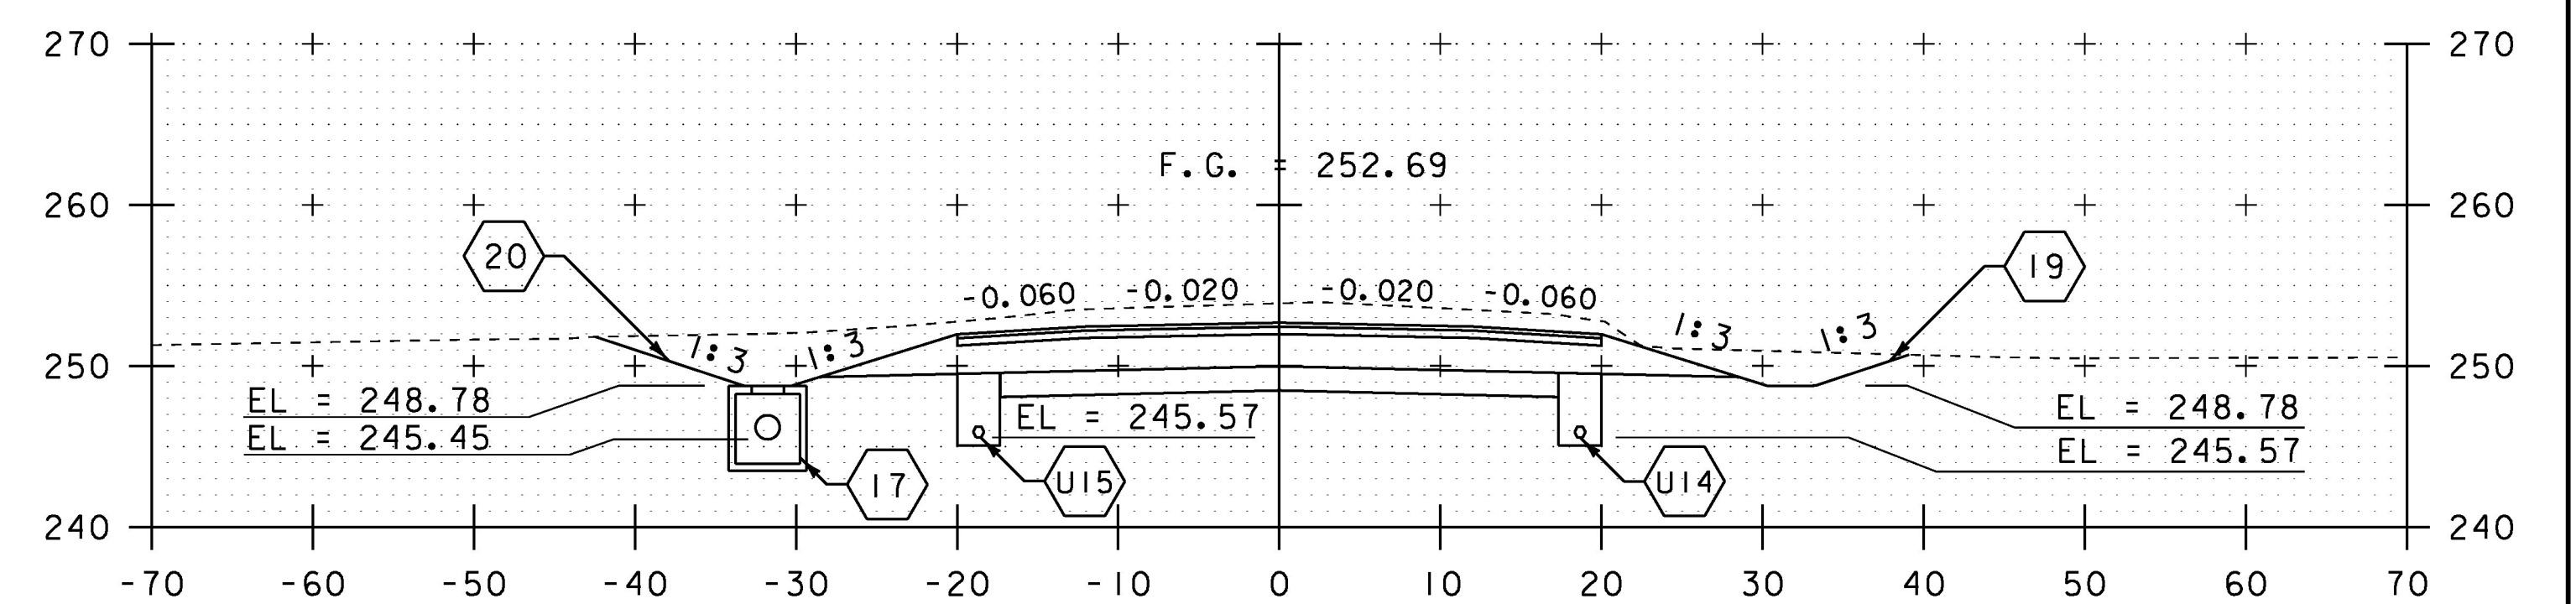

50+00

SCALE IN FEET

STA. 49+50 TO STA. 51+00

PROJECT NAME: CHARLOTTE	
PROJECT NUMBER: F EGC 019-4(20)	
FILE NAME: d78d062_xs.dgn	PLOT DATE: 15-MAR-2016
PROJECT LEADER: K. UPMAL	DRAWN BY: B. KIPP
DESIGNED BY: B. KIPP	CHECKED BY: C. LEACH
MAINLINE CROSS SECTIONS 25	SHEET 302 OF 499