




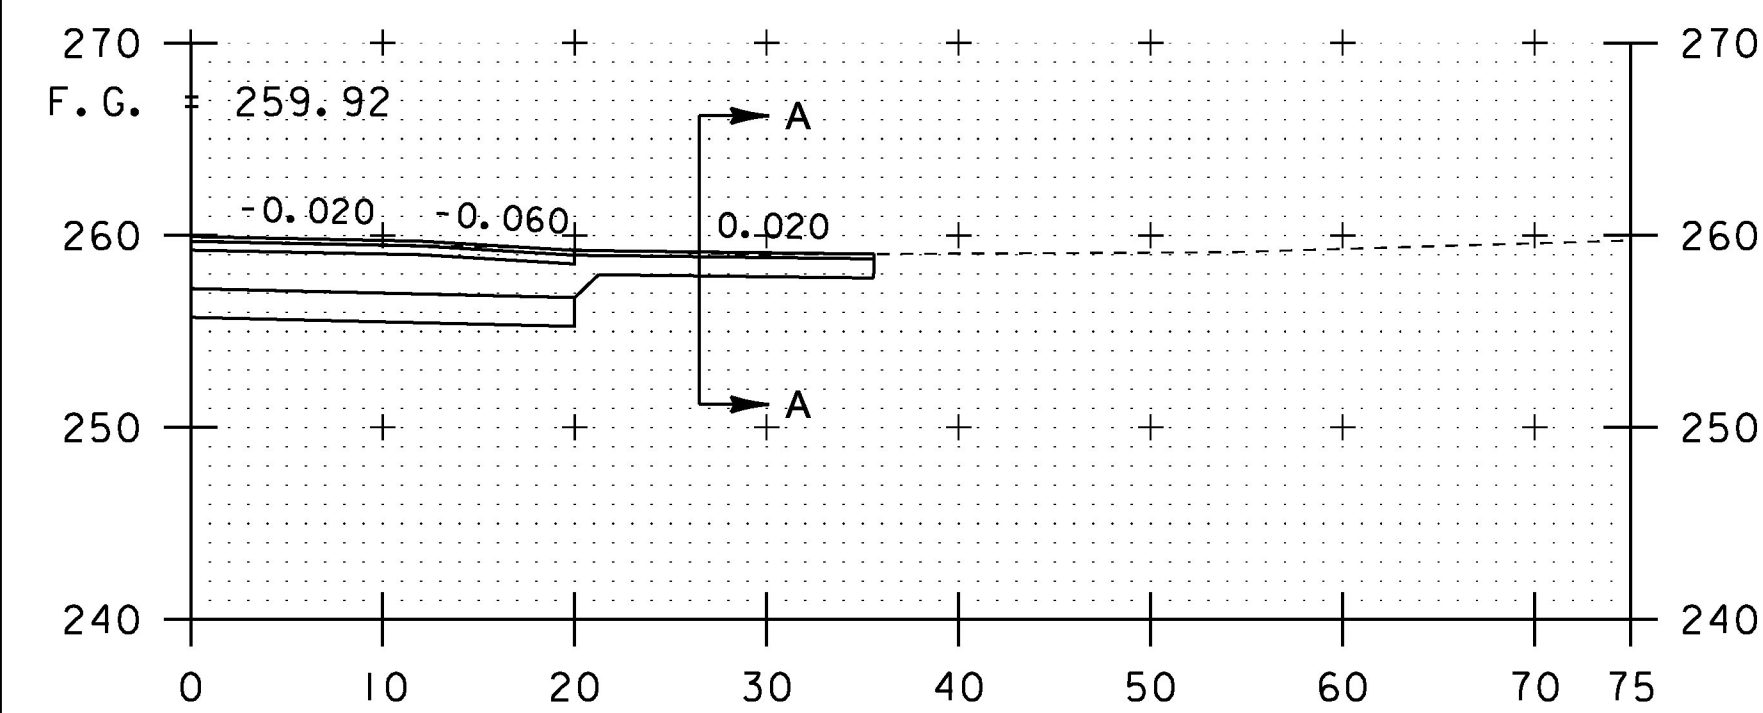


55+06 DRIVE RT

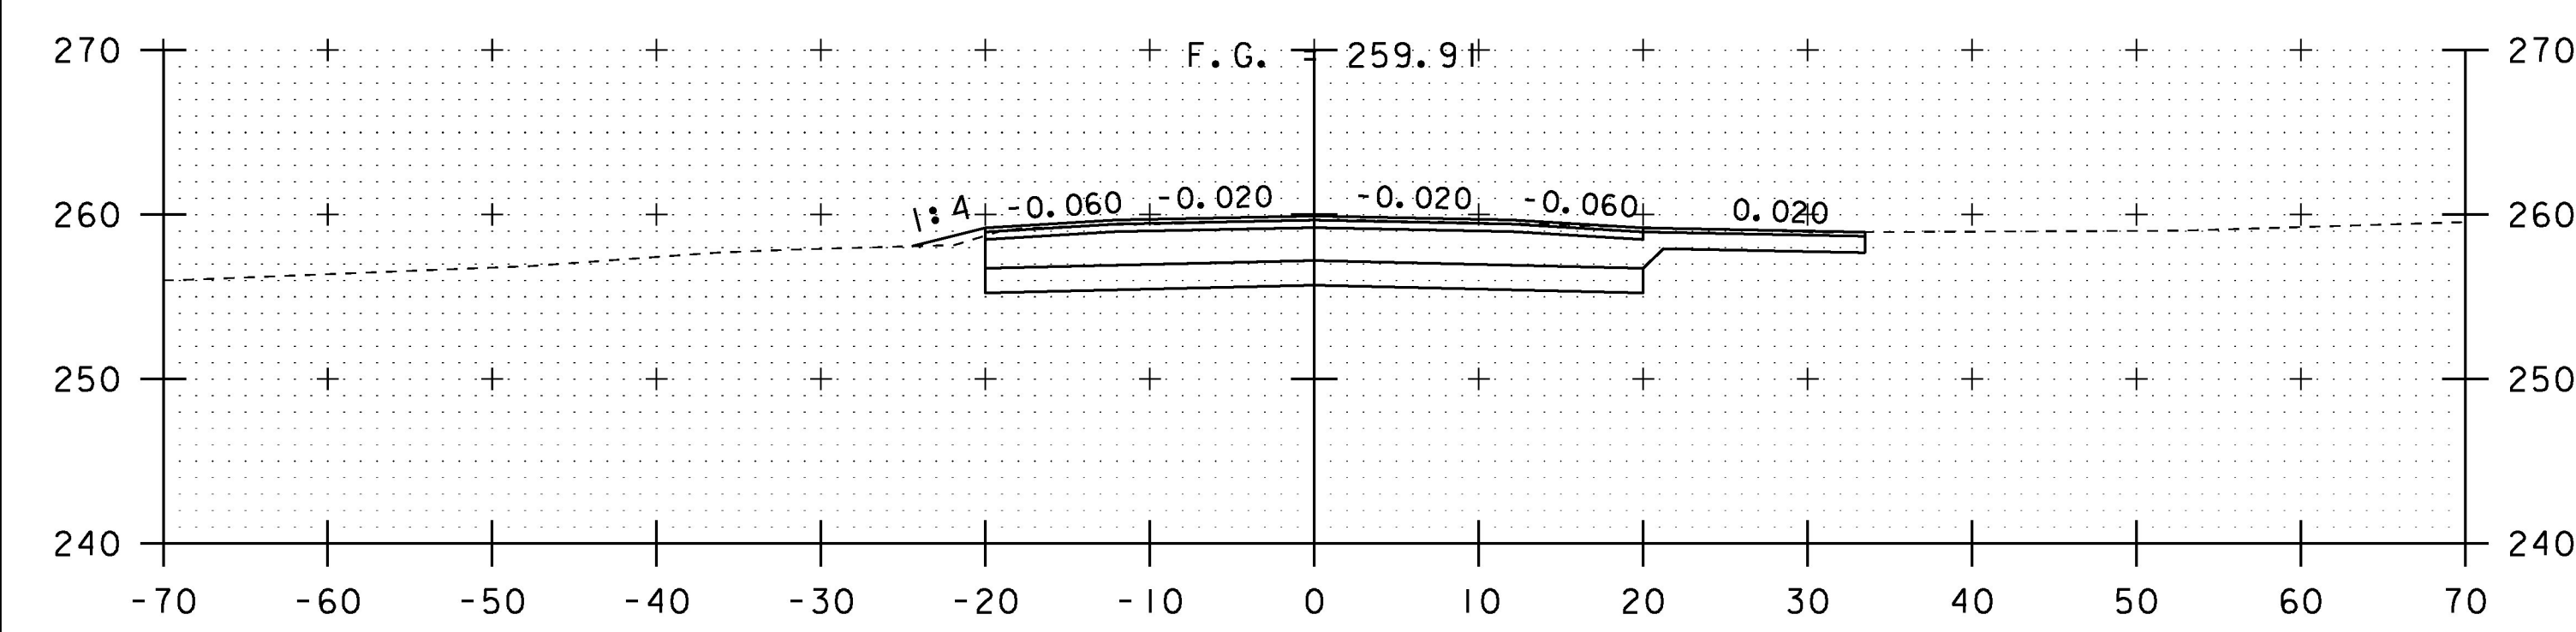


55+00

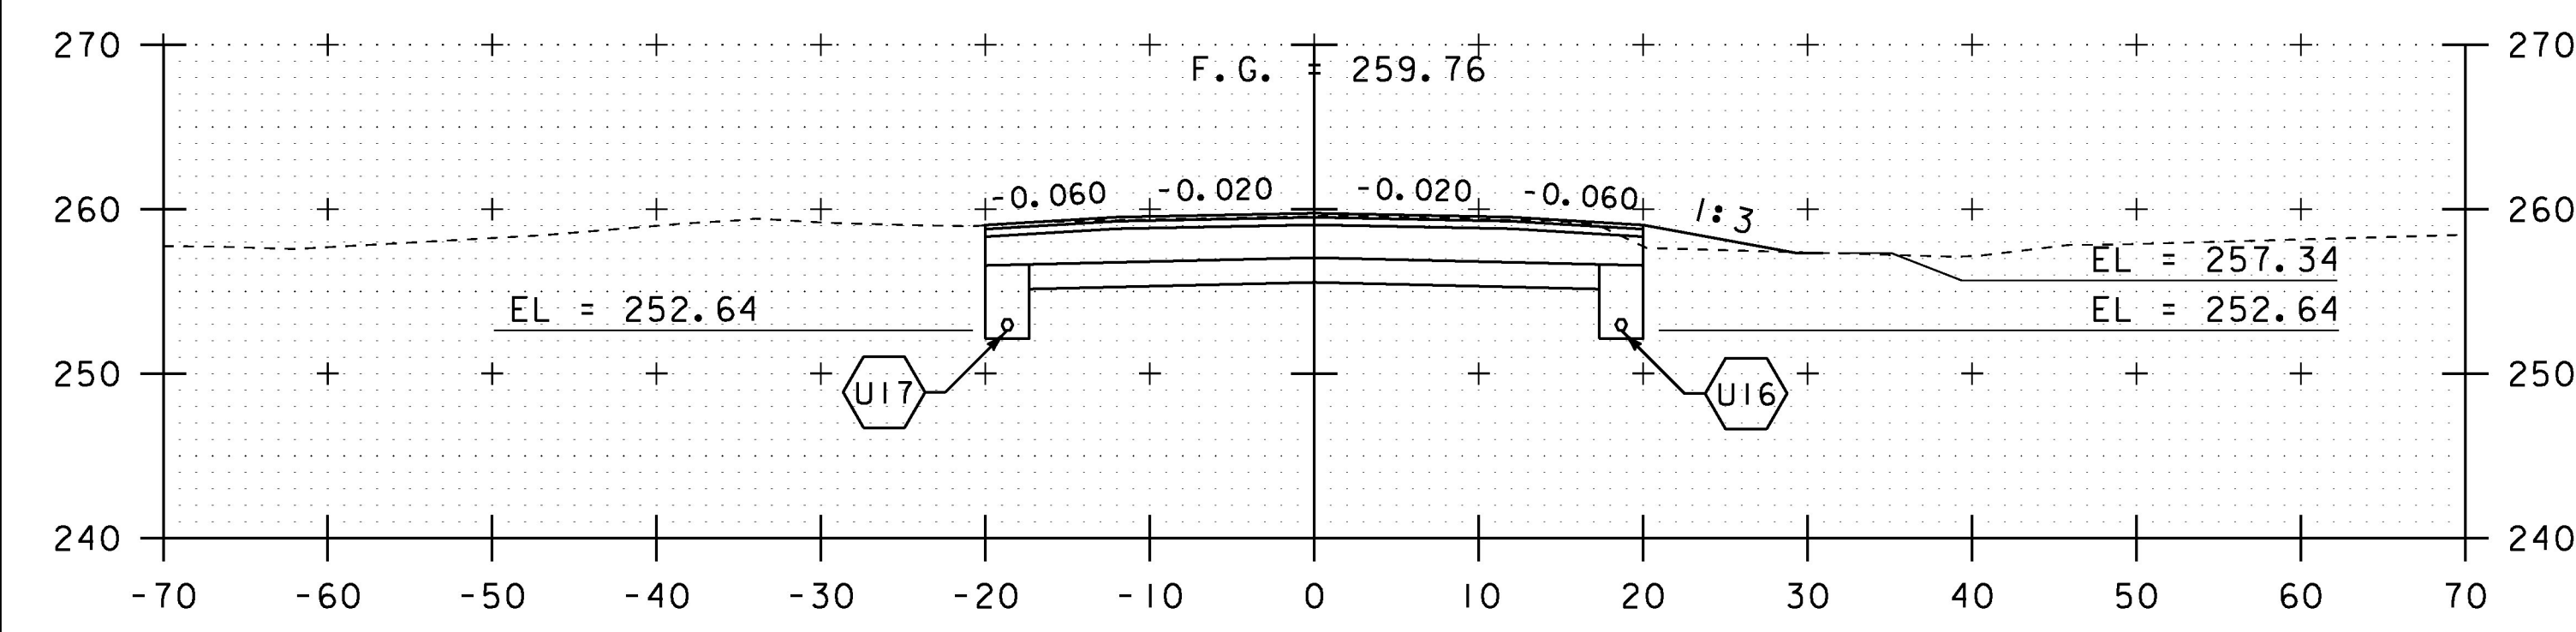


54+50

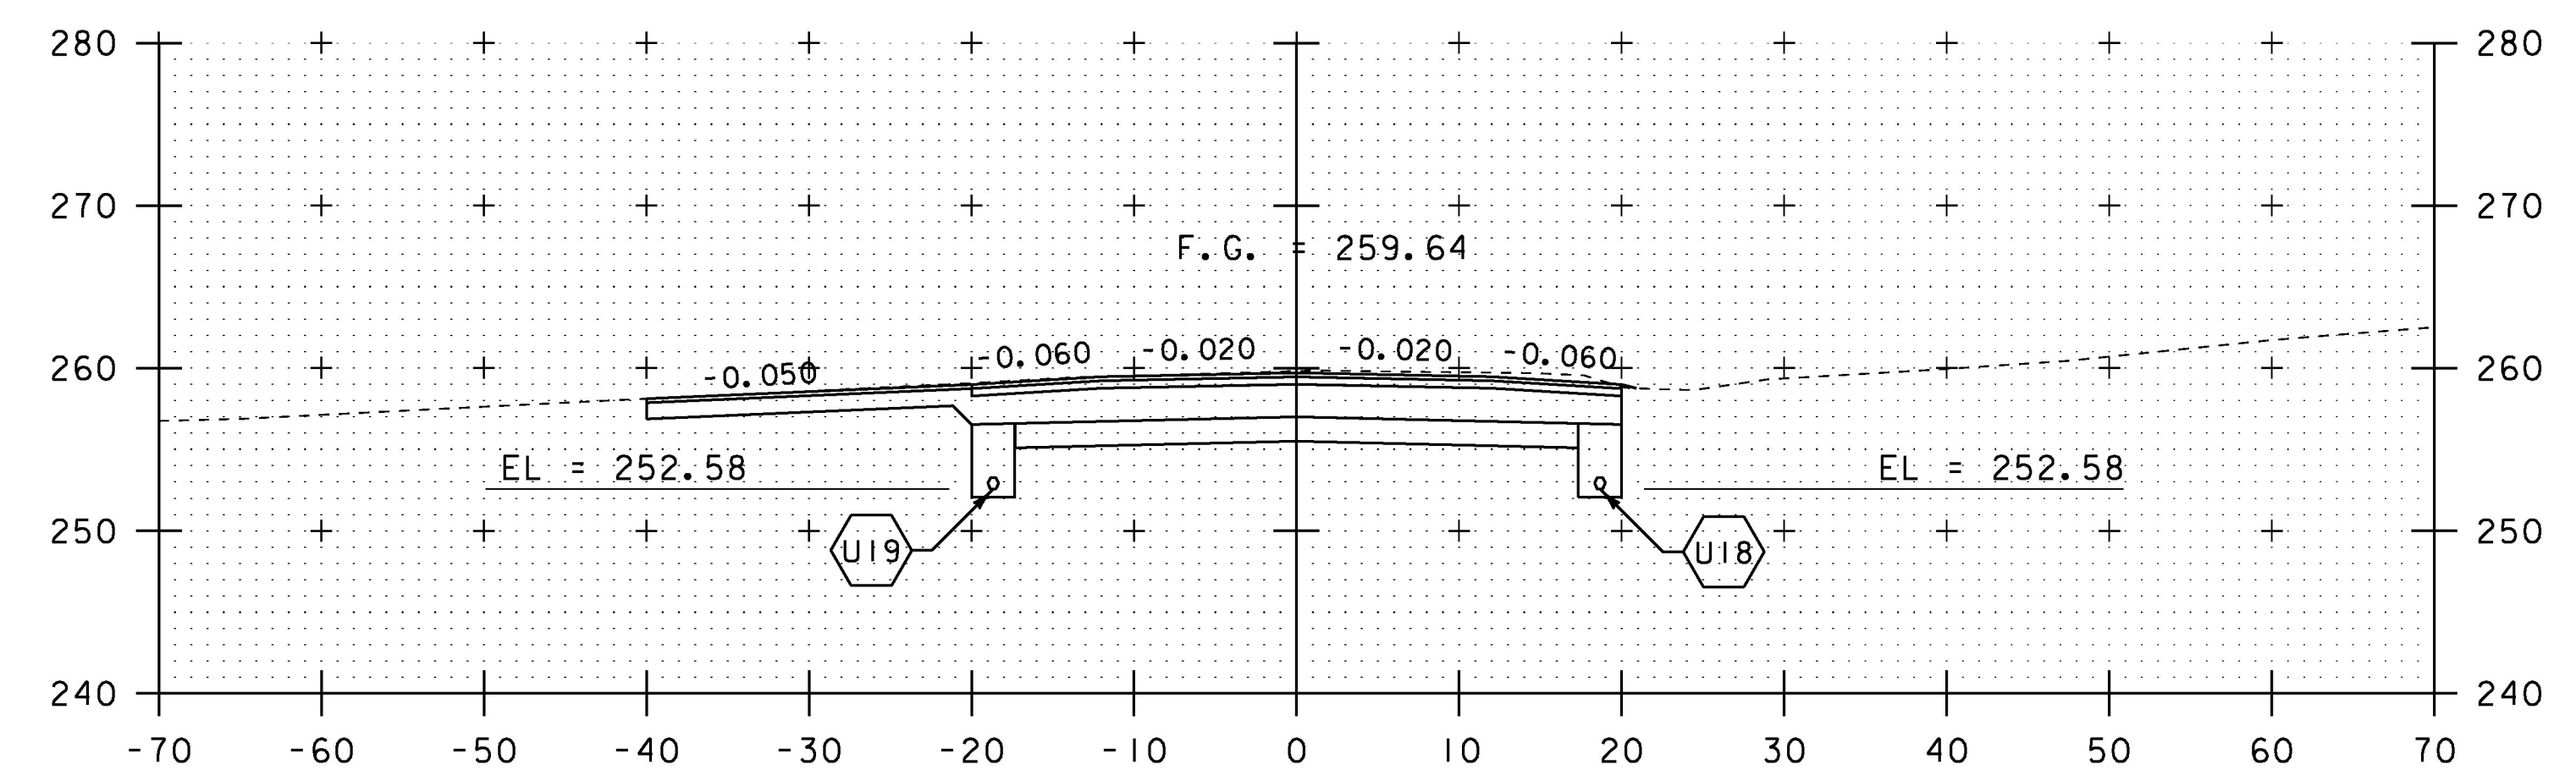

56+00

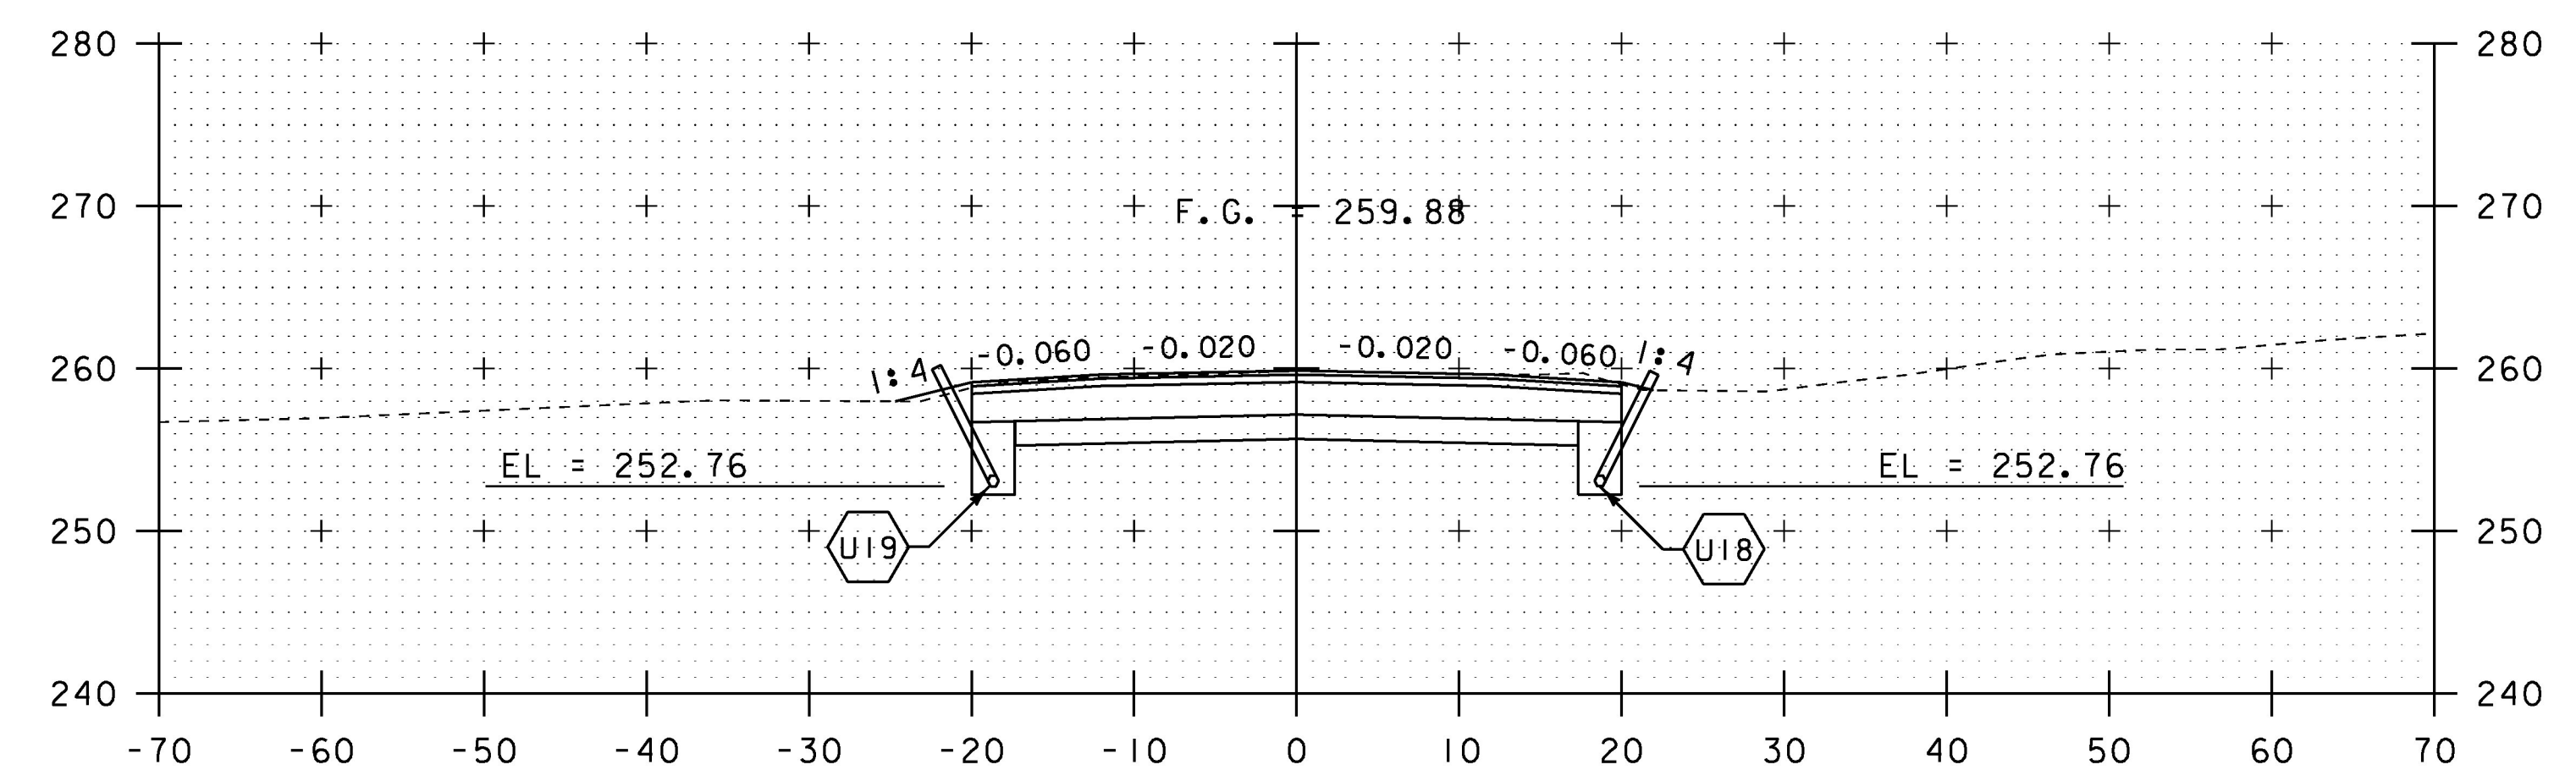

55+50

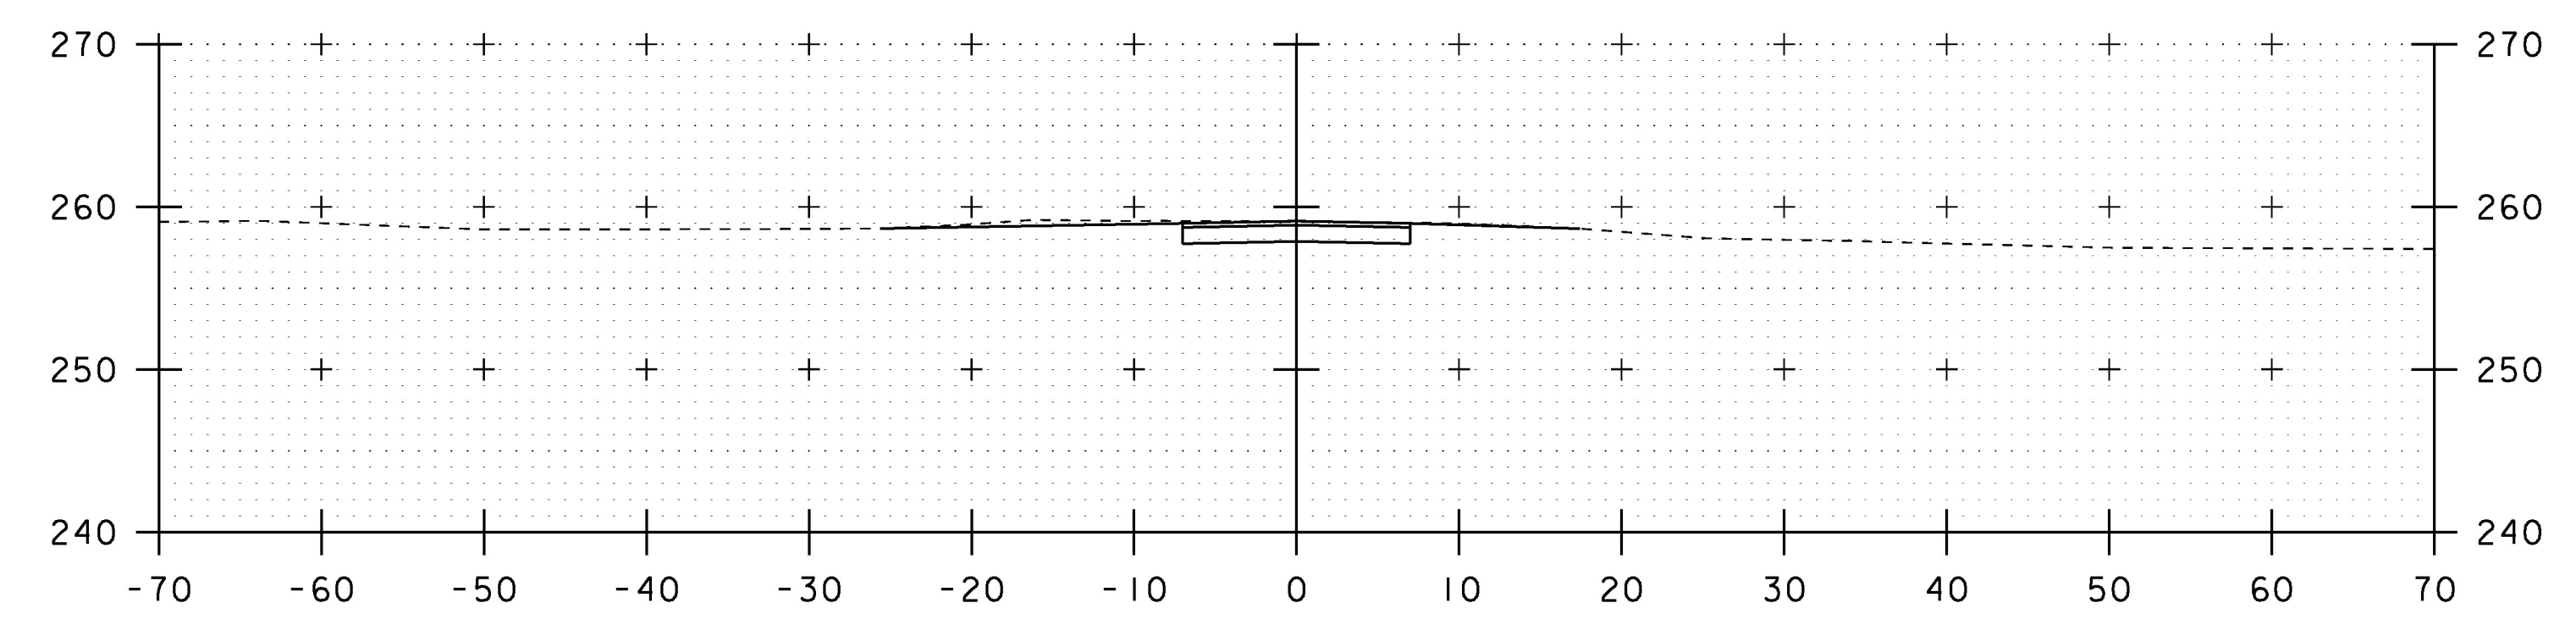

55+06 DRIVE RT SECTION A-A

SCALE IN FEET

STA. 54+50 TO STA. 56+00

PROJECT NAME: CHARLOTTE	
PROJECT NUMBER: F EGC 019-4(20)	
FILE NAME: d78d062_xs.dgn	PLOT DATE: 15-MAR-2016
PROJECT LEADER: K. UPMAL	DRAWN BY: B. KIPP
DESIGNED BY: B. KIPP	CHECKED BY: C. LEACH
MAINLINE CROSS SECTIONS 27	SHEET 304 OF 499