




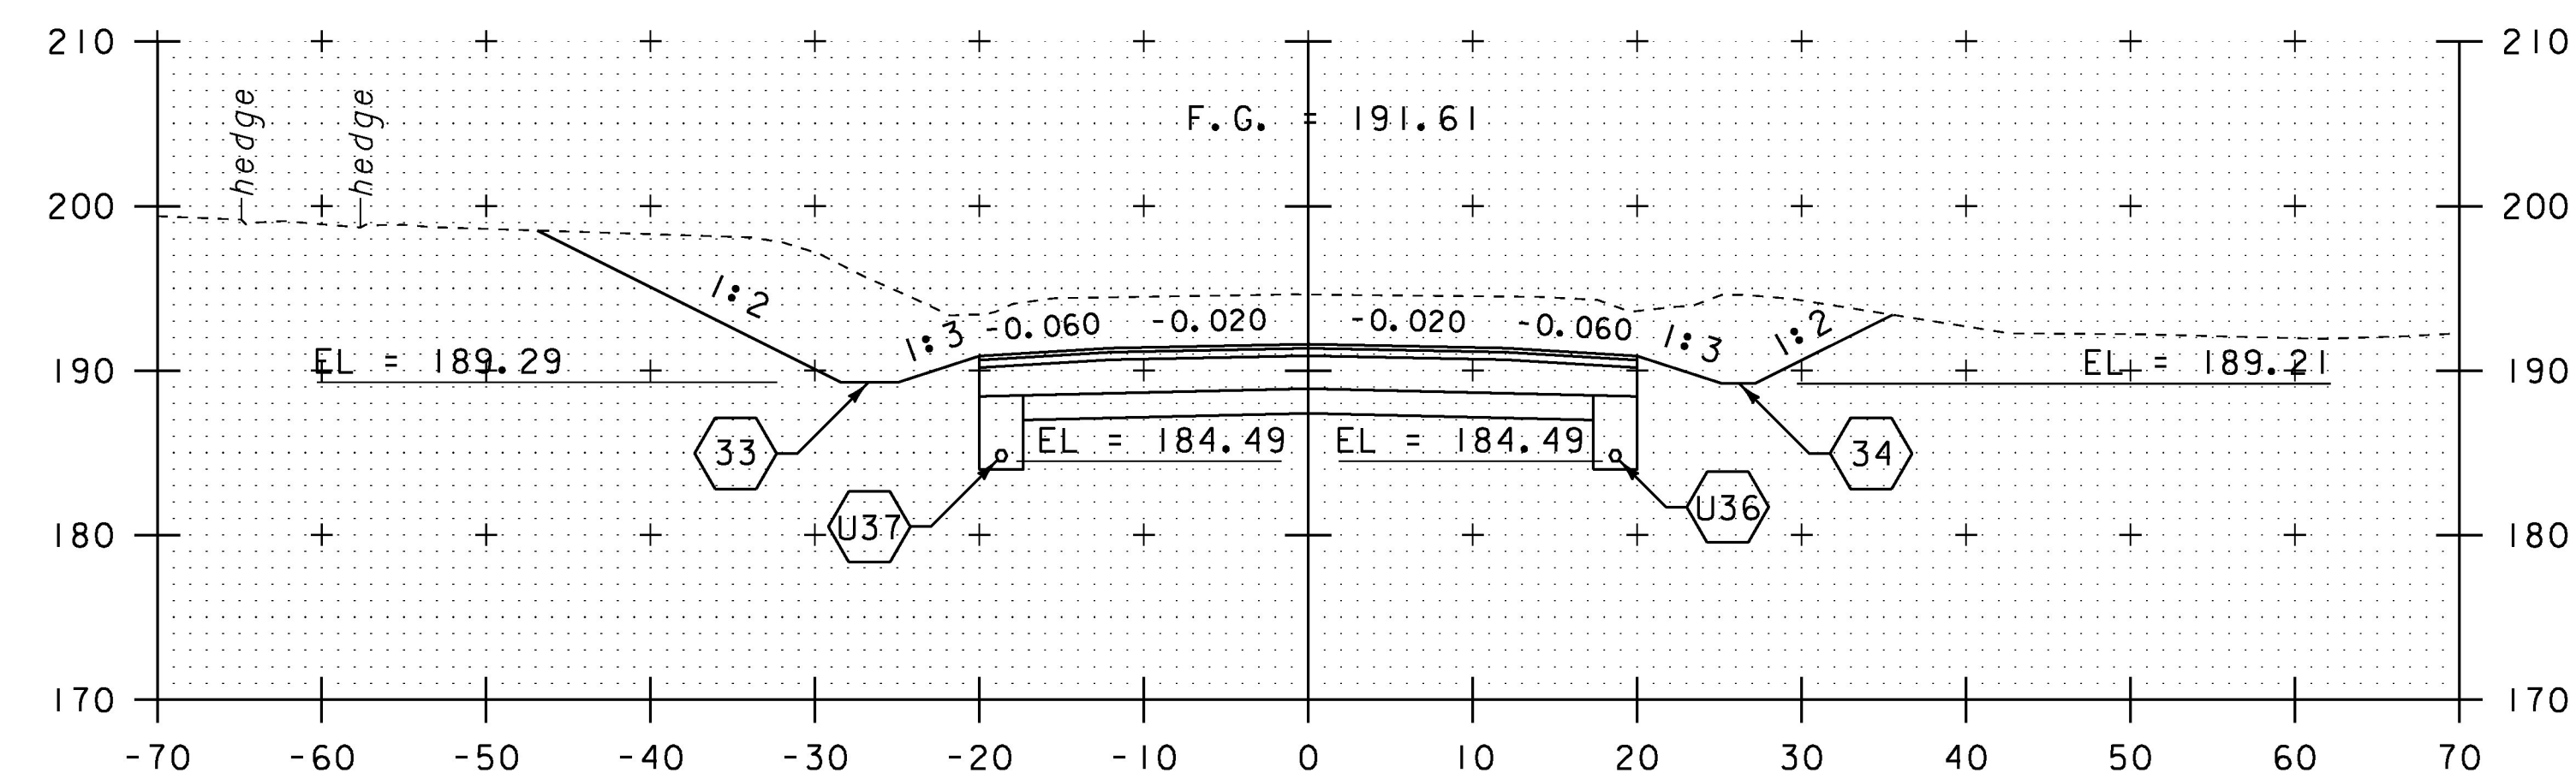


107+50

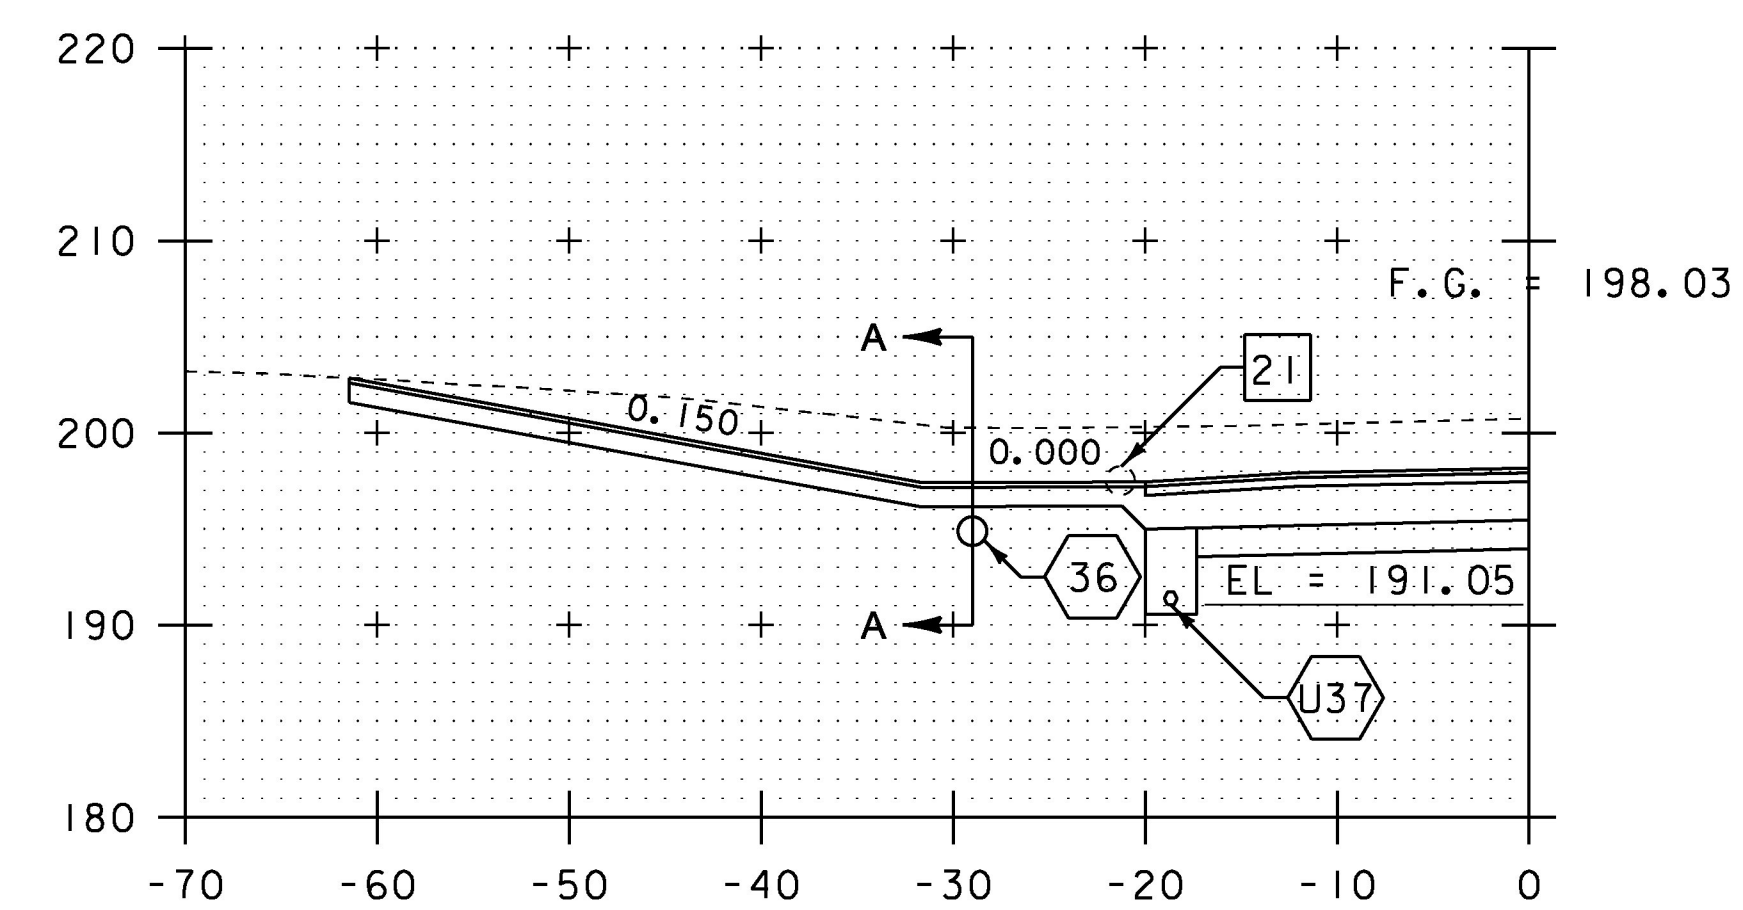


108+92 DRIVE LT

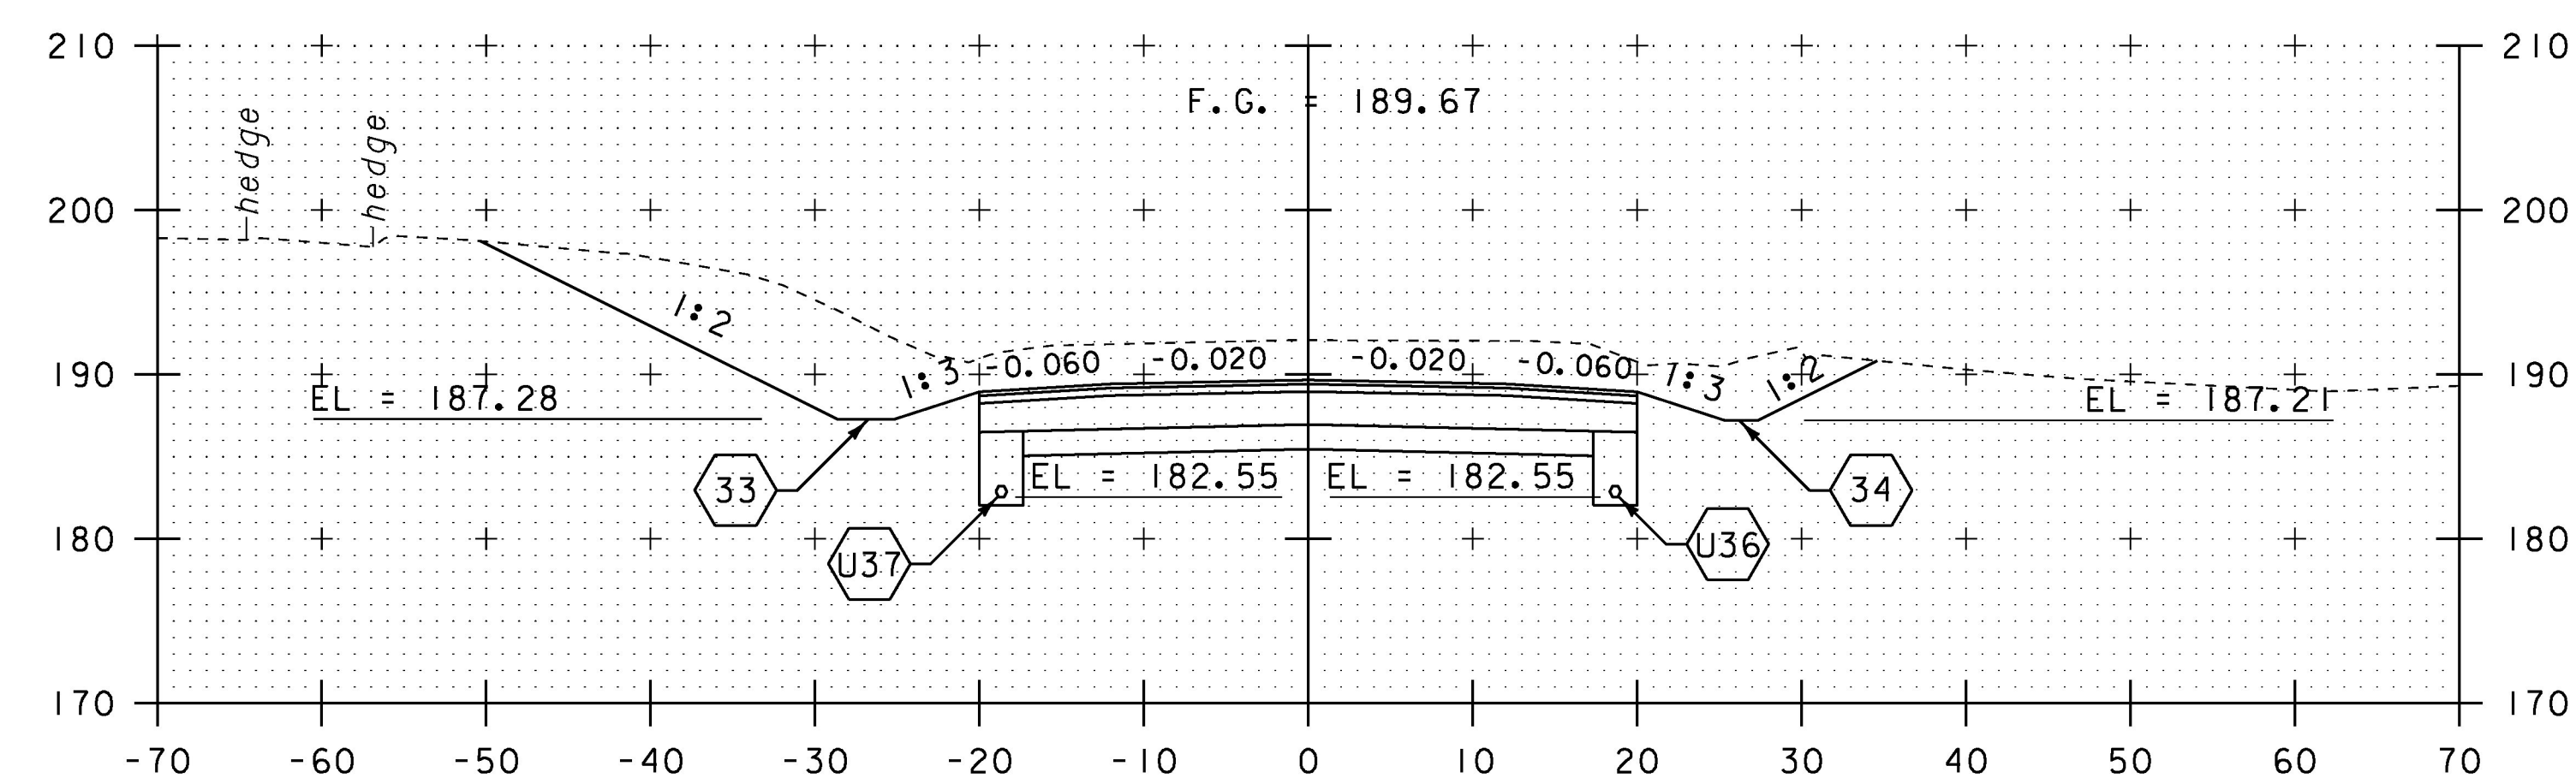


107+00

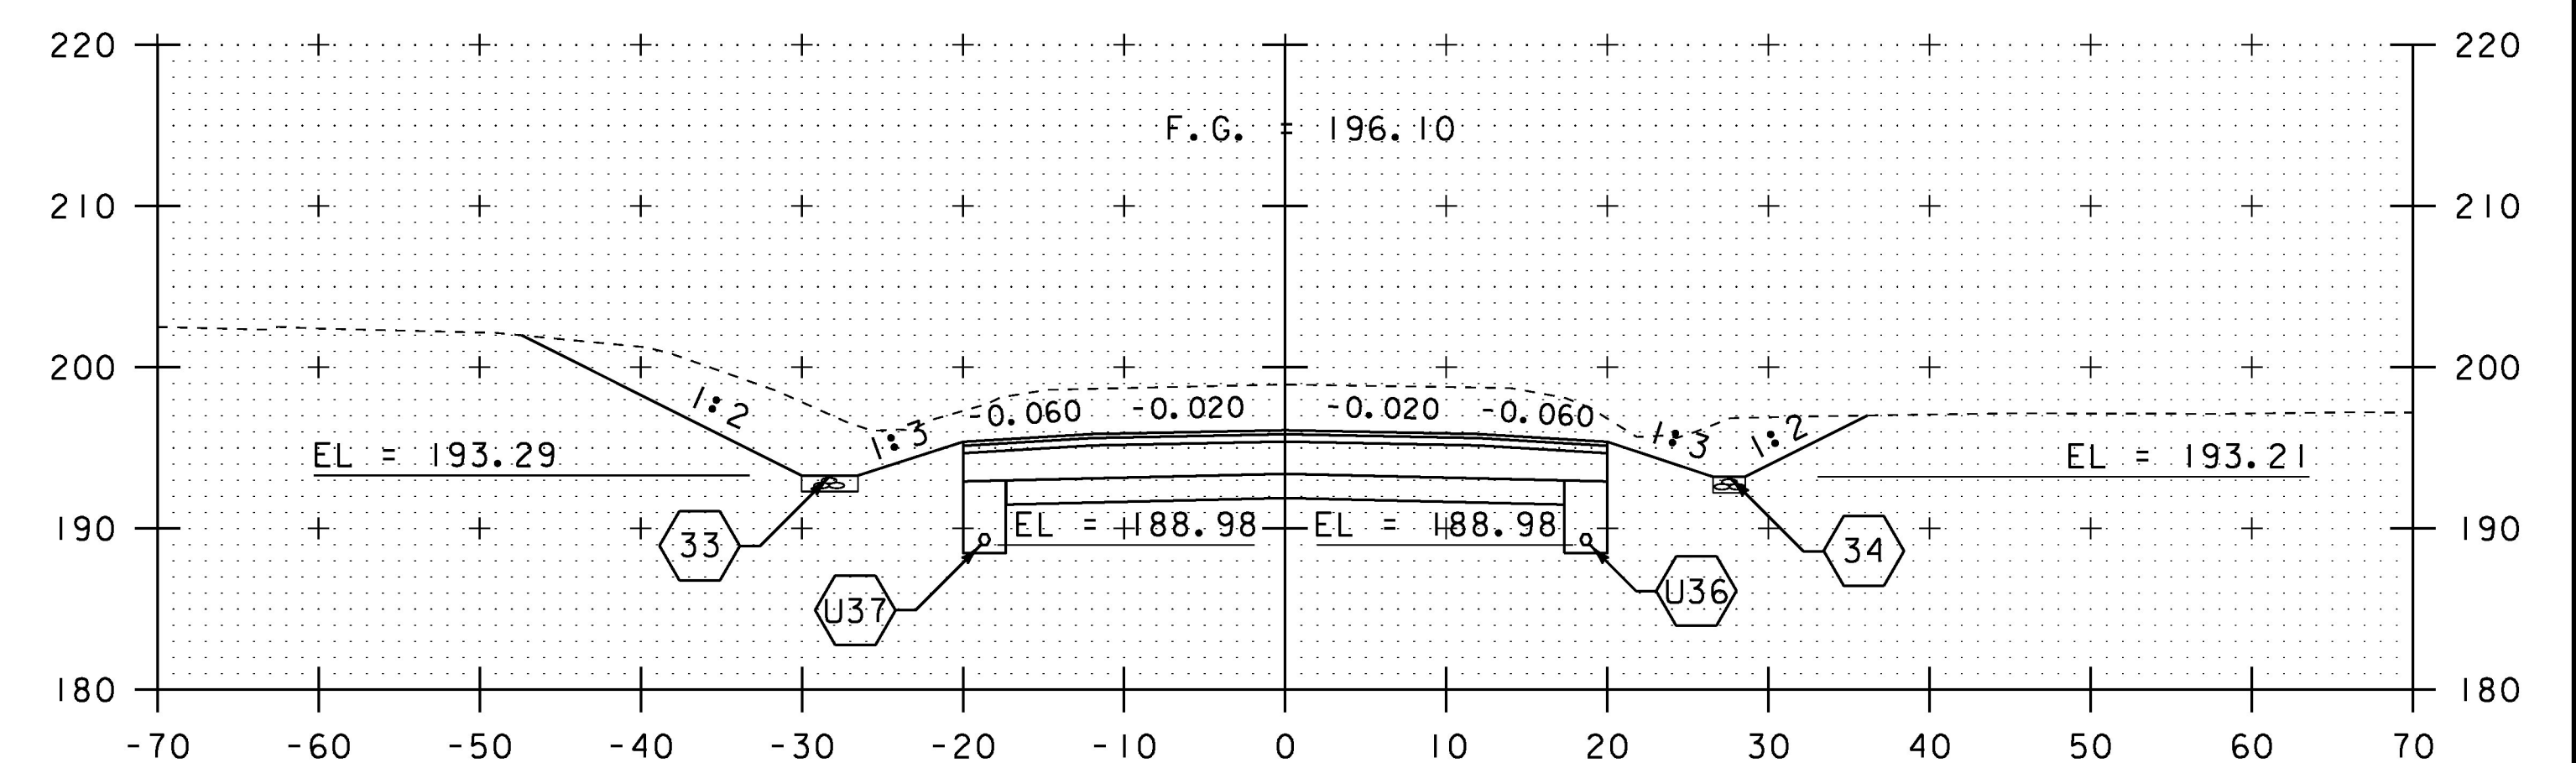

108+50

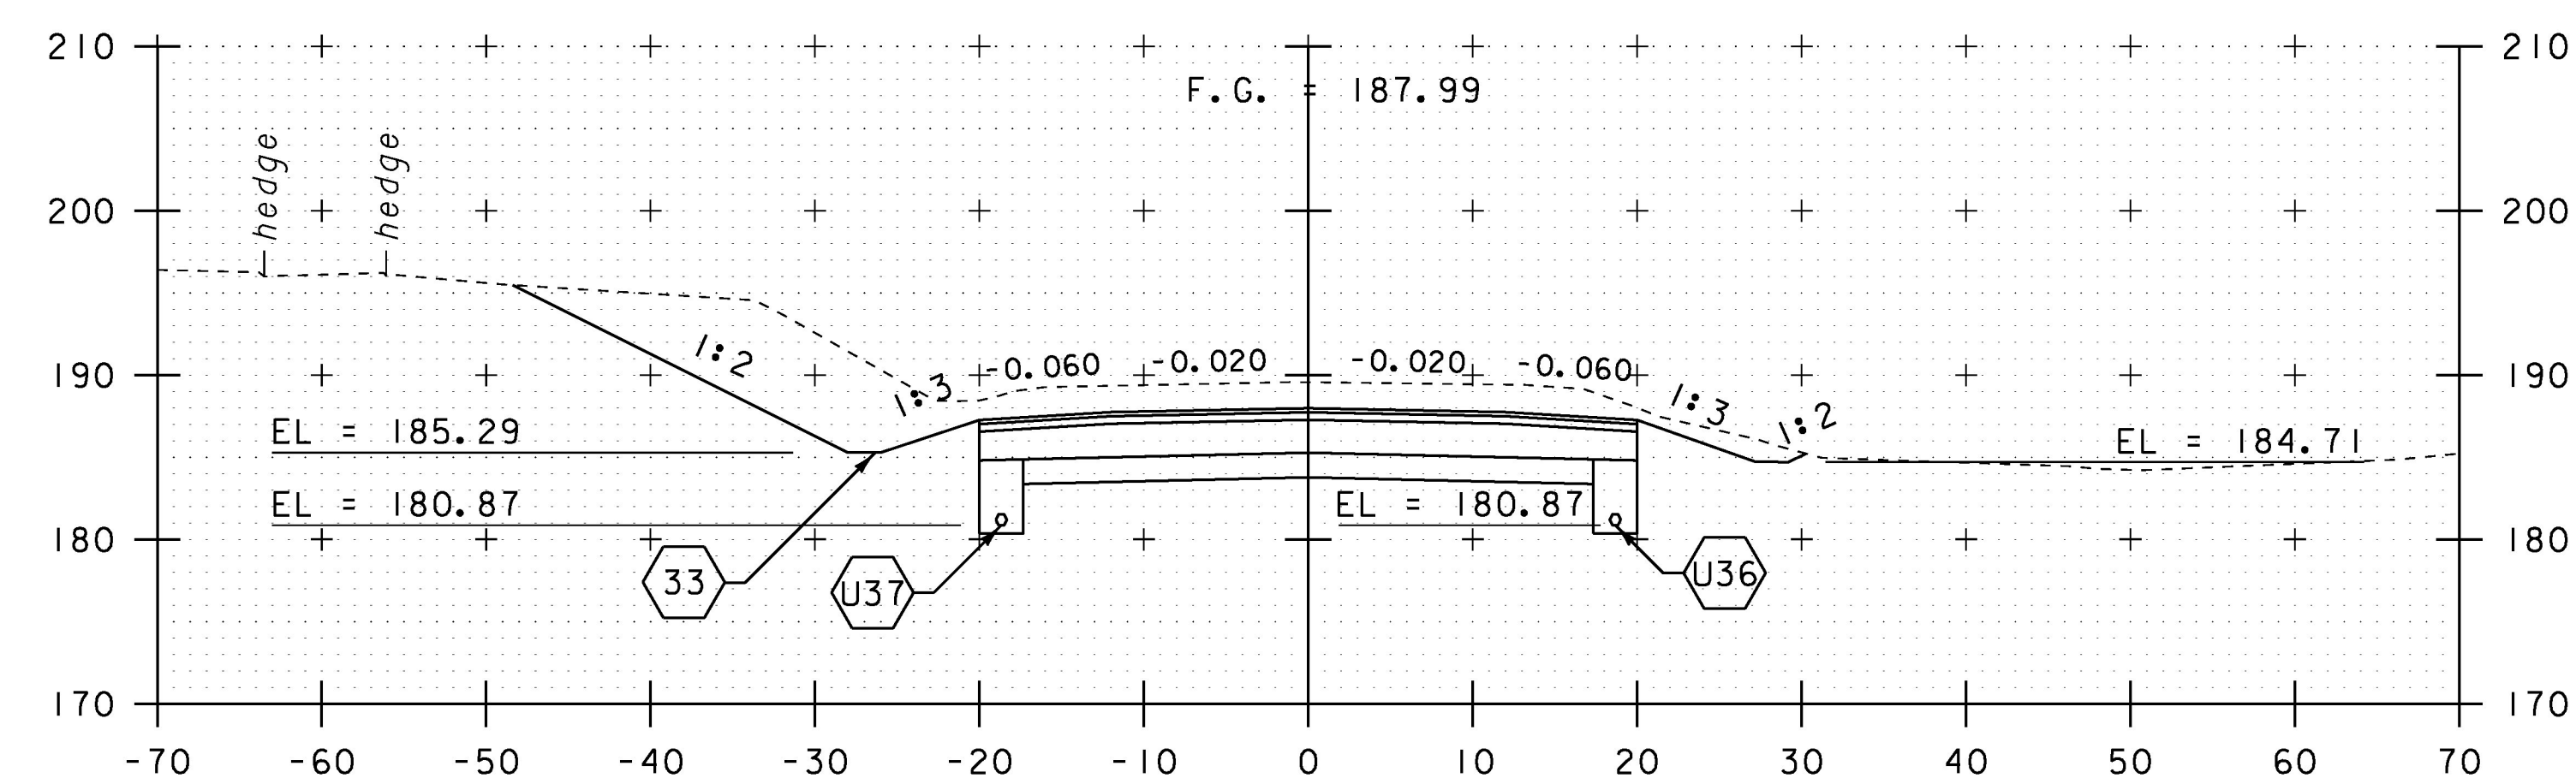

106+50

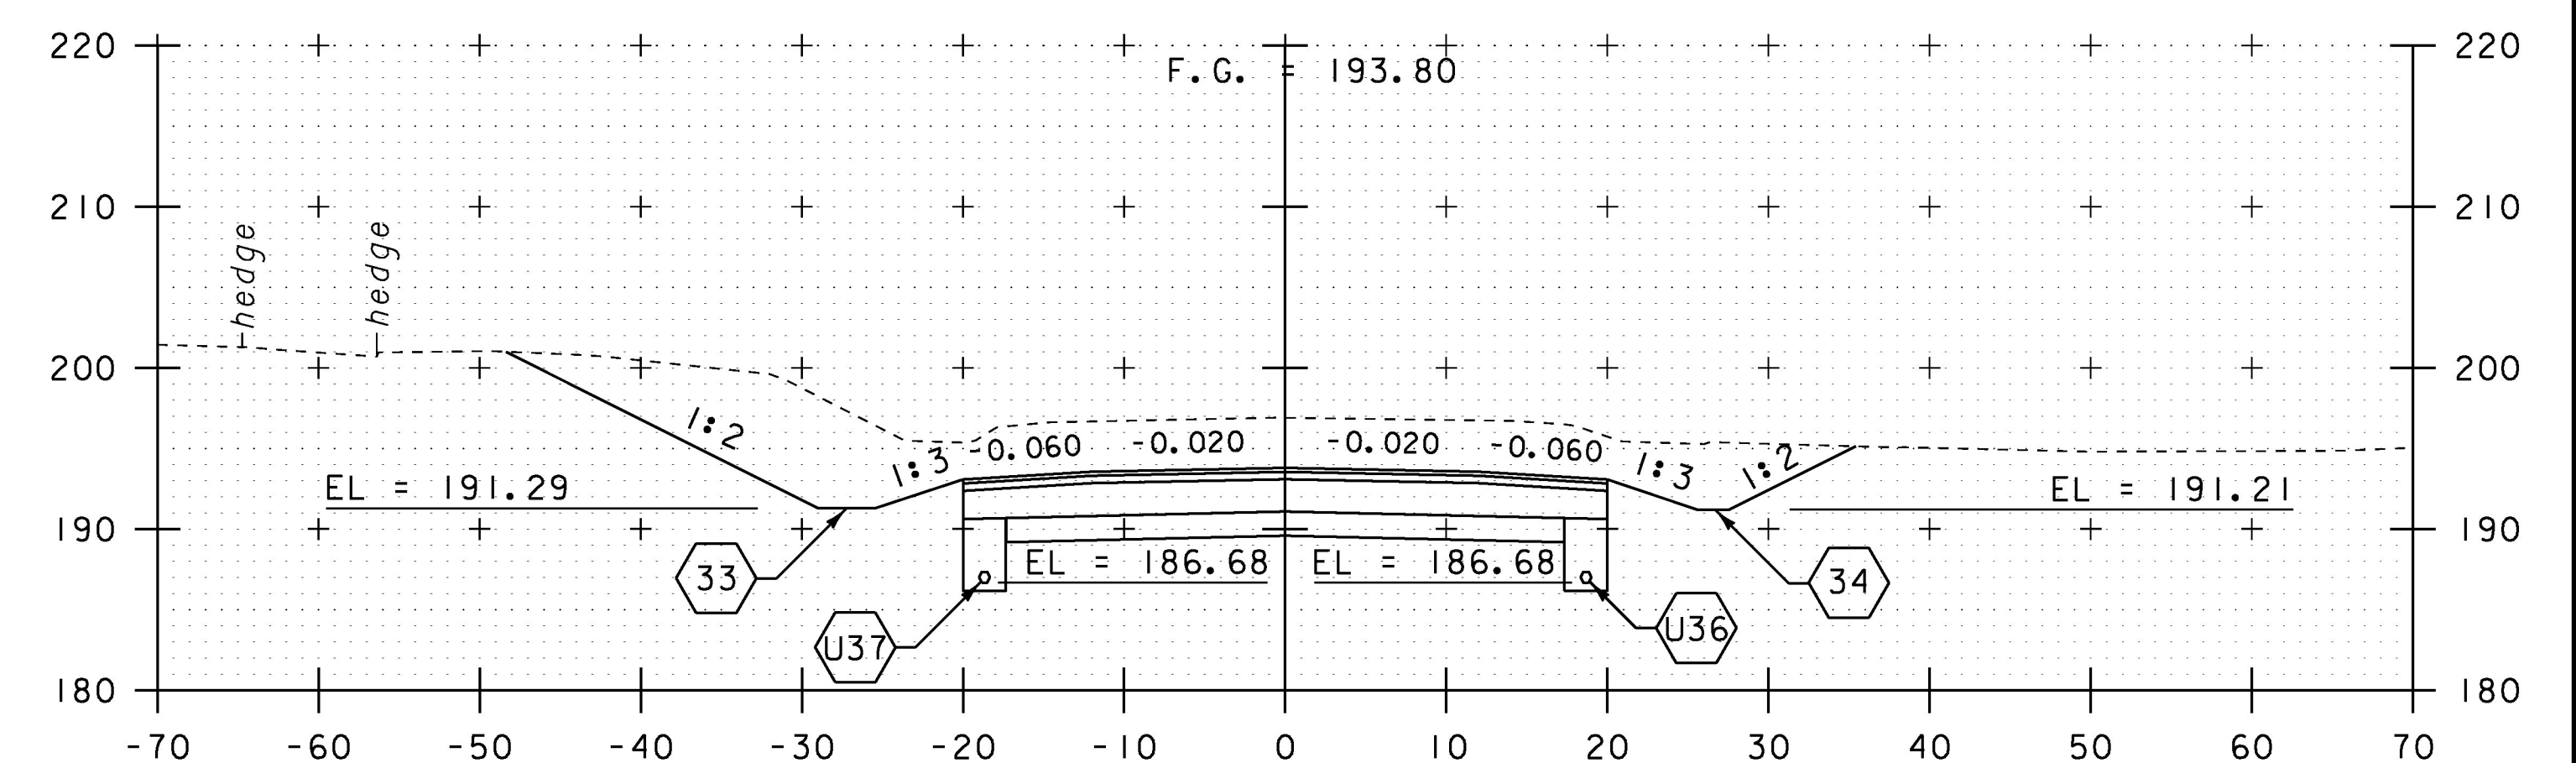

108+00

SCALE IN FEET

STA. 106+50 TO STA. 108+92

PROJECT NAME: CHARLOTTE	
PROJECT NUMBER: F EGC 019-4(20)	
FILE NAME: d78d062_xs.dgn	PLOT DATE: 15-MAR-2016
PROJECT LEADER: K. UPMAL	DRAWN BY: B. KIPP
DESIGNED BY: B. KIPP	CHECKED BY: C. LEACH
MAINLINE CROSS SECTIONS 54	SHEET 331 OF 499