



SEABOARD-WILMINGTON
NHF 010-1(18)
BRIDGE 25 APPROACHES
Item 202.32. GRANULAR BORROW
SHEET 4 OF
ABUT #1

FINAL
SURVEY
DATE
BY
NO. OF
AREAS CHECKED

ORIGINAL
SURVEY
DATE
BY
NO. OF
AREAS CHECKED

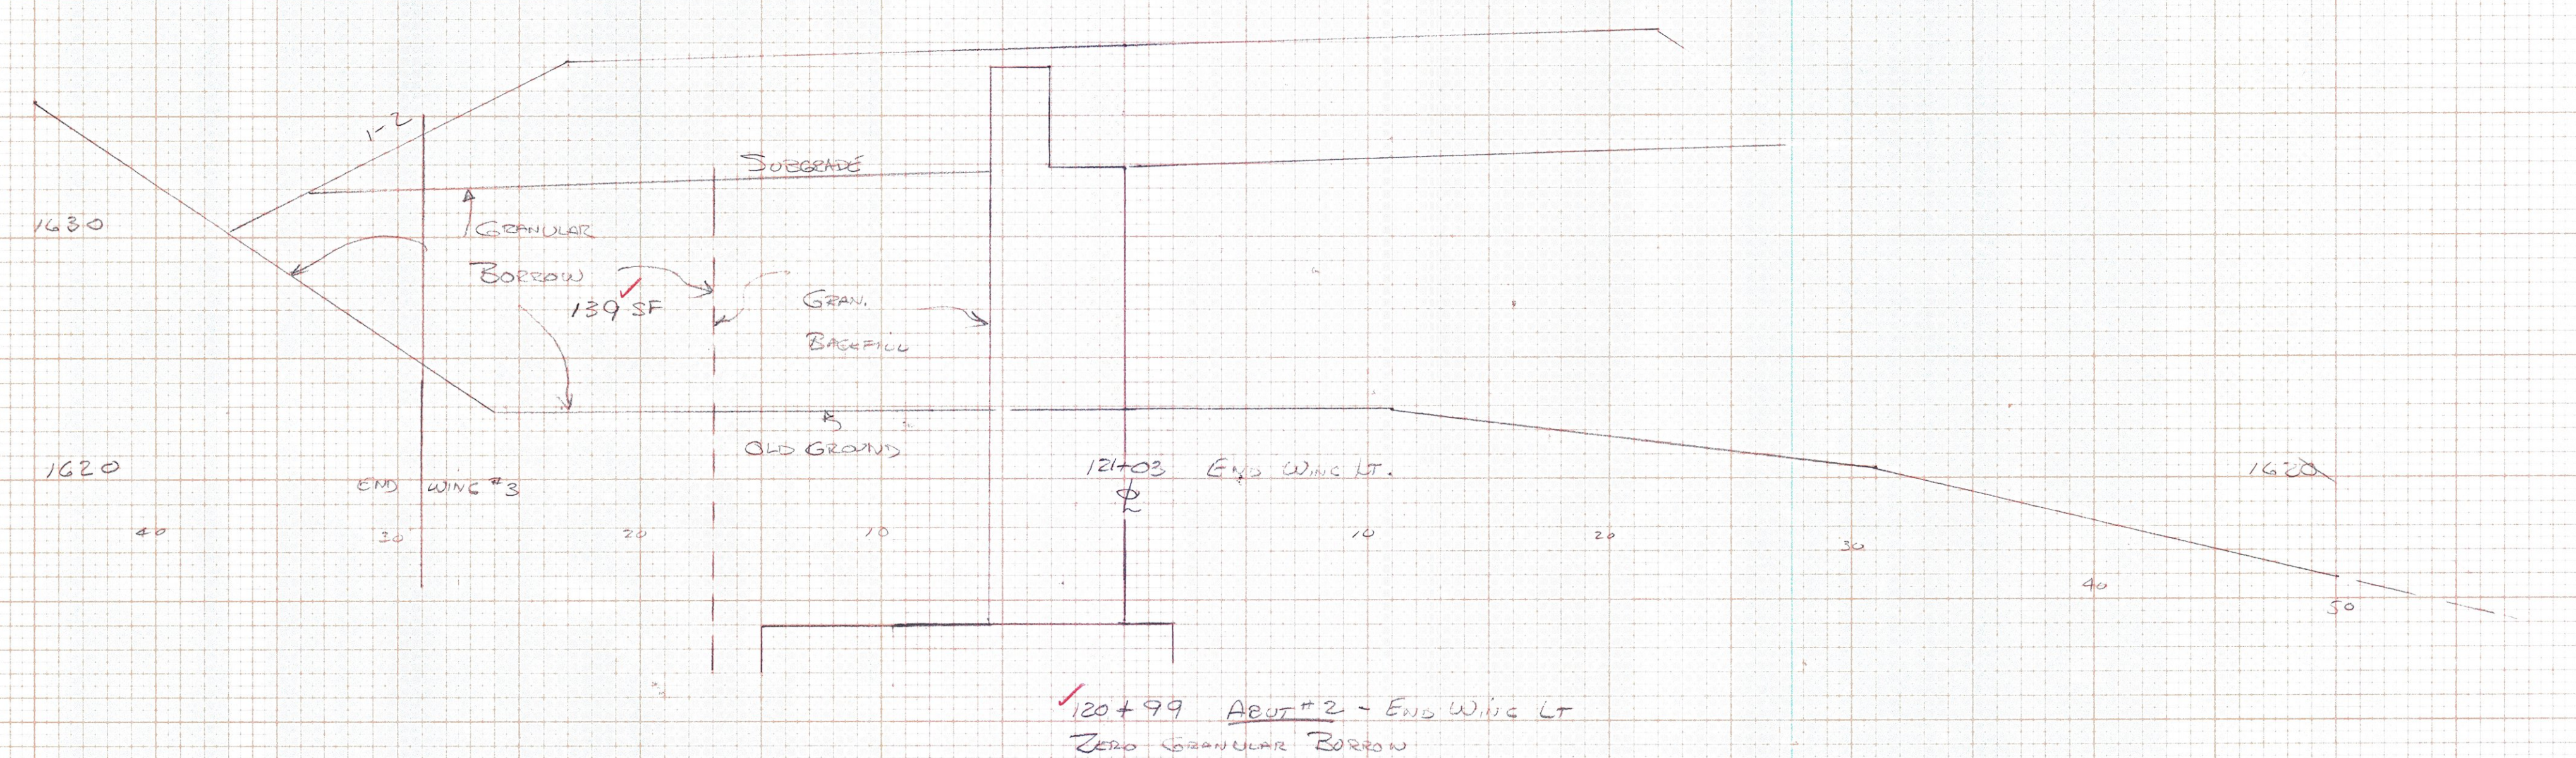

118+78
ZERO - GRAN. BORROW @ ABUT #1
CHANGE ABUT / WING #2

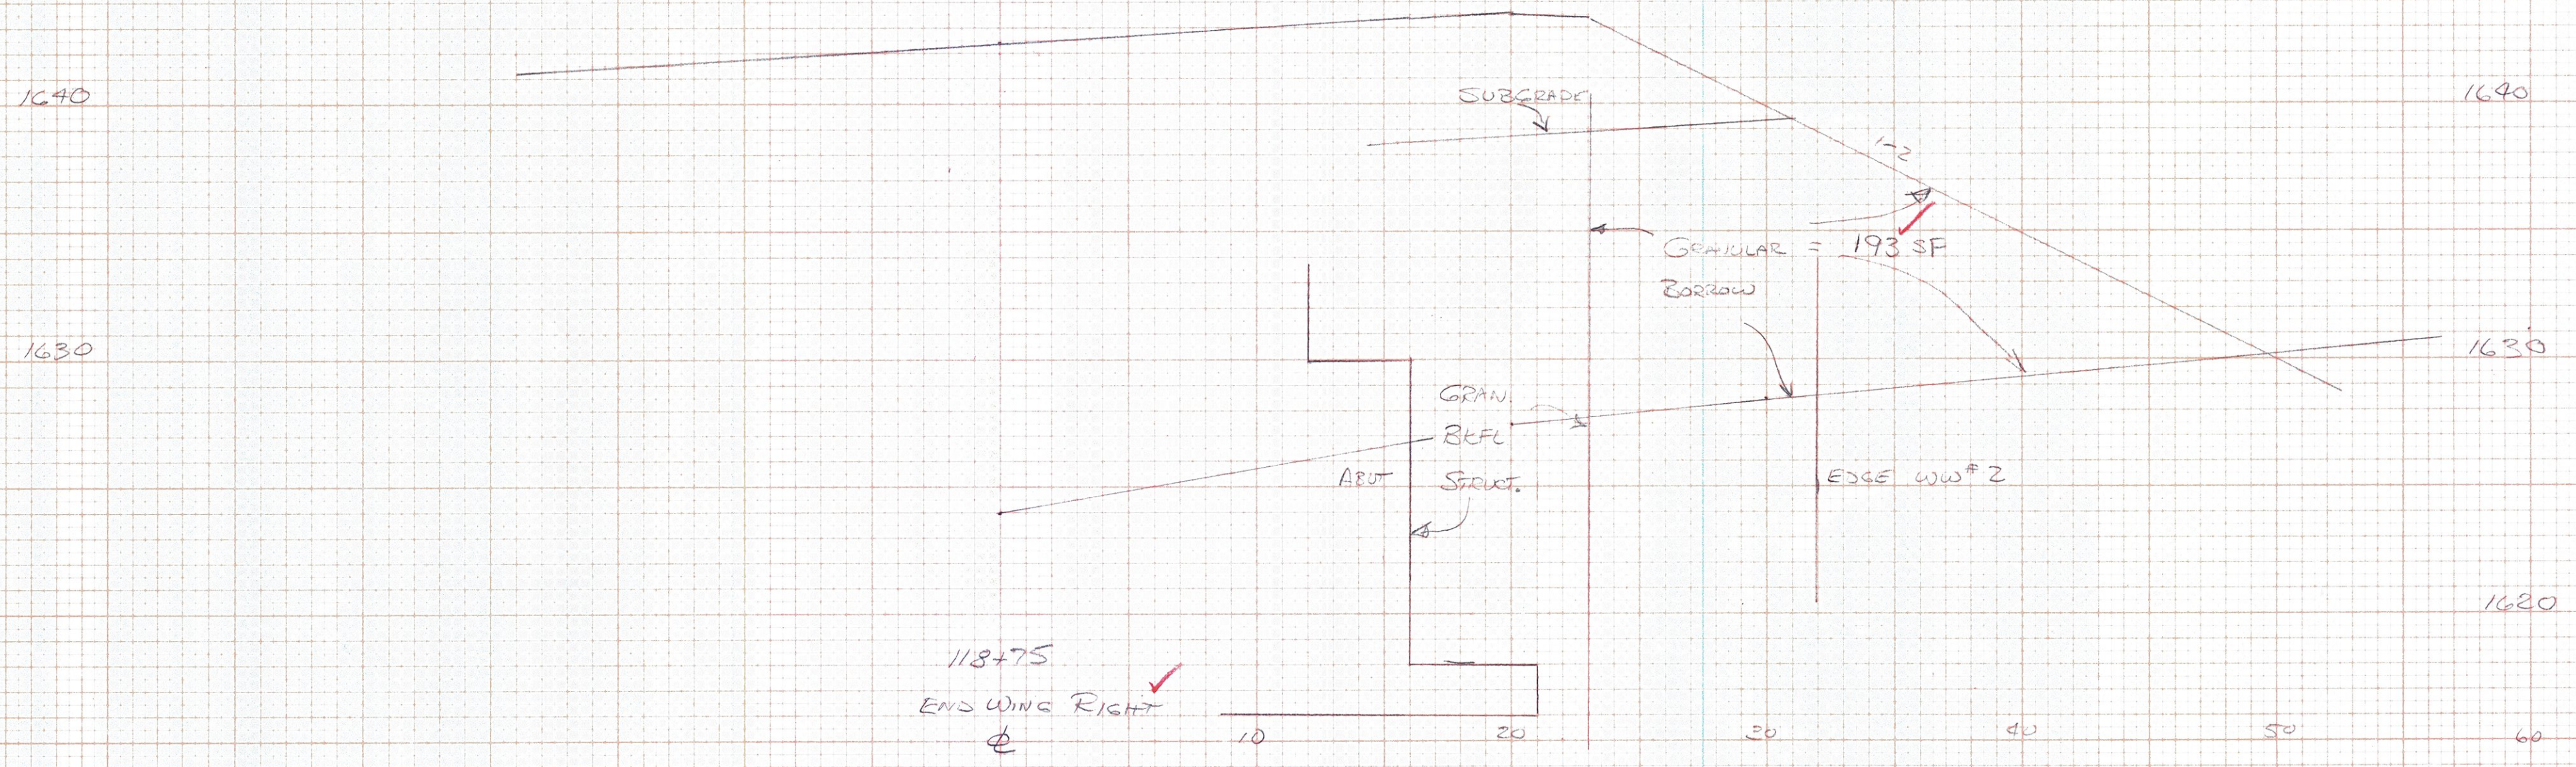

DC 2-15-05