


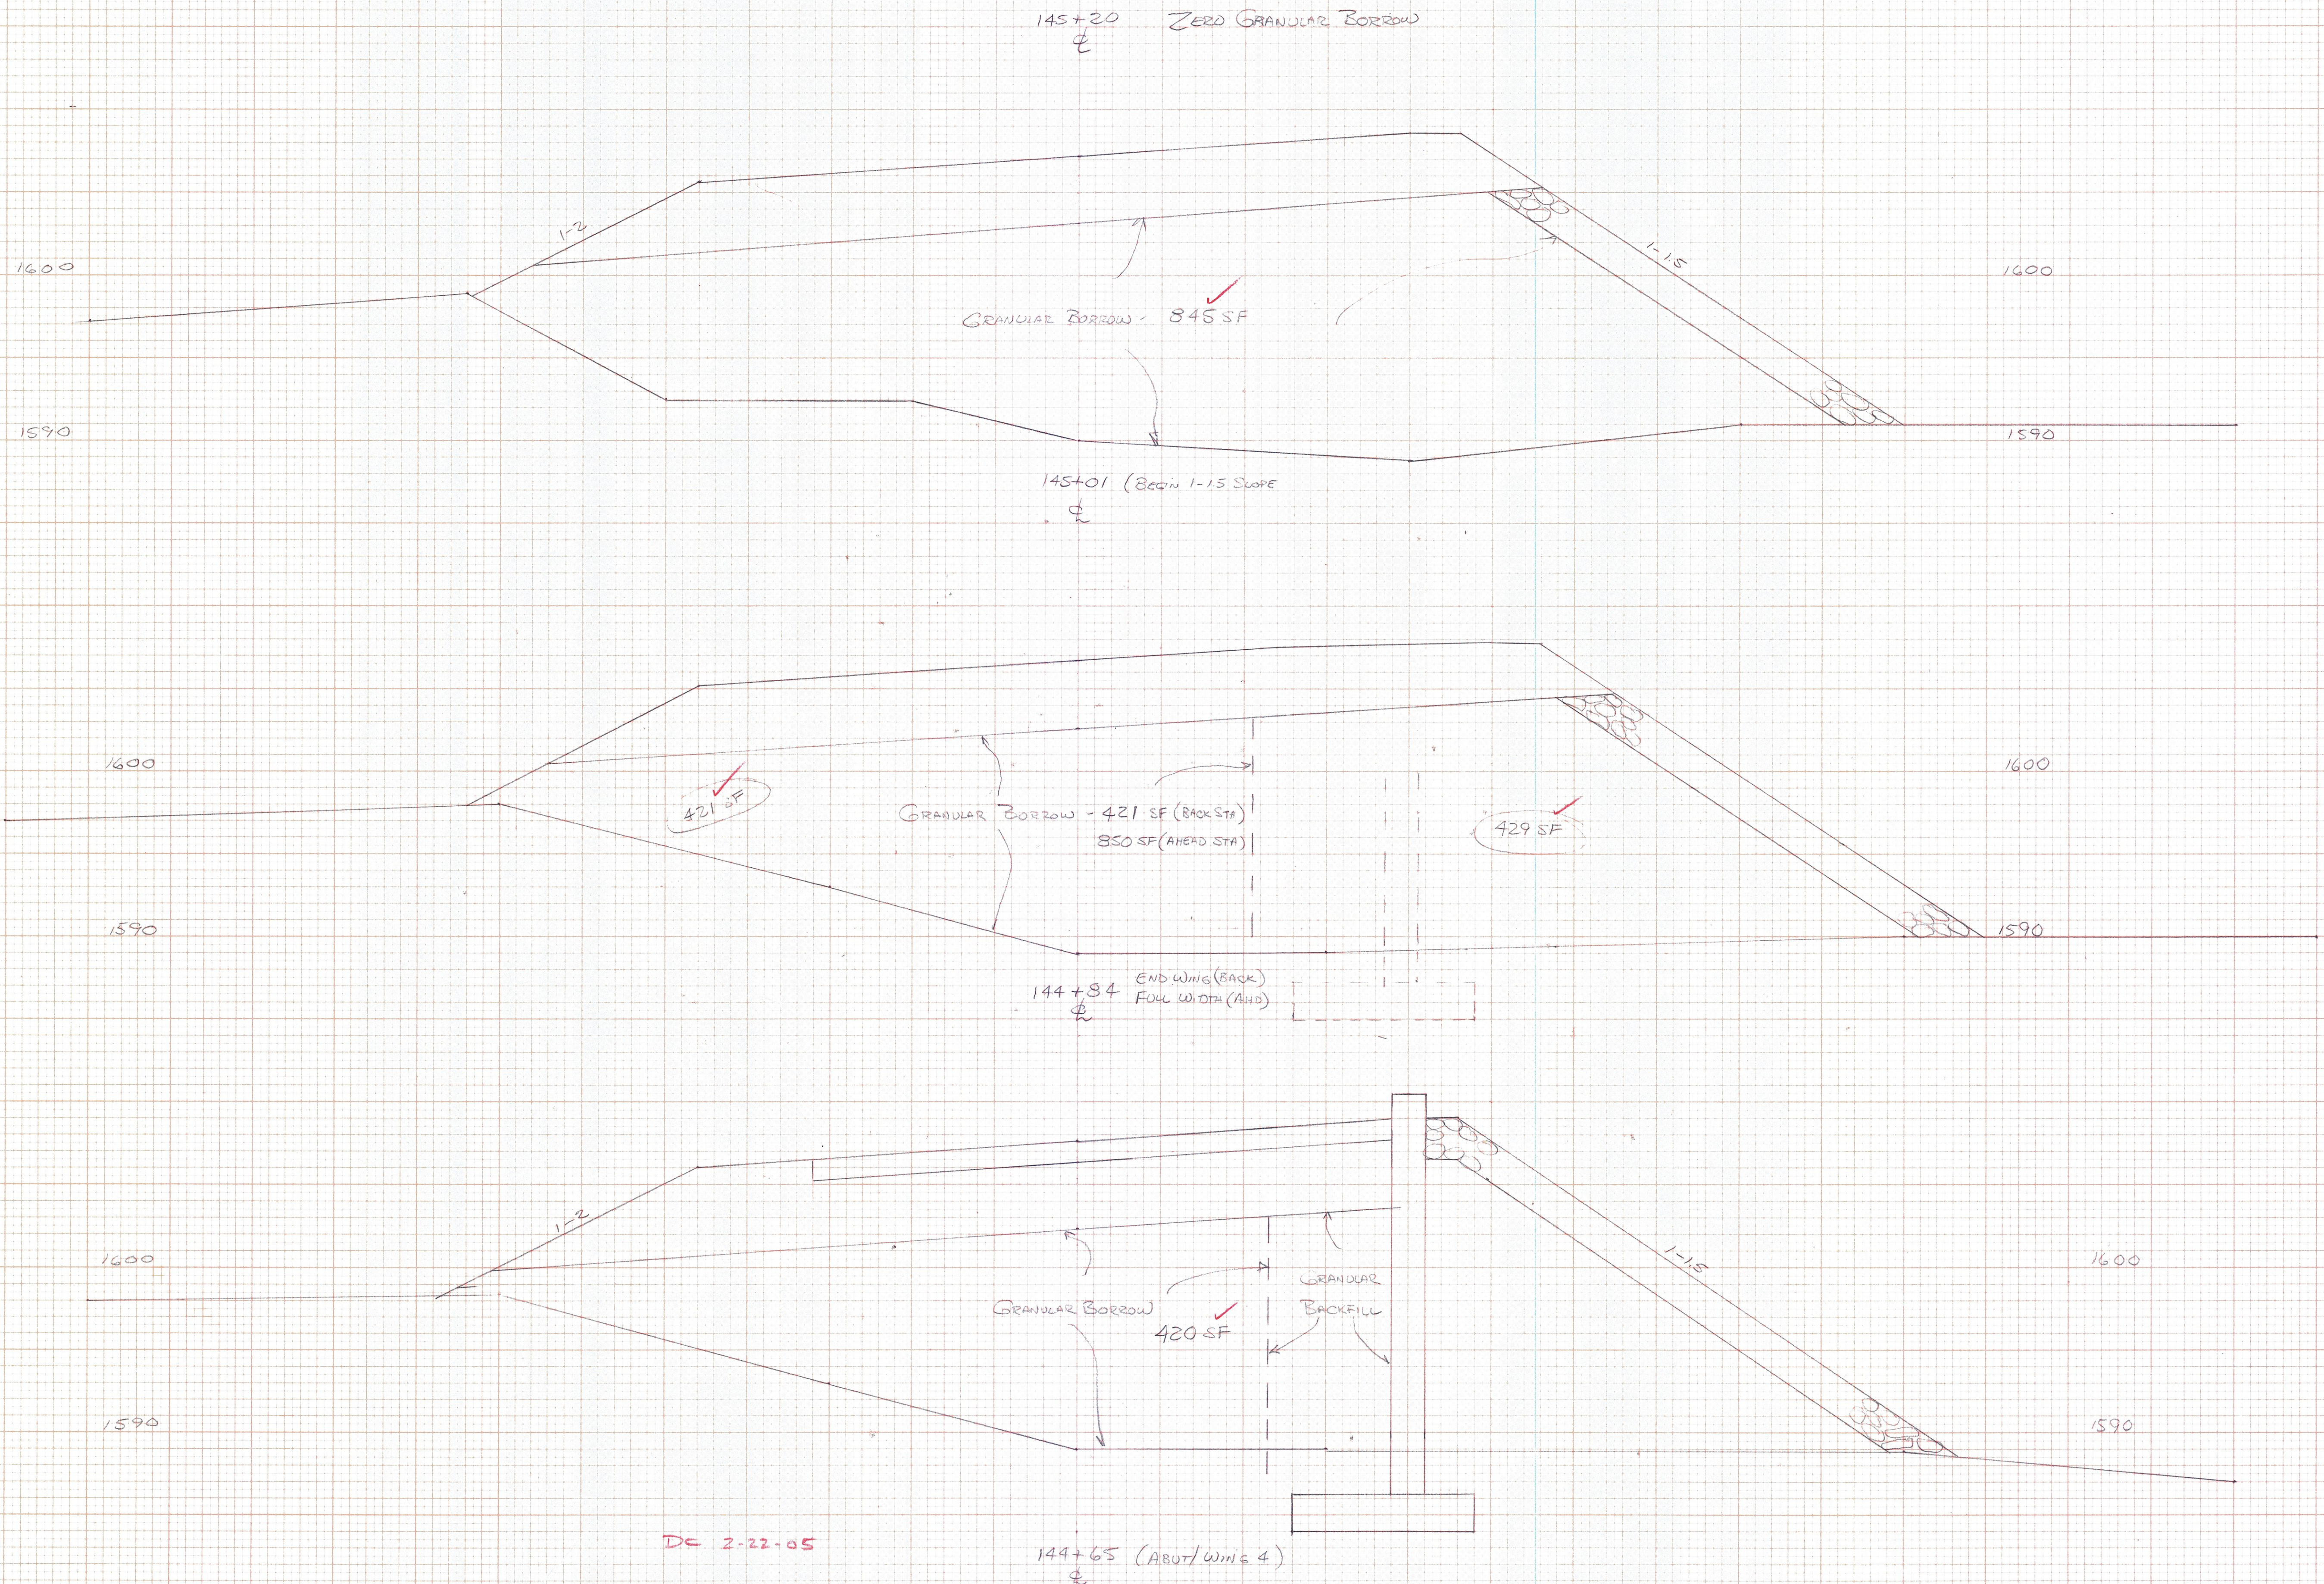

DC 2-22-05