


FINAL SURVEY
DATE
BY
NOTED BOOK
AREA
NO.


ORIGINAL SURVEY
DATE
BY
NOTED BOOK
AREA
NO.

9/22-03 JDC
208.30-175.87+104.30-112.40 SQ. FT. $\checkmark$ V010
613.13: 34.40+15+15+15= 112.40 SQ. FT. $\checkmark$ MW 4-5-04

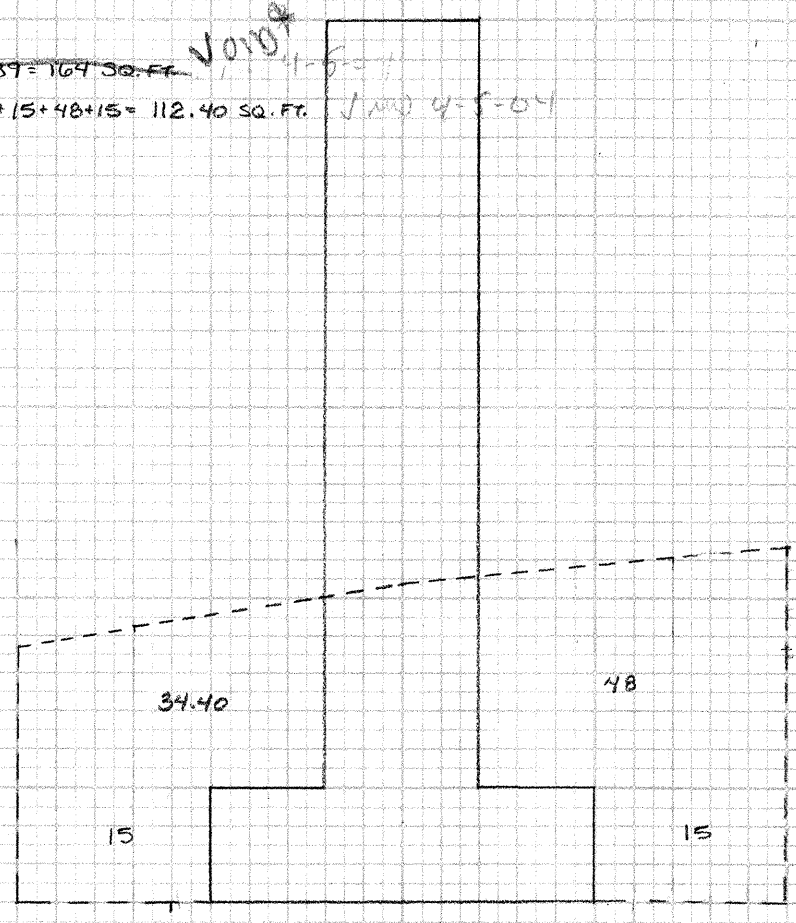

1630
1620
1610


9/22-03 JDC
208.30-175.87+104.30-112.40 SQ. FT. $\checkmark$ V010
613.13: 17+15+14.10+30.30+15= 91.60 SQ. FT. $\checkmark$ MW 4-5-05

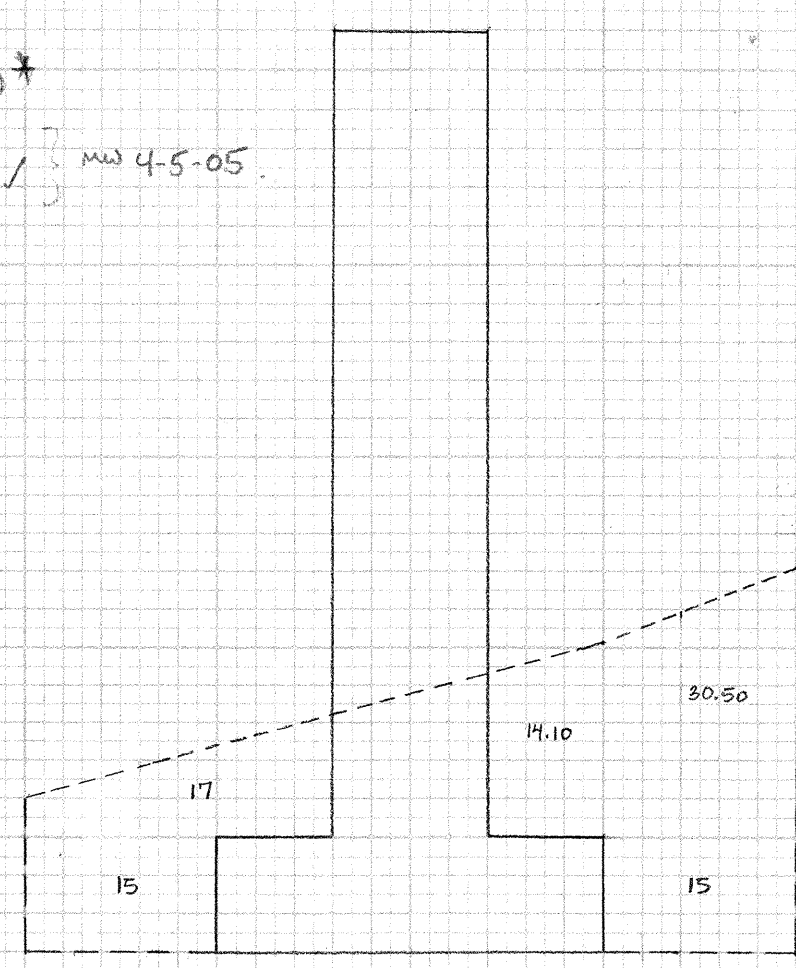

1630
1620
1610


BRIDGE 25
PIER #1
SCALE: 1/8" = 1'-0"
XBR25-5

* ITEM 208.30 CALCULATIONS
NOT BASED ON THESE SECTIONS
SEE CALCULATION SHEETS IN
BRIDGE COMPUTATION BINDER, BR25
208.30-25-PI-1 ~ PI-2
208.30-25-PI-1 ~ PI-2

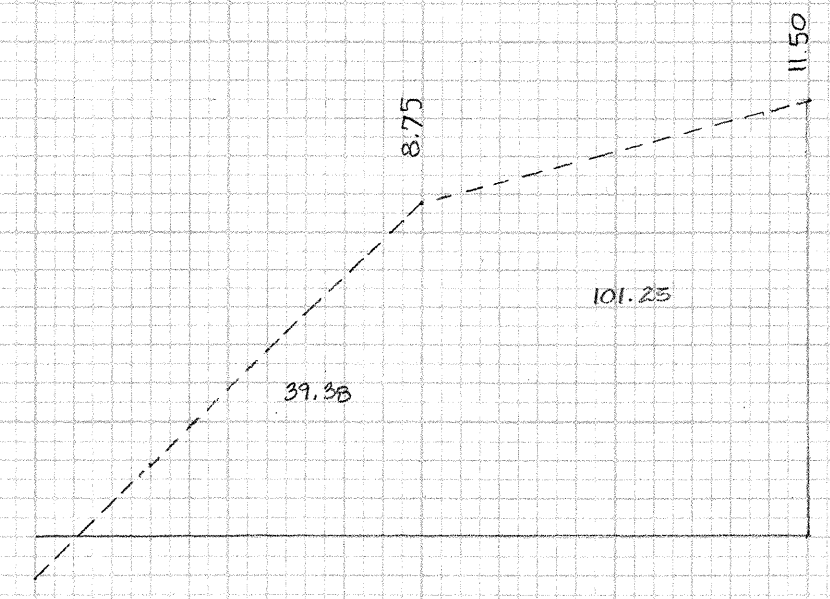


1630
1620
1610

9/22-03 JDC
208.30-175.87+104.30-112.40 SQ. FT. $\checkmark$ V010
613.13: 29.60+15+15+14.4+104 SQ. FT. $\checkmark$ MW 4-5-04

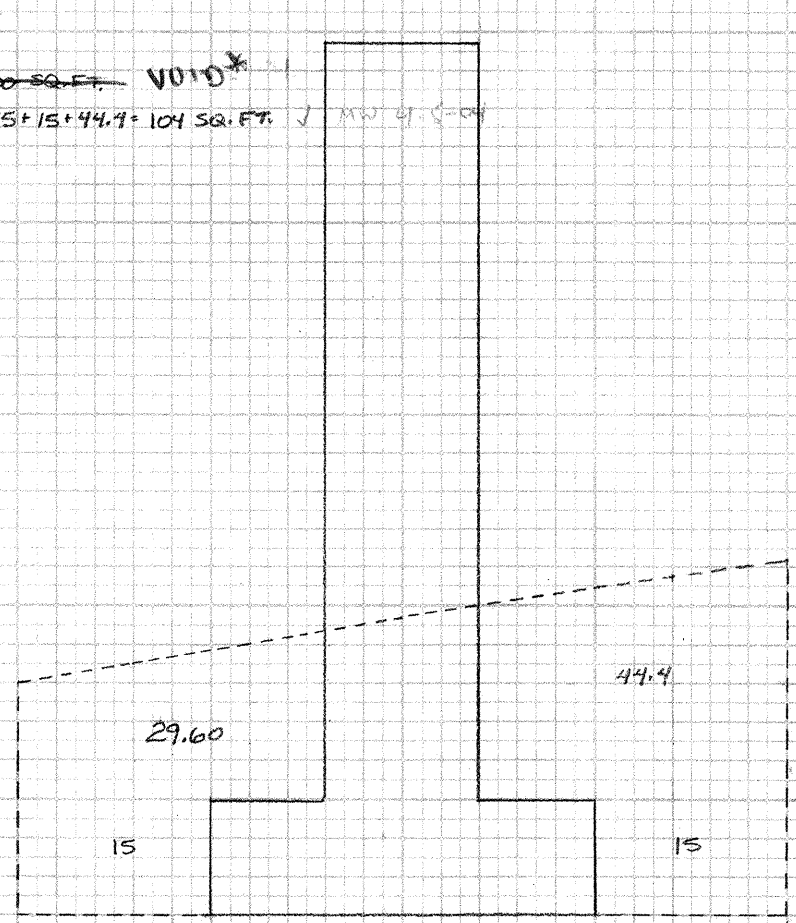


1630
1620
1610

9/22-03 JDC
208.30-175.87+104.30-112.40 SQ. FT. $\checkmark$ V010
613.13: 28.80+15+15+50.80= 109.60 SQ. FT. $\checkmark$ MW 4-5-04

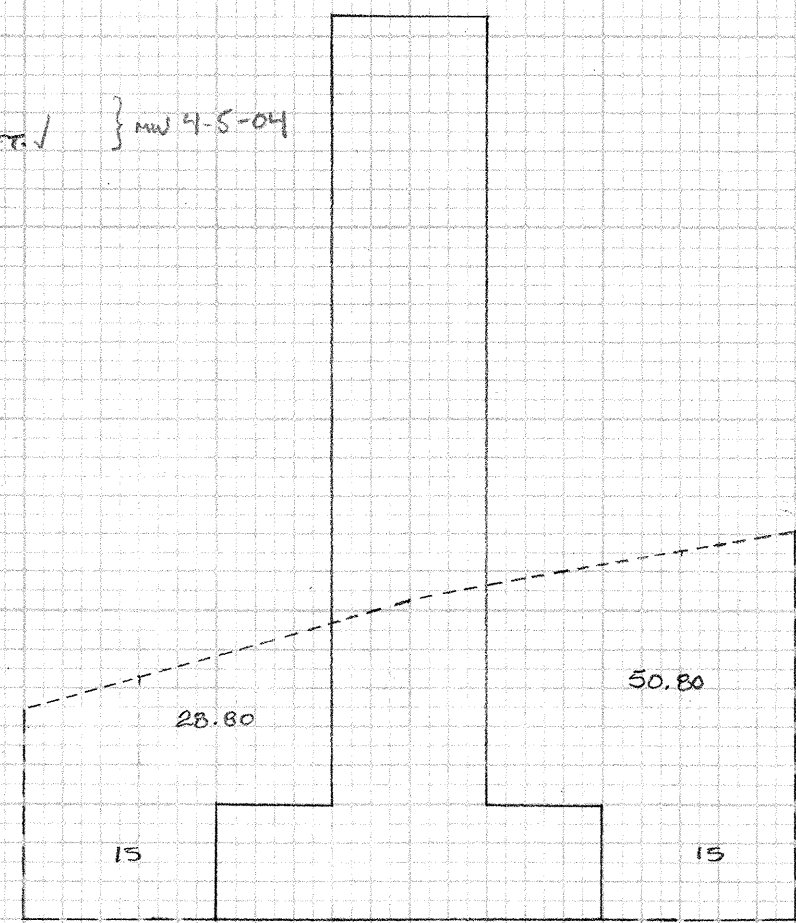


1630
1620
1610

9/22-03 JDC
208.30-175.87+104.30-112.40 SQ. FT. $\checkmark$ V010
613.13: 27.20+15+15+54.80= 112.00 SQ. FT. $\checkmark$ MW 4-5-04

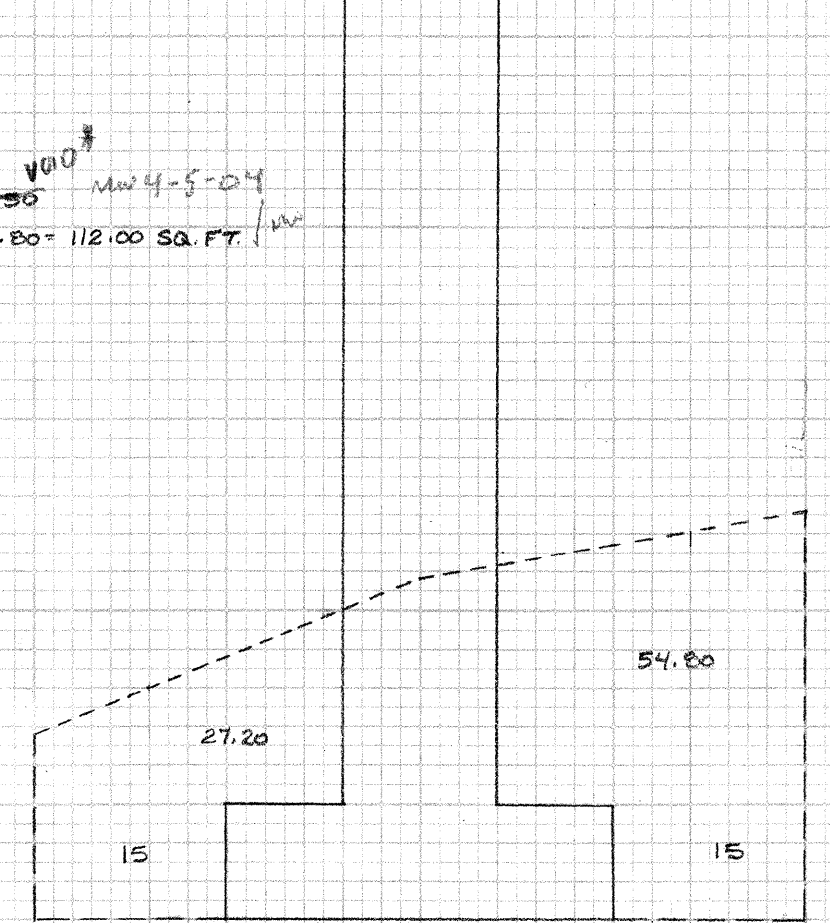


1630
1620
1610

9/22-03 JDC
208.30-175.87+104.30-112.40 SQ. FT. $\checkmark$ V010
613.13: 17.50 SQ. FT. $\checkmark$ MW 4-5-04

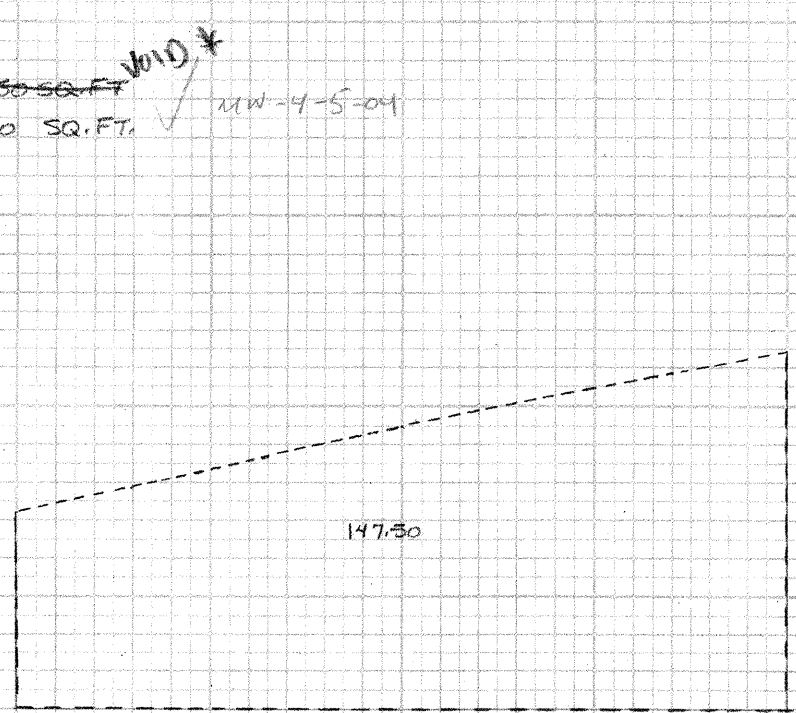


1620
1610

9/22-03 JDC
208.30-175.87+104.30-112.40 SQ. FT. $\checkmark$ V010
613.13: 36.40+15+15+49.20= 115.60 SQ. FT. $\checkmark$ MW 4-5-04

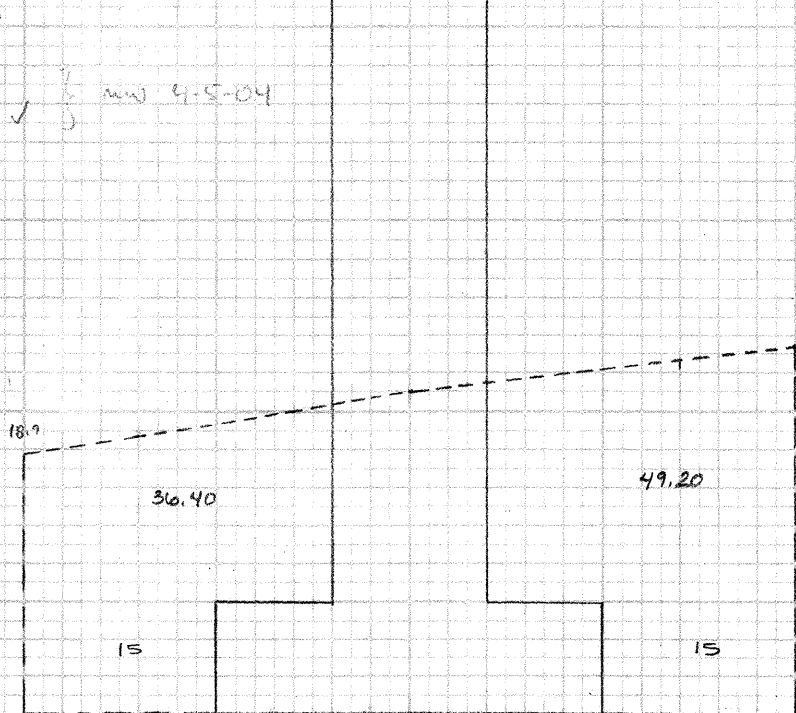

1630
1620
1610

9/22-03 JDC
208.30-175.87+104.30-112.40 SQ. FT. $\checkmark$ V010
613.13: 18+15+15+52.60= 100.60 SQ. FT. $\checkmark$ MW 4-5-04

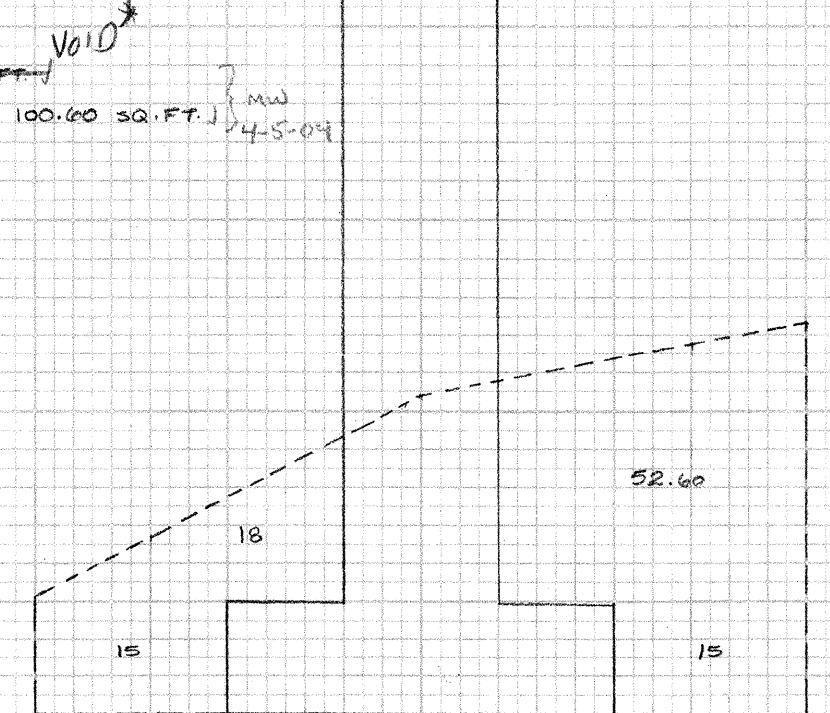

1630
1620
1610