


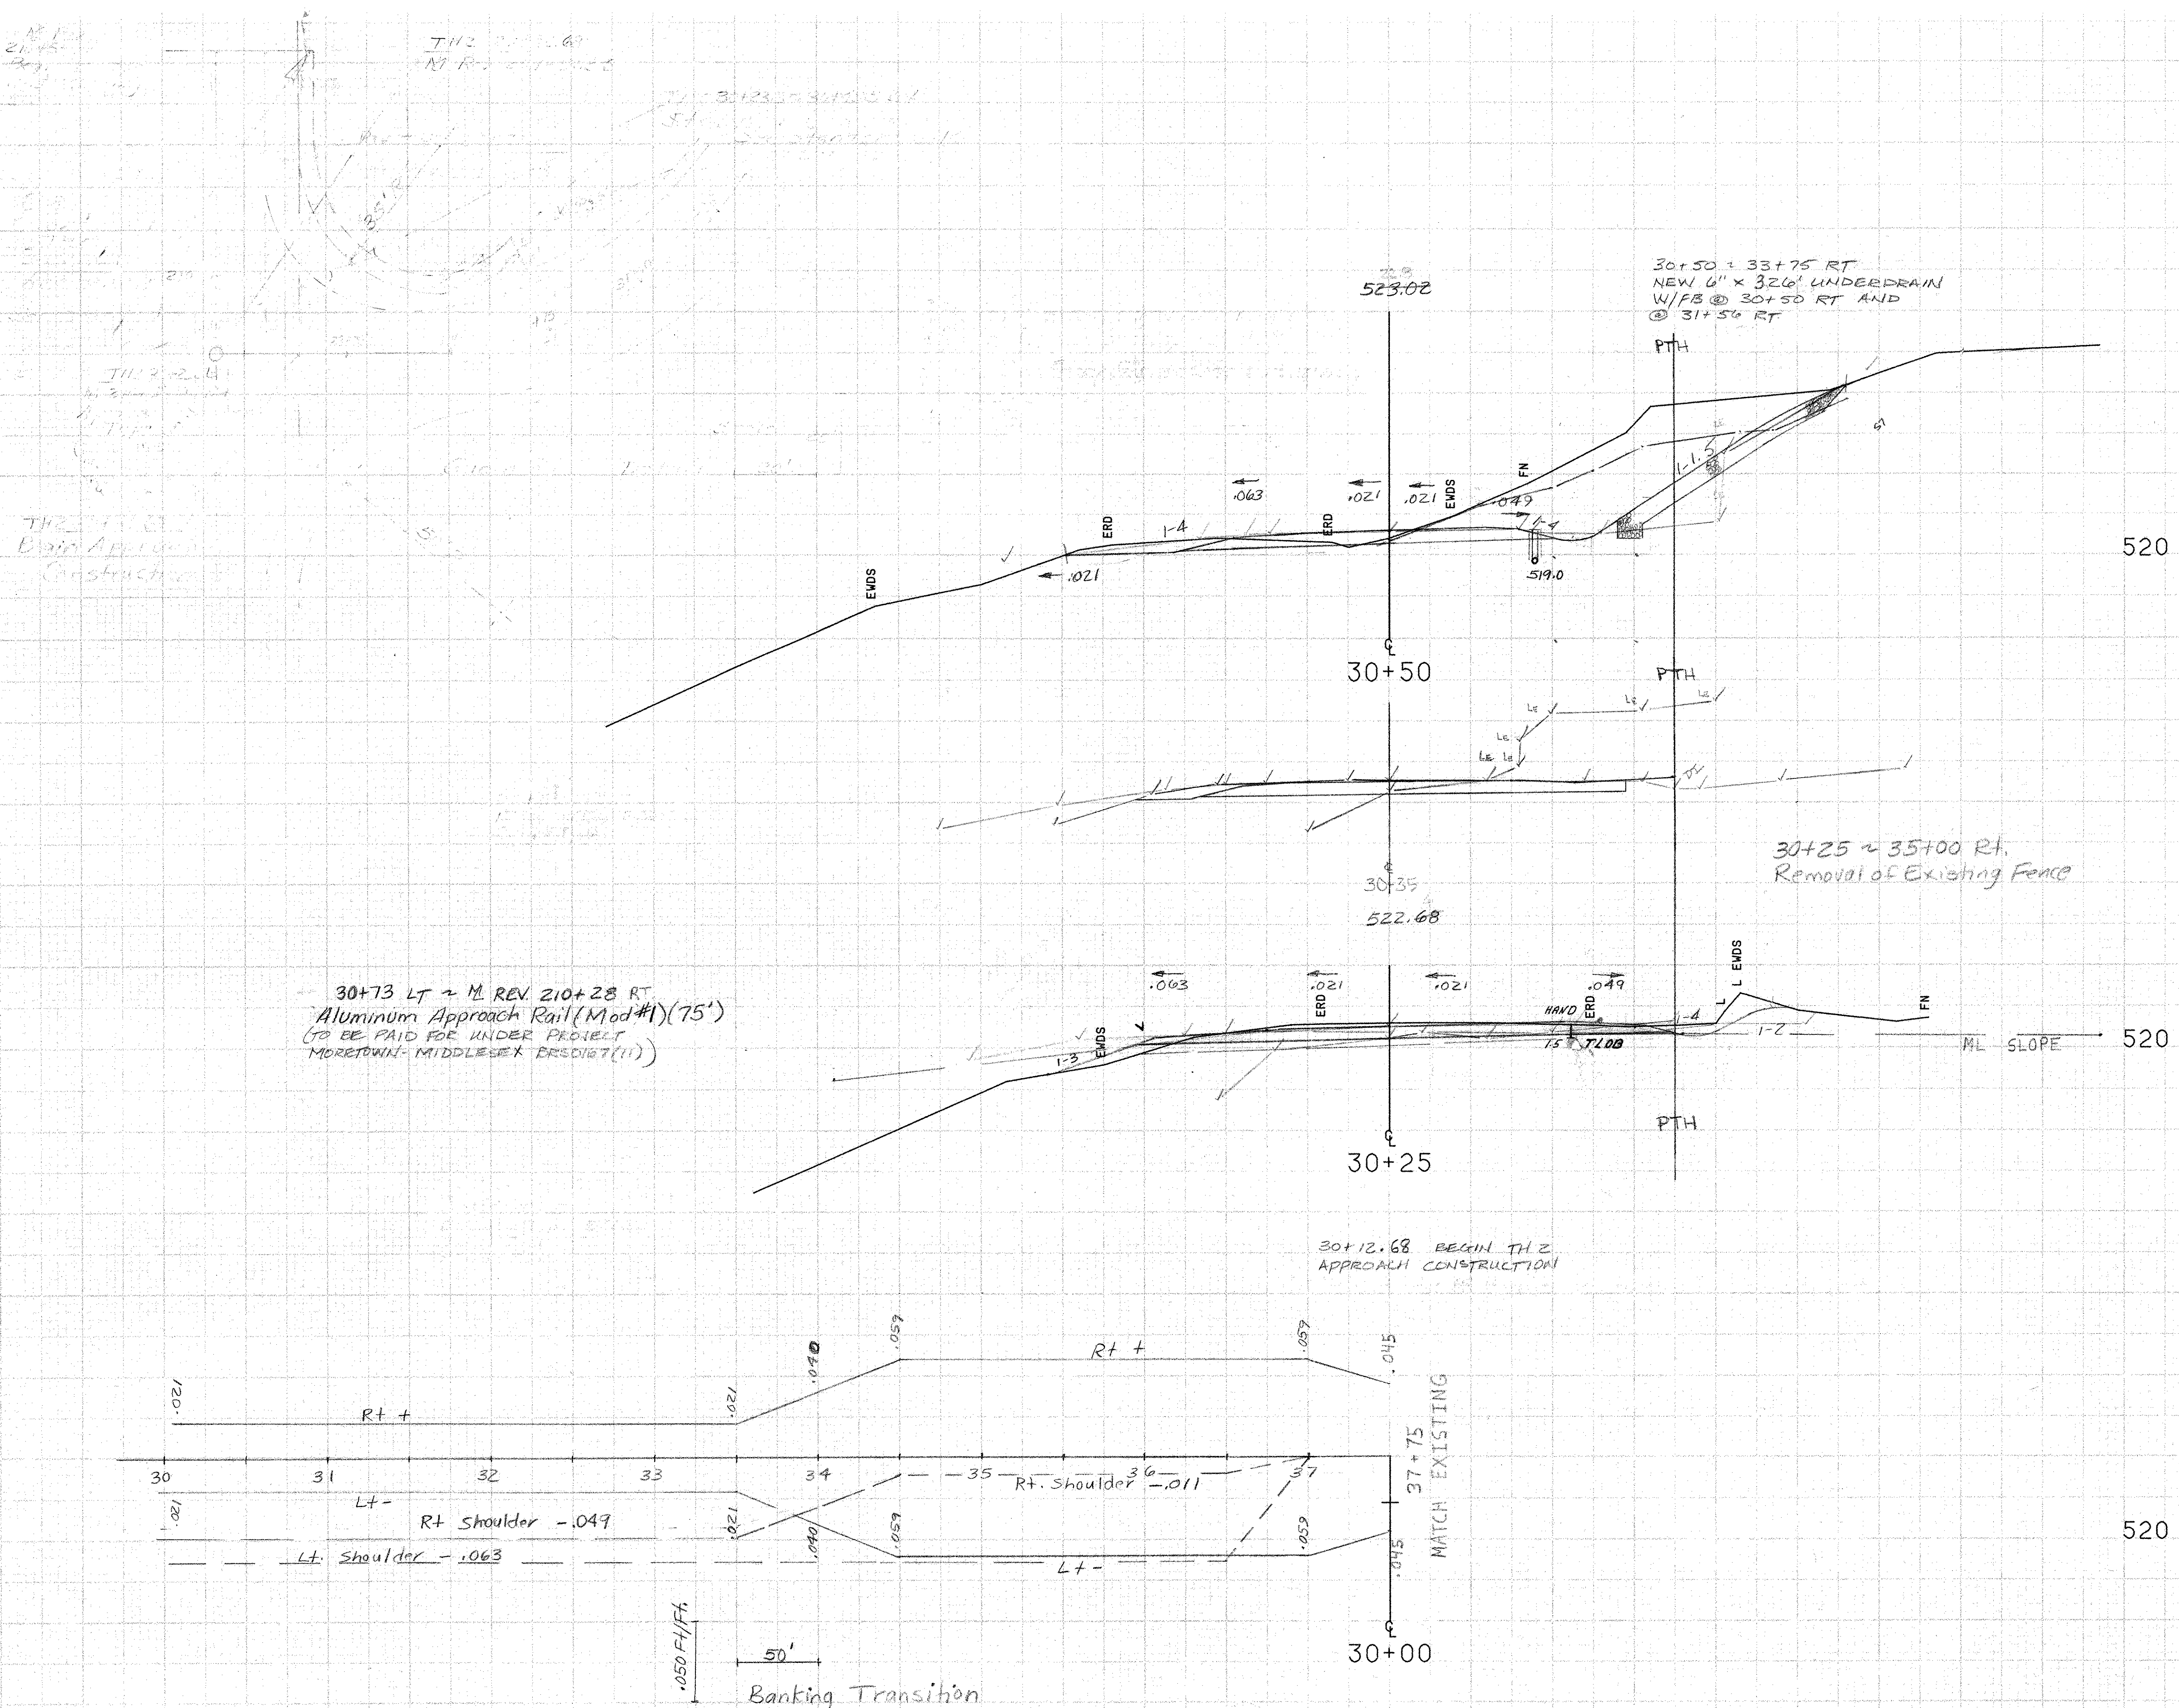


30+73 LT ~ M. REV. 210+28 RT
 Aluminum Approach Rail (Mod #1) (75')
 TO BE PAID FOR UNDER PROJECT
 MORETOWN - MIDDLESEX BRIDGE (11)

30+50 ~ 33+75 RT
 NEW 6" x 320' UNDERDRAIN
 W/FB @ 30+50 RT AND
 @ 31+56 RT

30+25 ~ 35+00 RT.
 Removal of Existing Fence

30+12.68 BEGIN TH2
 APPROACH CONSTRUCTION

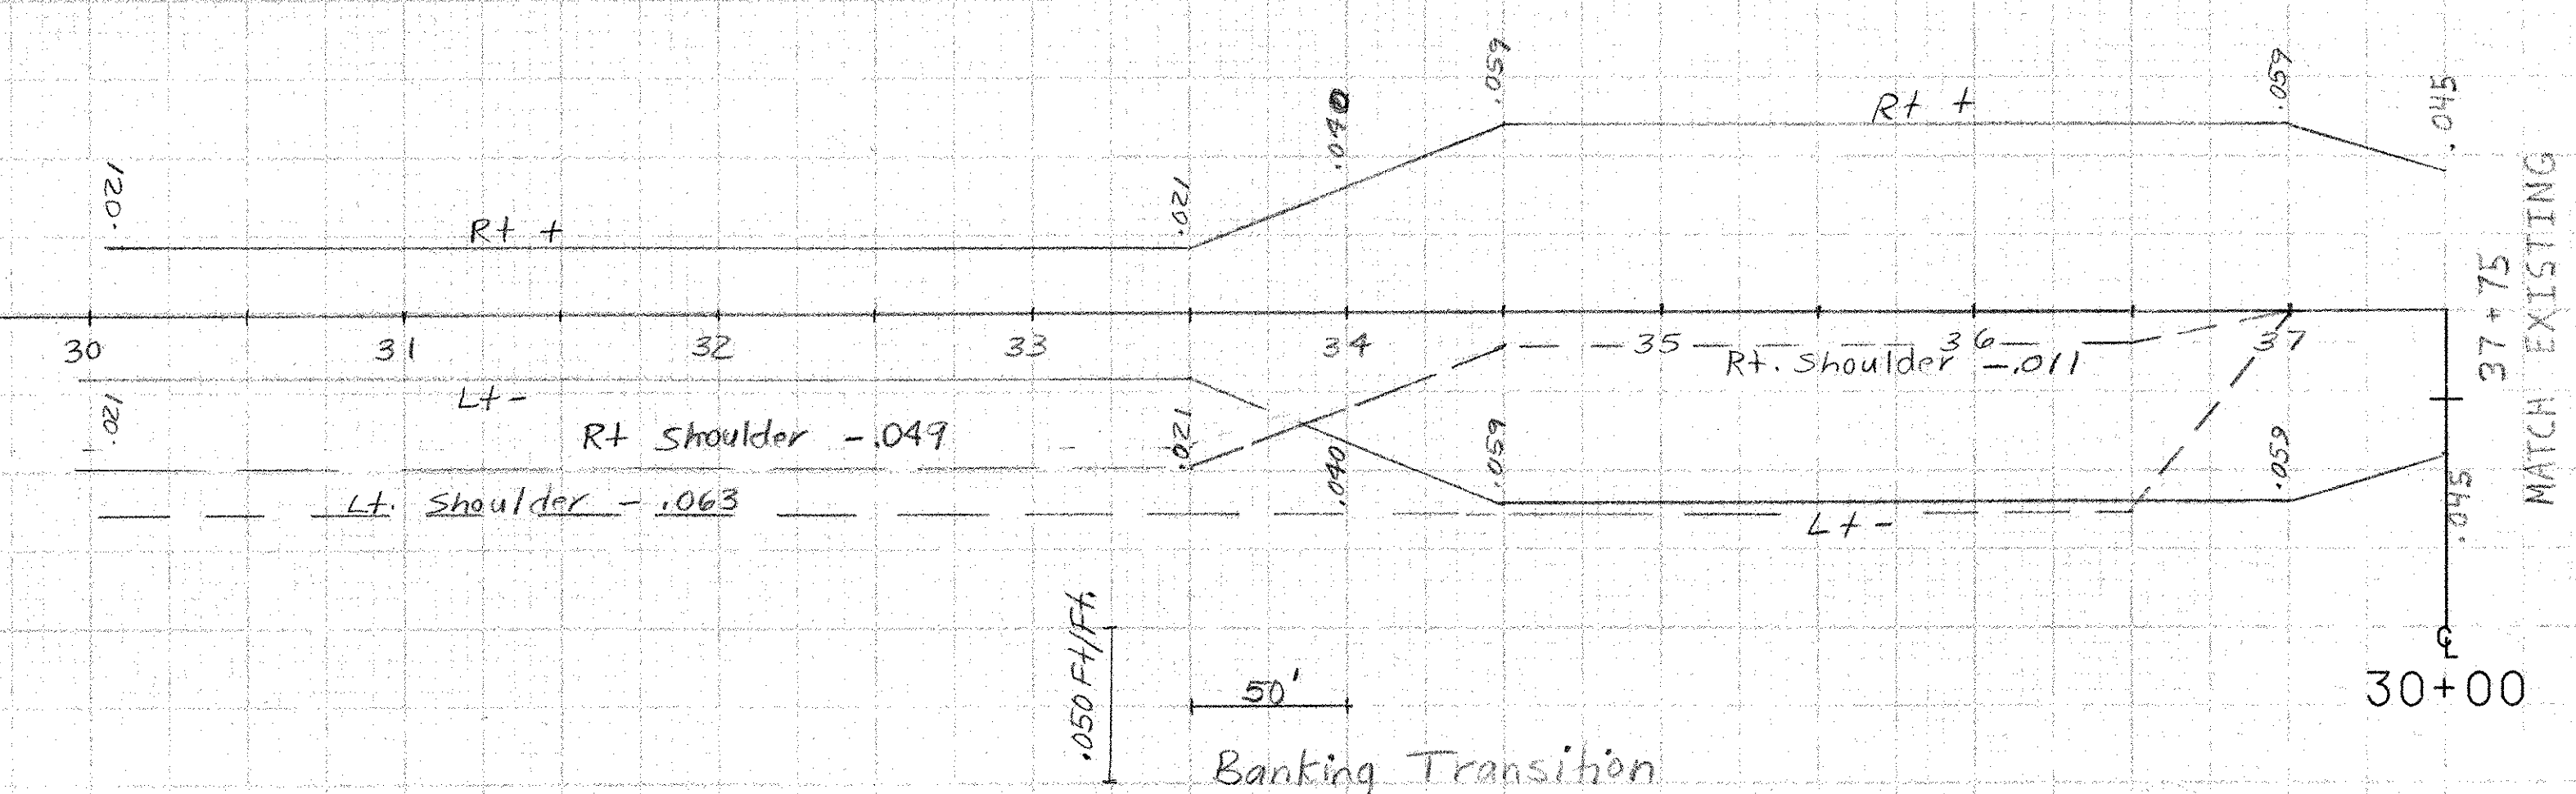

FROM STA.	30+00	TO STA.	30+50
PROJECT NAME	MORETOWN	TH2	
NO.	RS E6	CRS0167 (9)	PLOTTED 06/09/86
SURVEYED BY	NYE	JAN 1985	
SHEET	118	OF 243	SHEETS

SCALE 10 FEET