


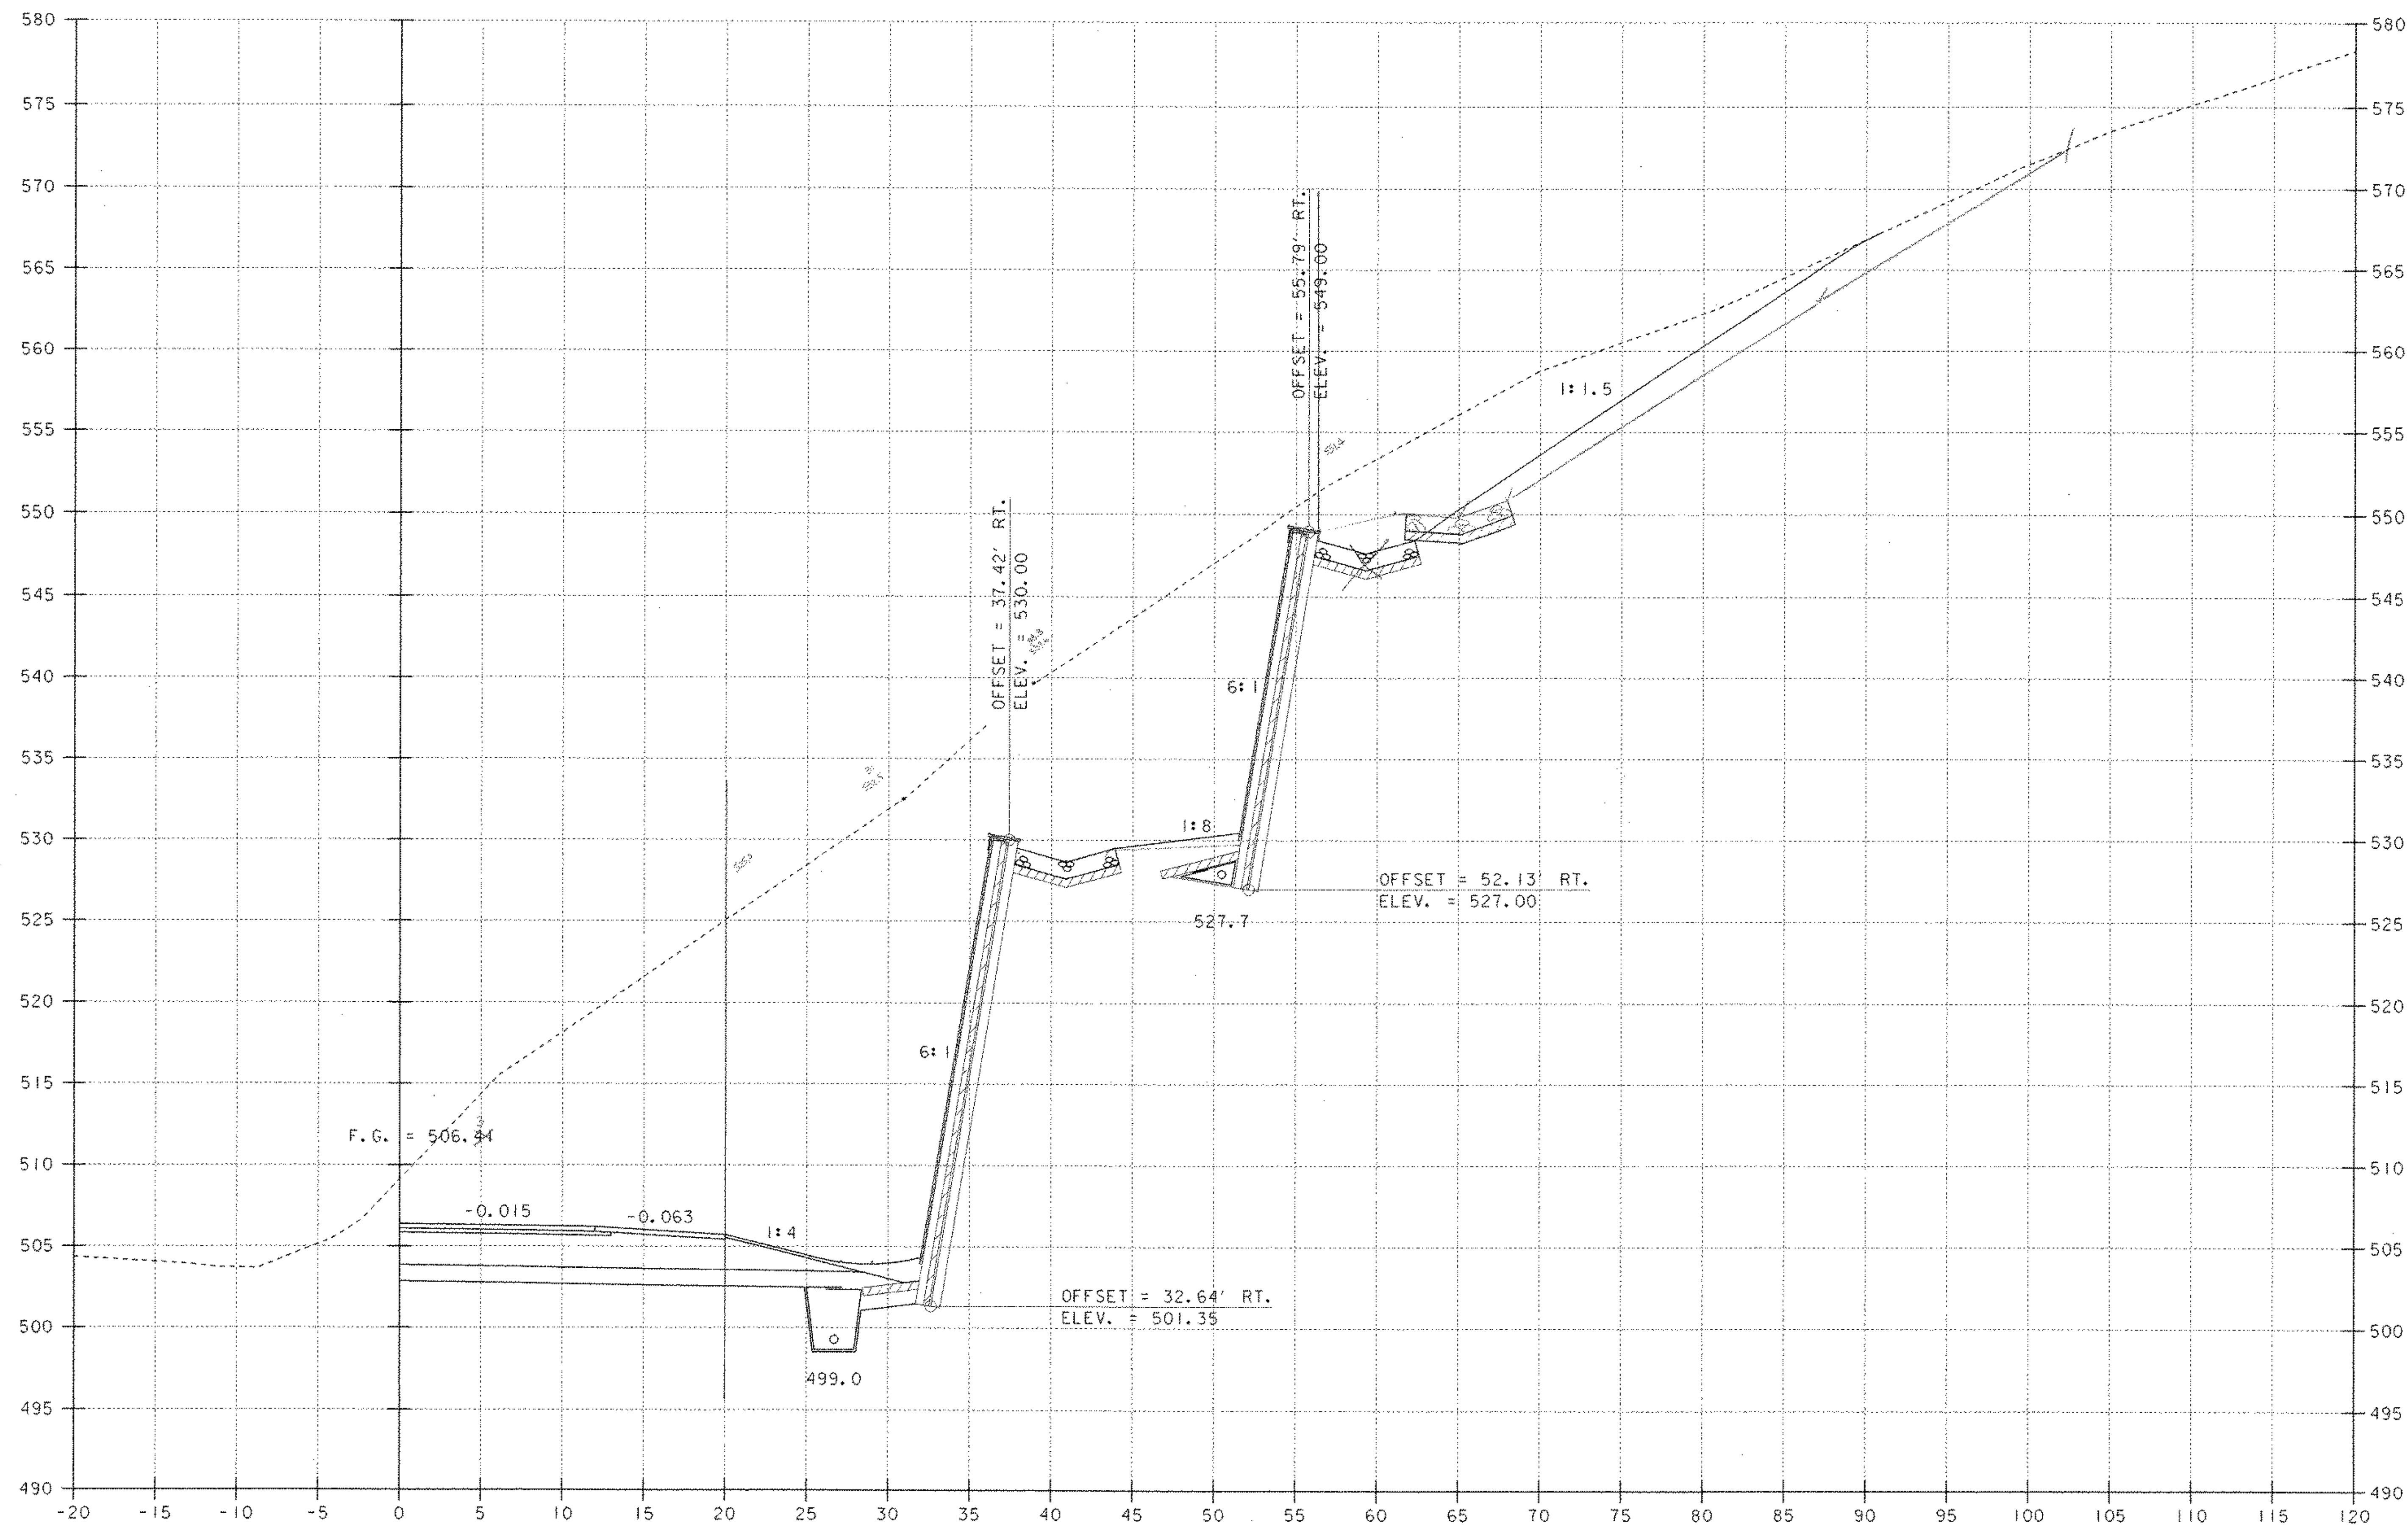

REV. 195+00

SCALE 1" = 5'-0"

PROJECT NAME: MORETOWN
PROJECT NUMBER: STP EGC RSEGC 0167 (9)

FILE NAME: \78el32\Structures\se132+07.J PLOT DATE: 12-MAY-2000
PROJECT LEADER: R.R. WHITCOMB DRAWN BY: G. ROY
DESIGNED BY: C. ALLEN CHECKED BY: C. ALLEN
BRIDGE SHEET BR322 SHEET 1456 OF 243