


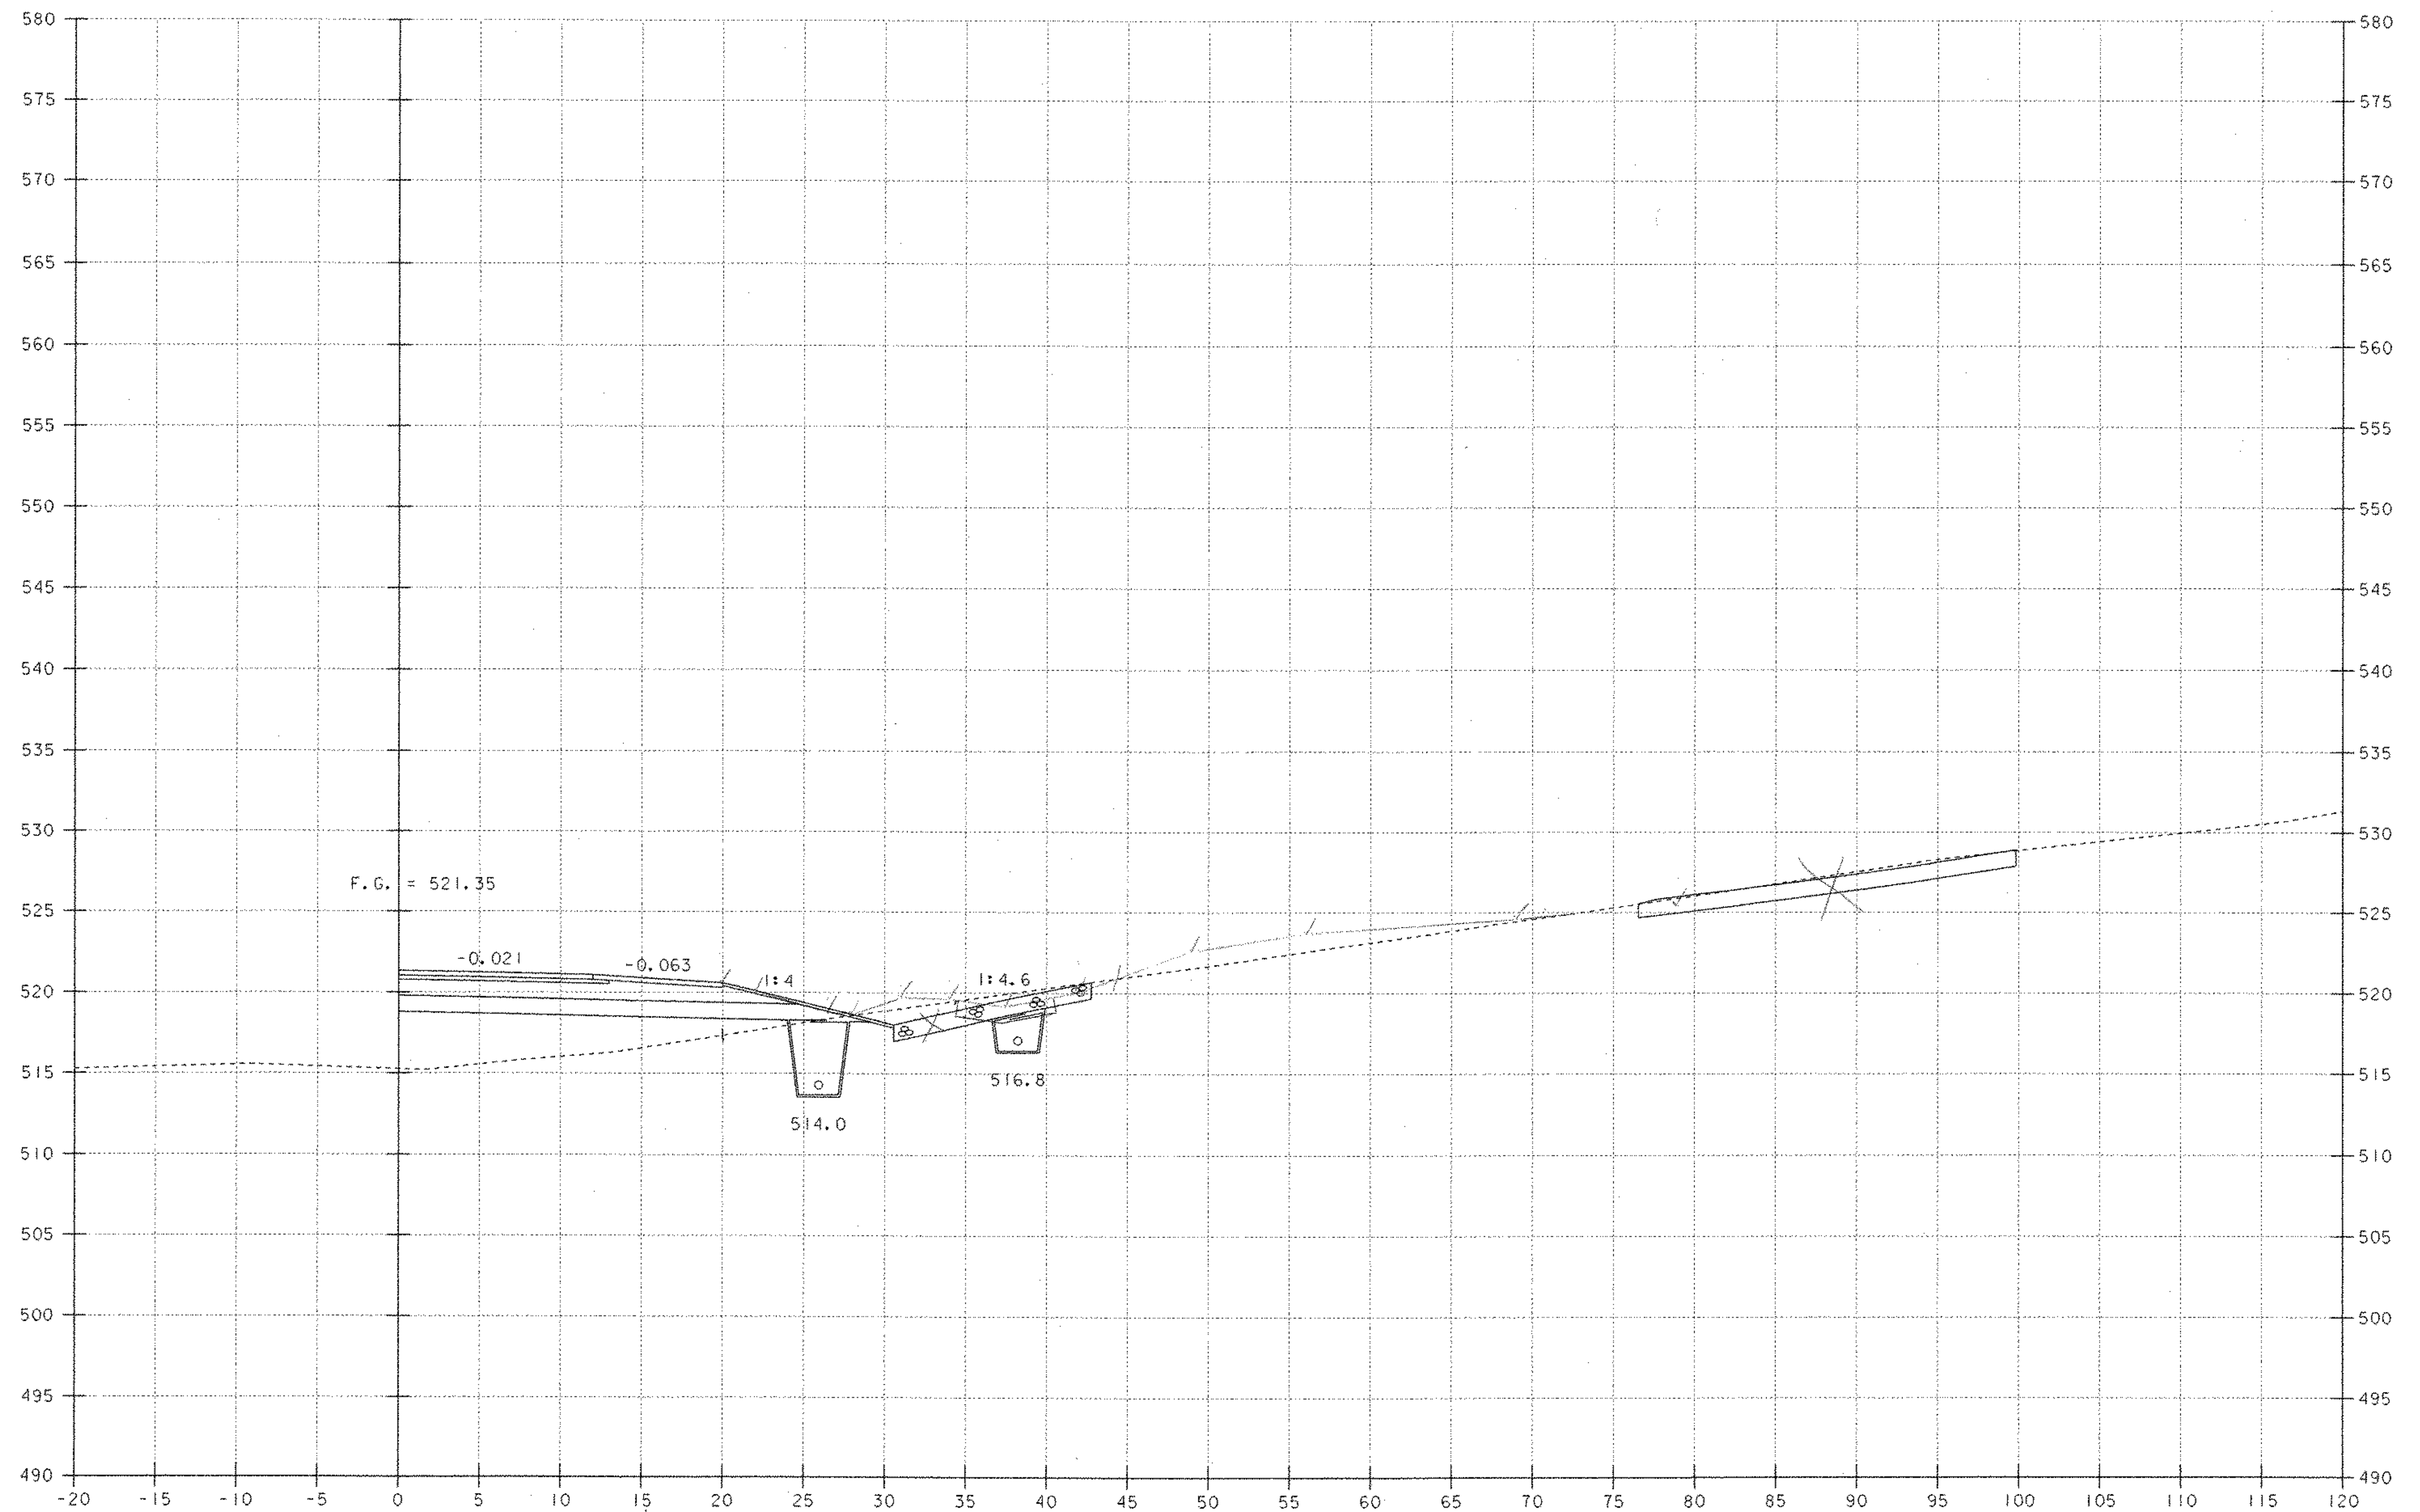

REV. 198+64 RT.  
END STRUCTURE EXCAVATION  
GEOTEXTILE UNDER STONE FILL  
STONE FILL, TYPE 1

REV. 198+50

SCALE 1" = 5'-0"

REV. 198+40 RT.  
END RETAINING WALL NO. 3

|                 |                                |
|-----------------|--------------------------------|
| PROJECT NAME:   | MORETOWN                       |
| PROJECT NUMBER: | STP EGC RSEGC 0167 (9)         |
| FILE NAME:      | \\78e132\Structures\se132+22.1 |
| PROJECT LEADER: | R. R. WHITCOMB                 |
| DESIGNED BY:    | C. ALLEN                       |
| BRIDGE SHEET    | BR337                          |
| PLOT DATE:      | 12-MAY-2000                    |
| DRAWN BY:       | G. ROY                         |
| CHECKED BY:     | C. ALLEN                       |
| SHEET           | 145V OF 243                    |