
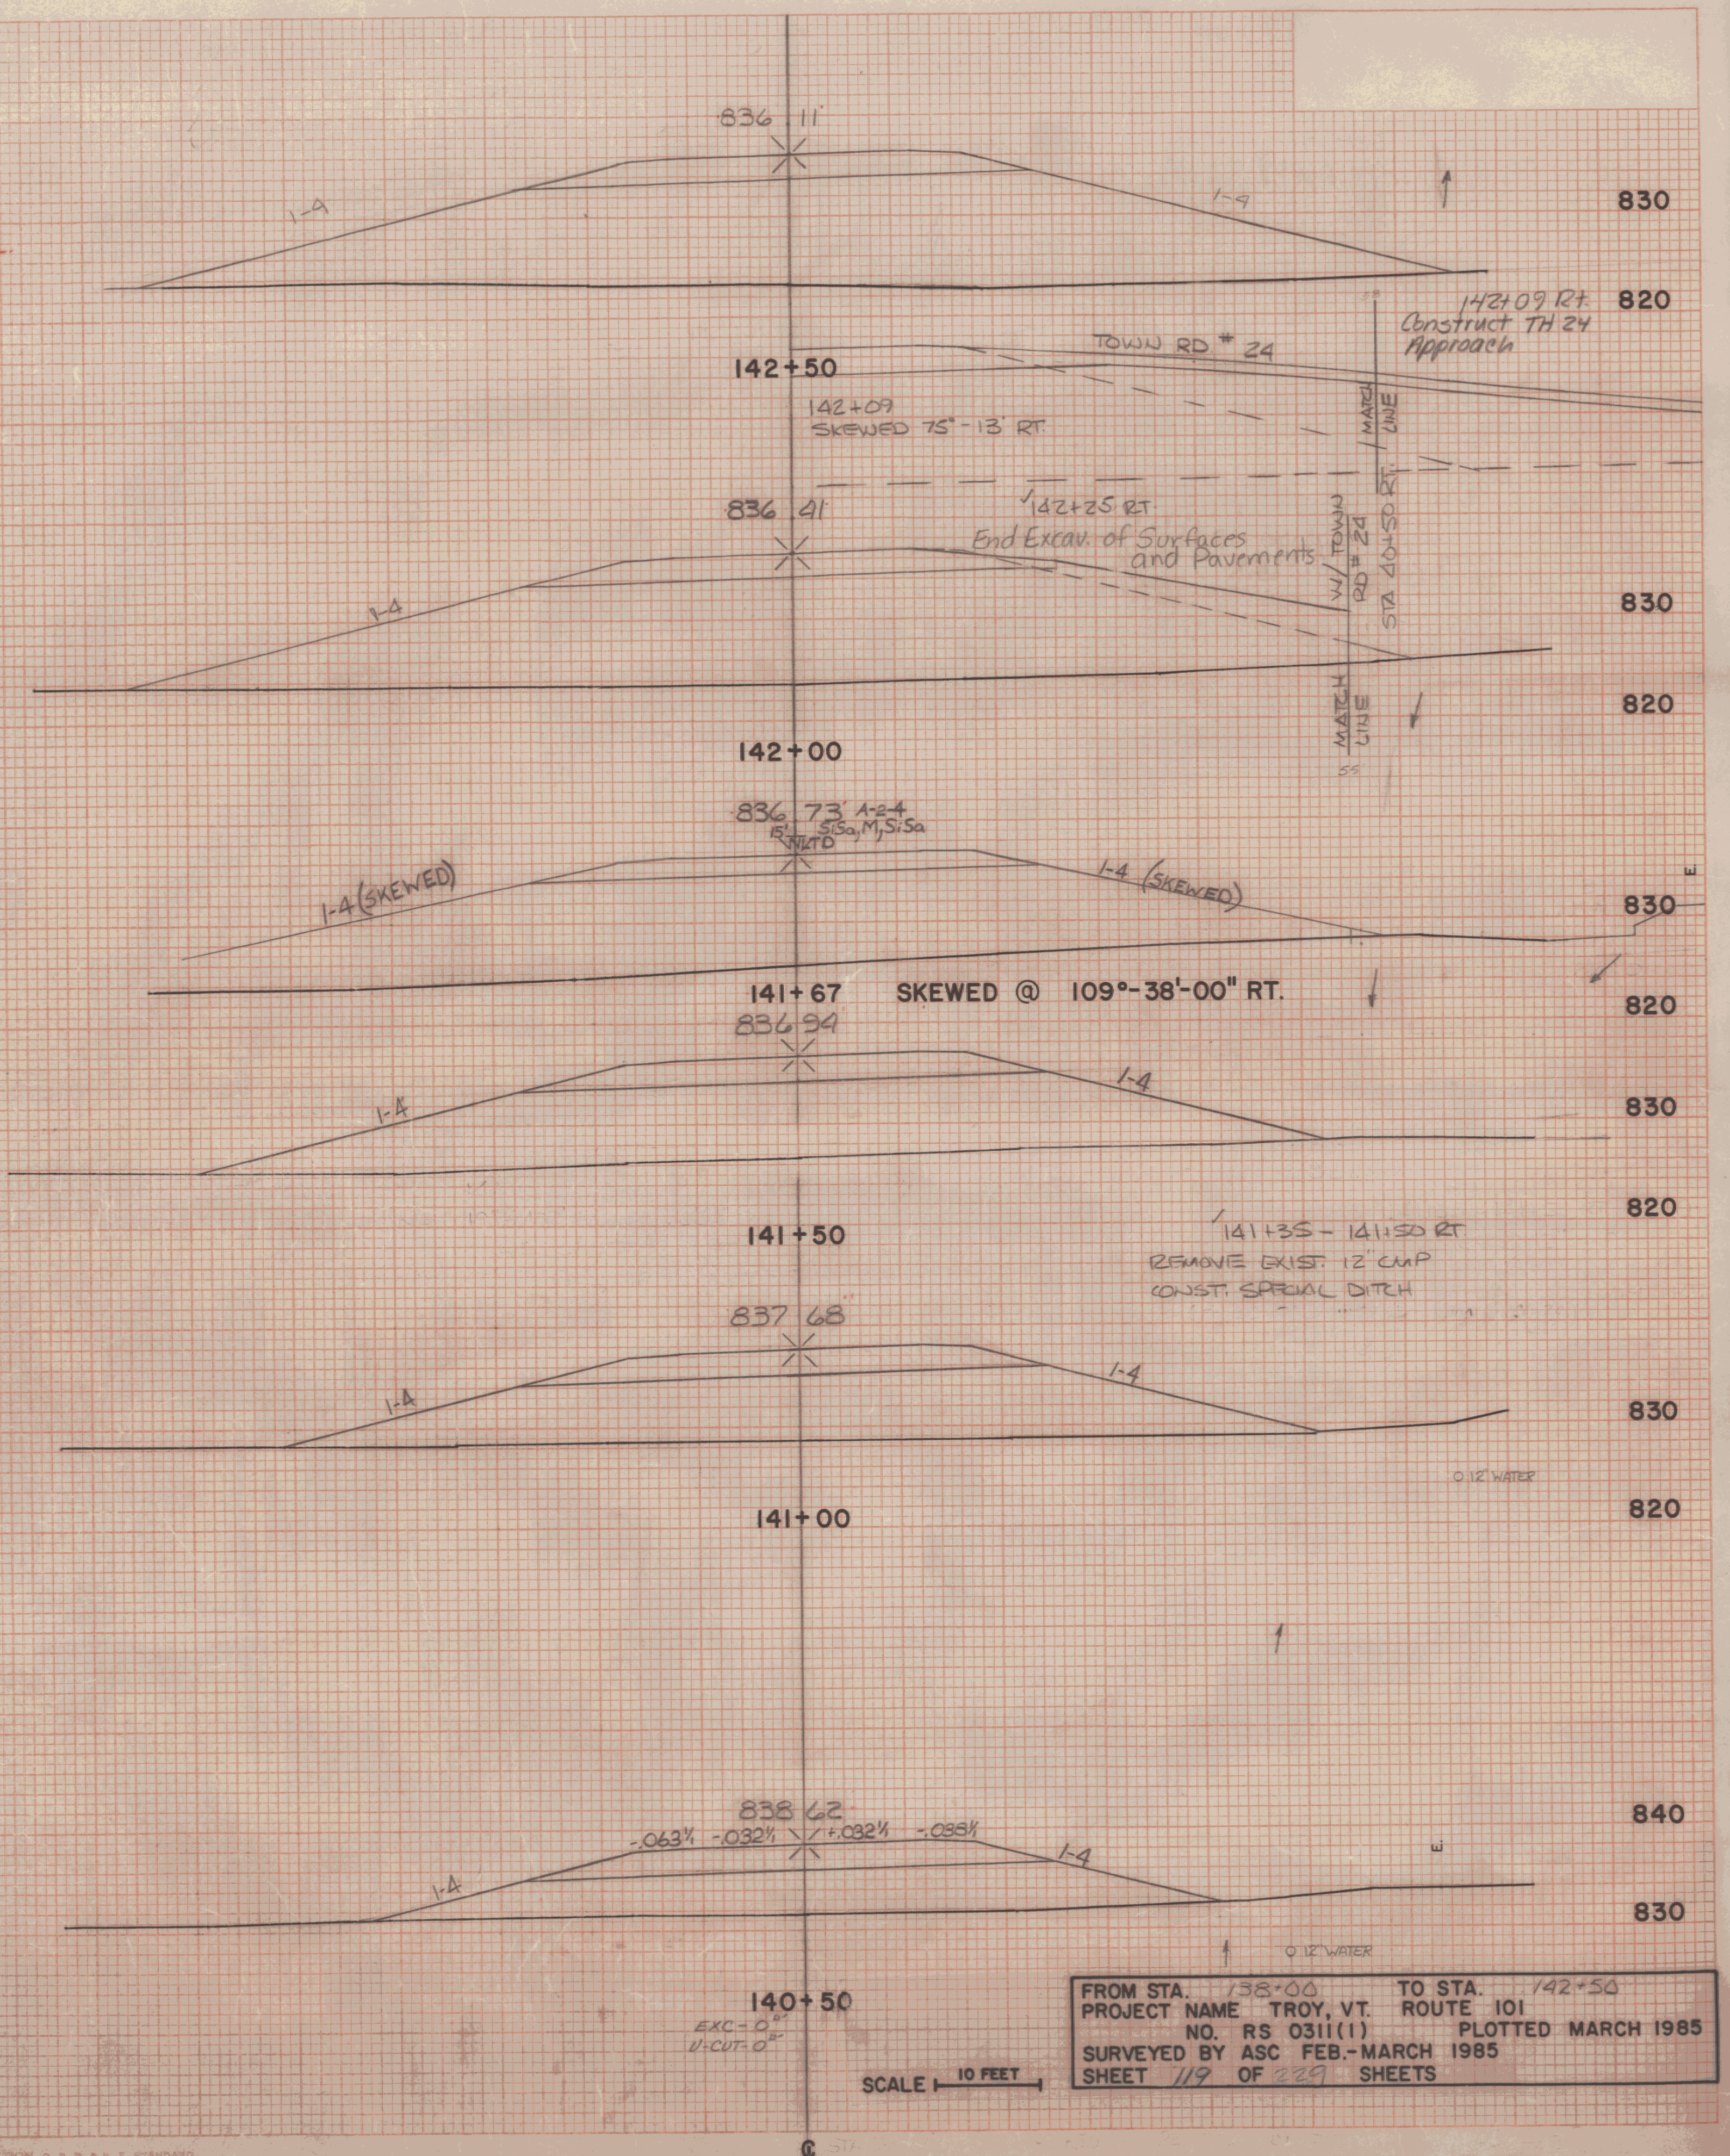


DATE	BY
SURVEYED	
PLOTTED	
NOTE BOOK	
NO.	

DATE	BY
SURVEYED	
PLOTTED	
NOTE BOOK	
NO.	

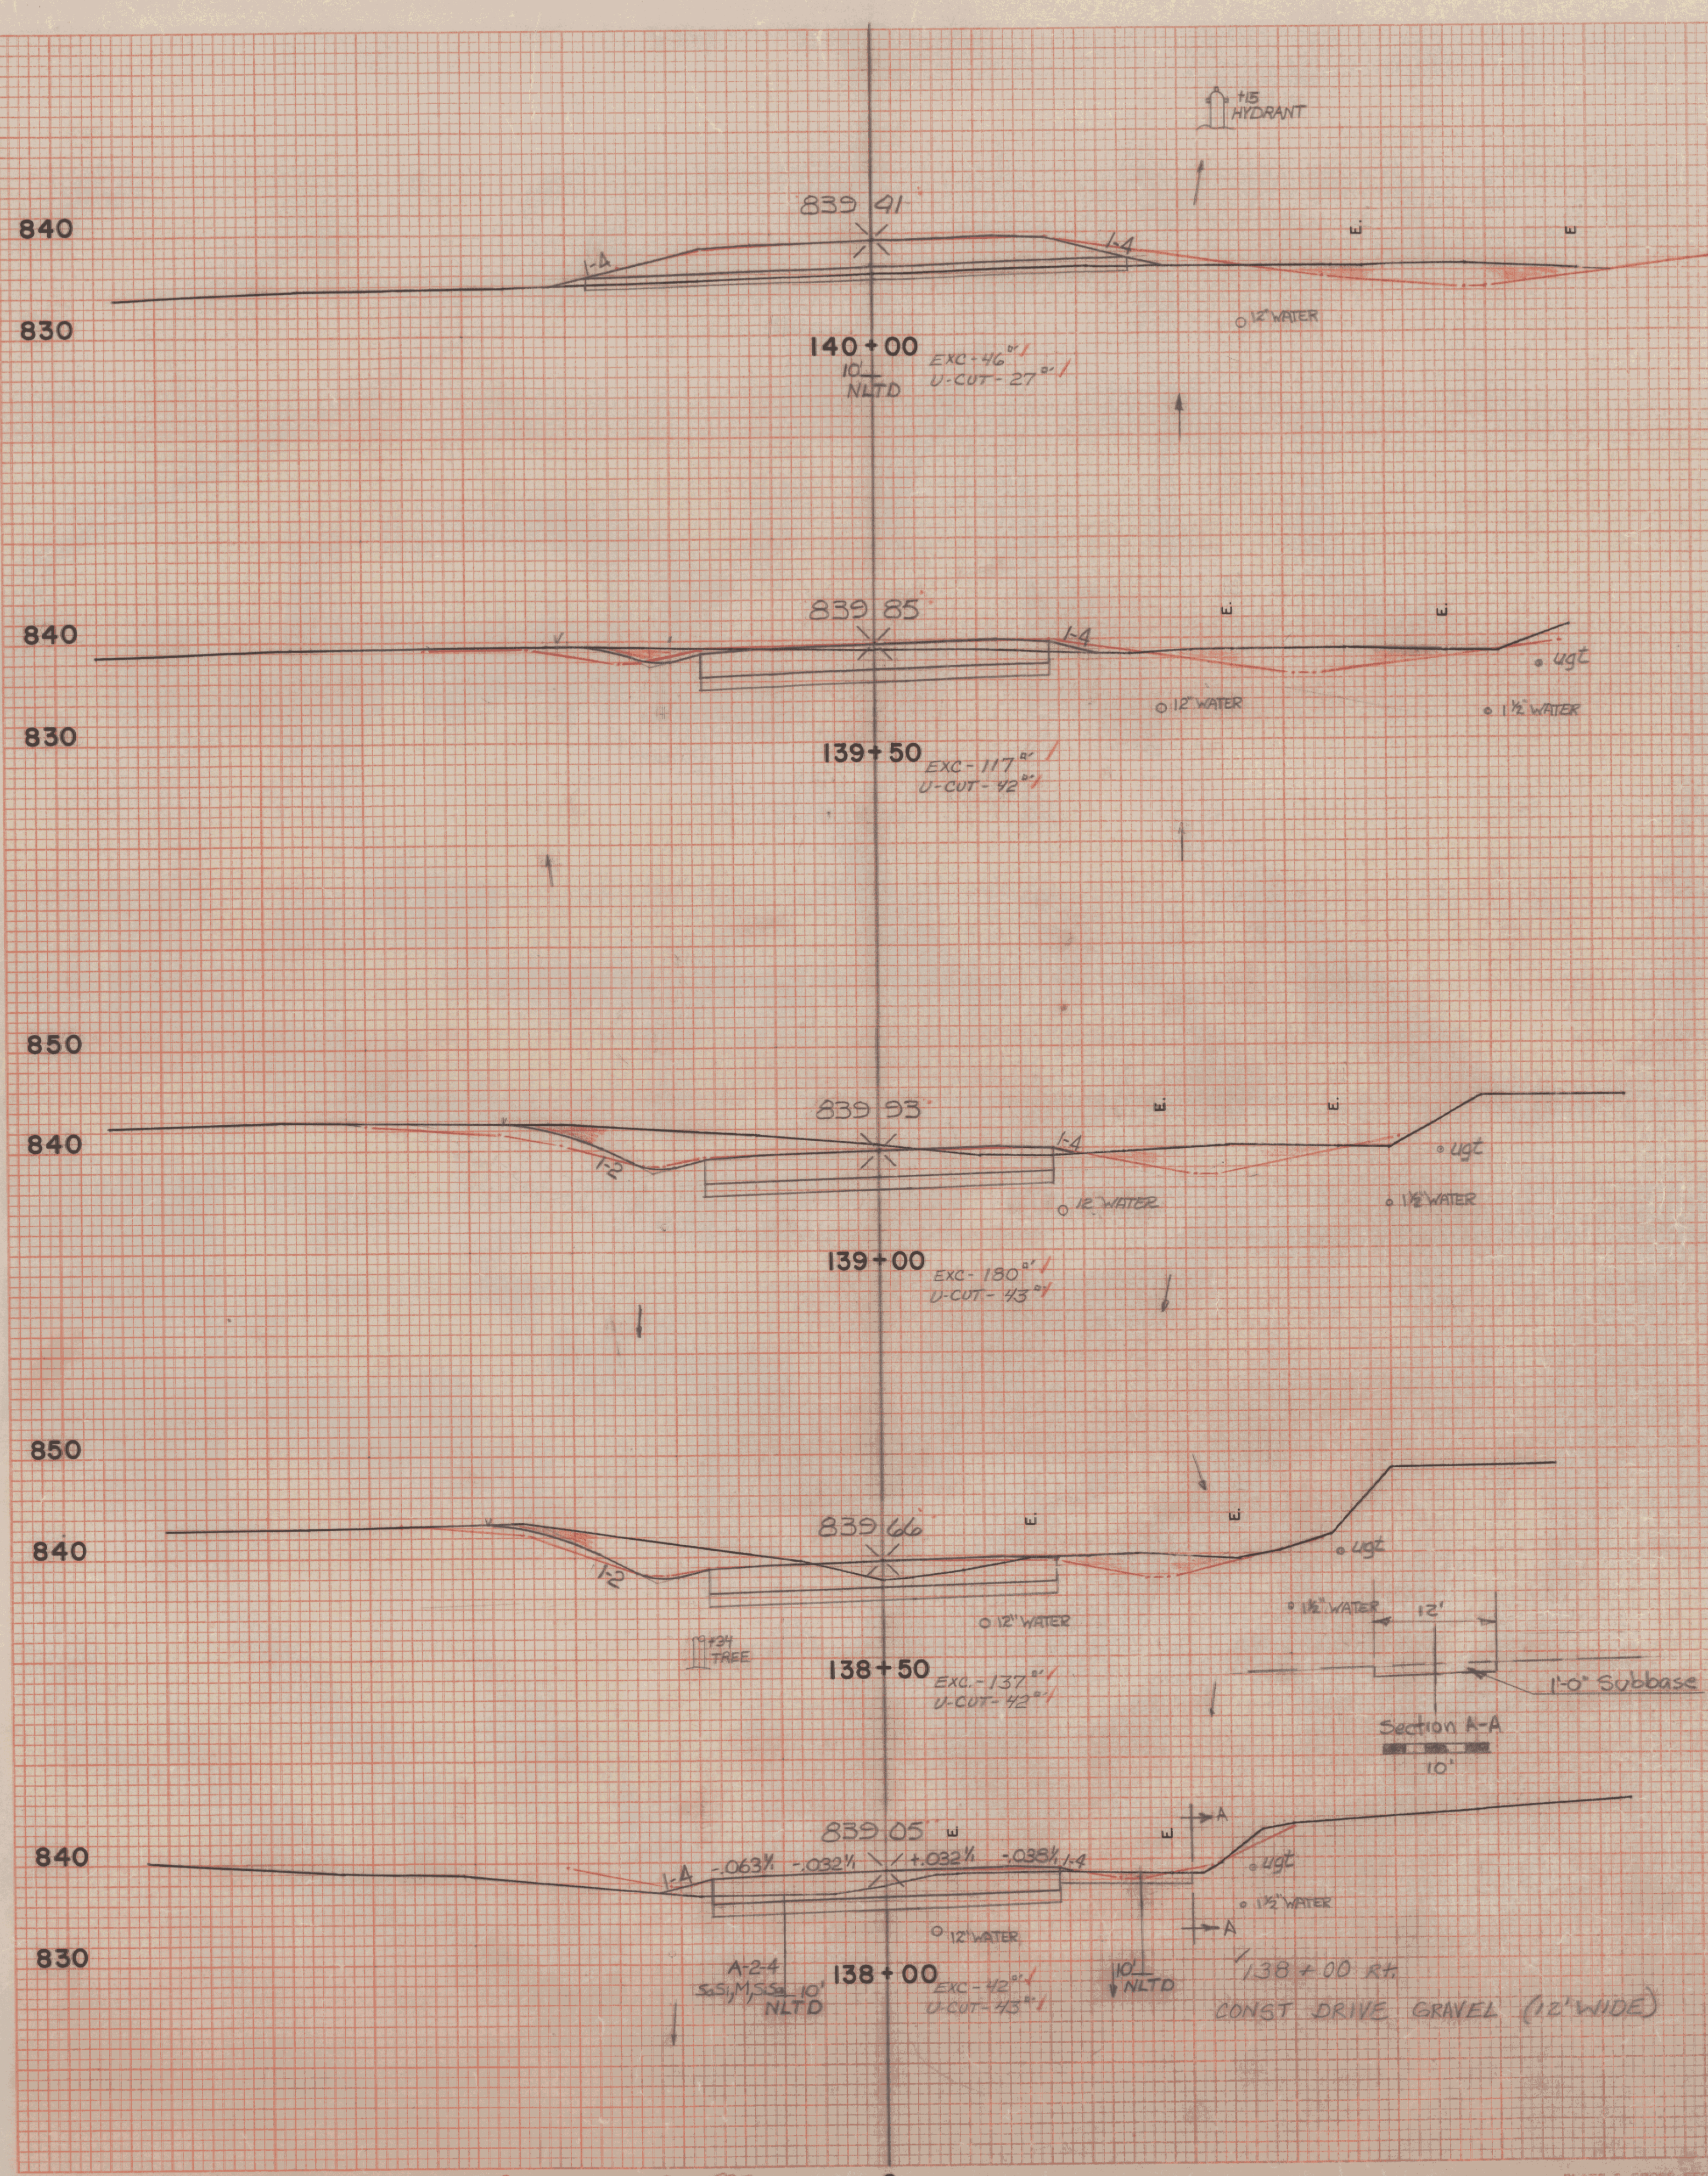

FROM STA. 138+00 TO STA. 142+50
 PROJECT NAME TROY, VT. ROUTE 101
 NO. RS 0311(1) PLOTTED MARCH 1985
 SURVEYED BY ASC FEB.-MARCH 1985
 SHEET 119 OF 229 SHEETS

SCALE 10 FEET

PLOTTED 11-26-91 LEM
 PLANIMETERED 1-8-92 JEM
 PLAN 1-21-92 LEM

PLATE 5 CROSS SECTION OF ROAD E. WINDING