


ORIGINAL SURVEY		BY	DATE
SURVEYED			
PLOTTED			
TEMPLATE			
AREAS			

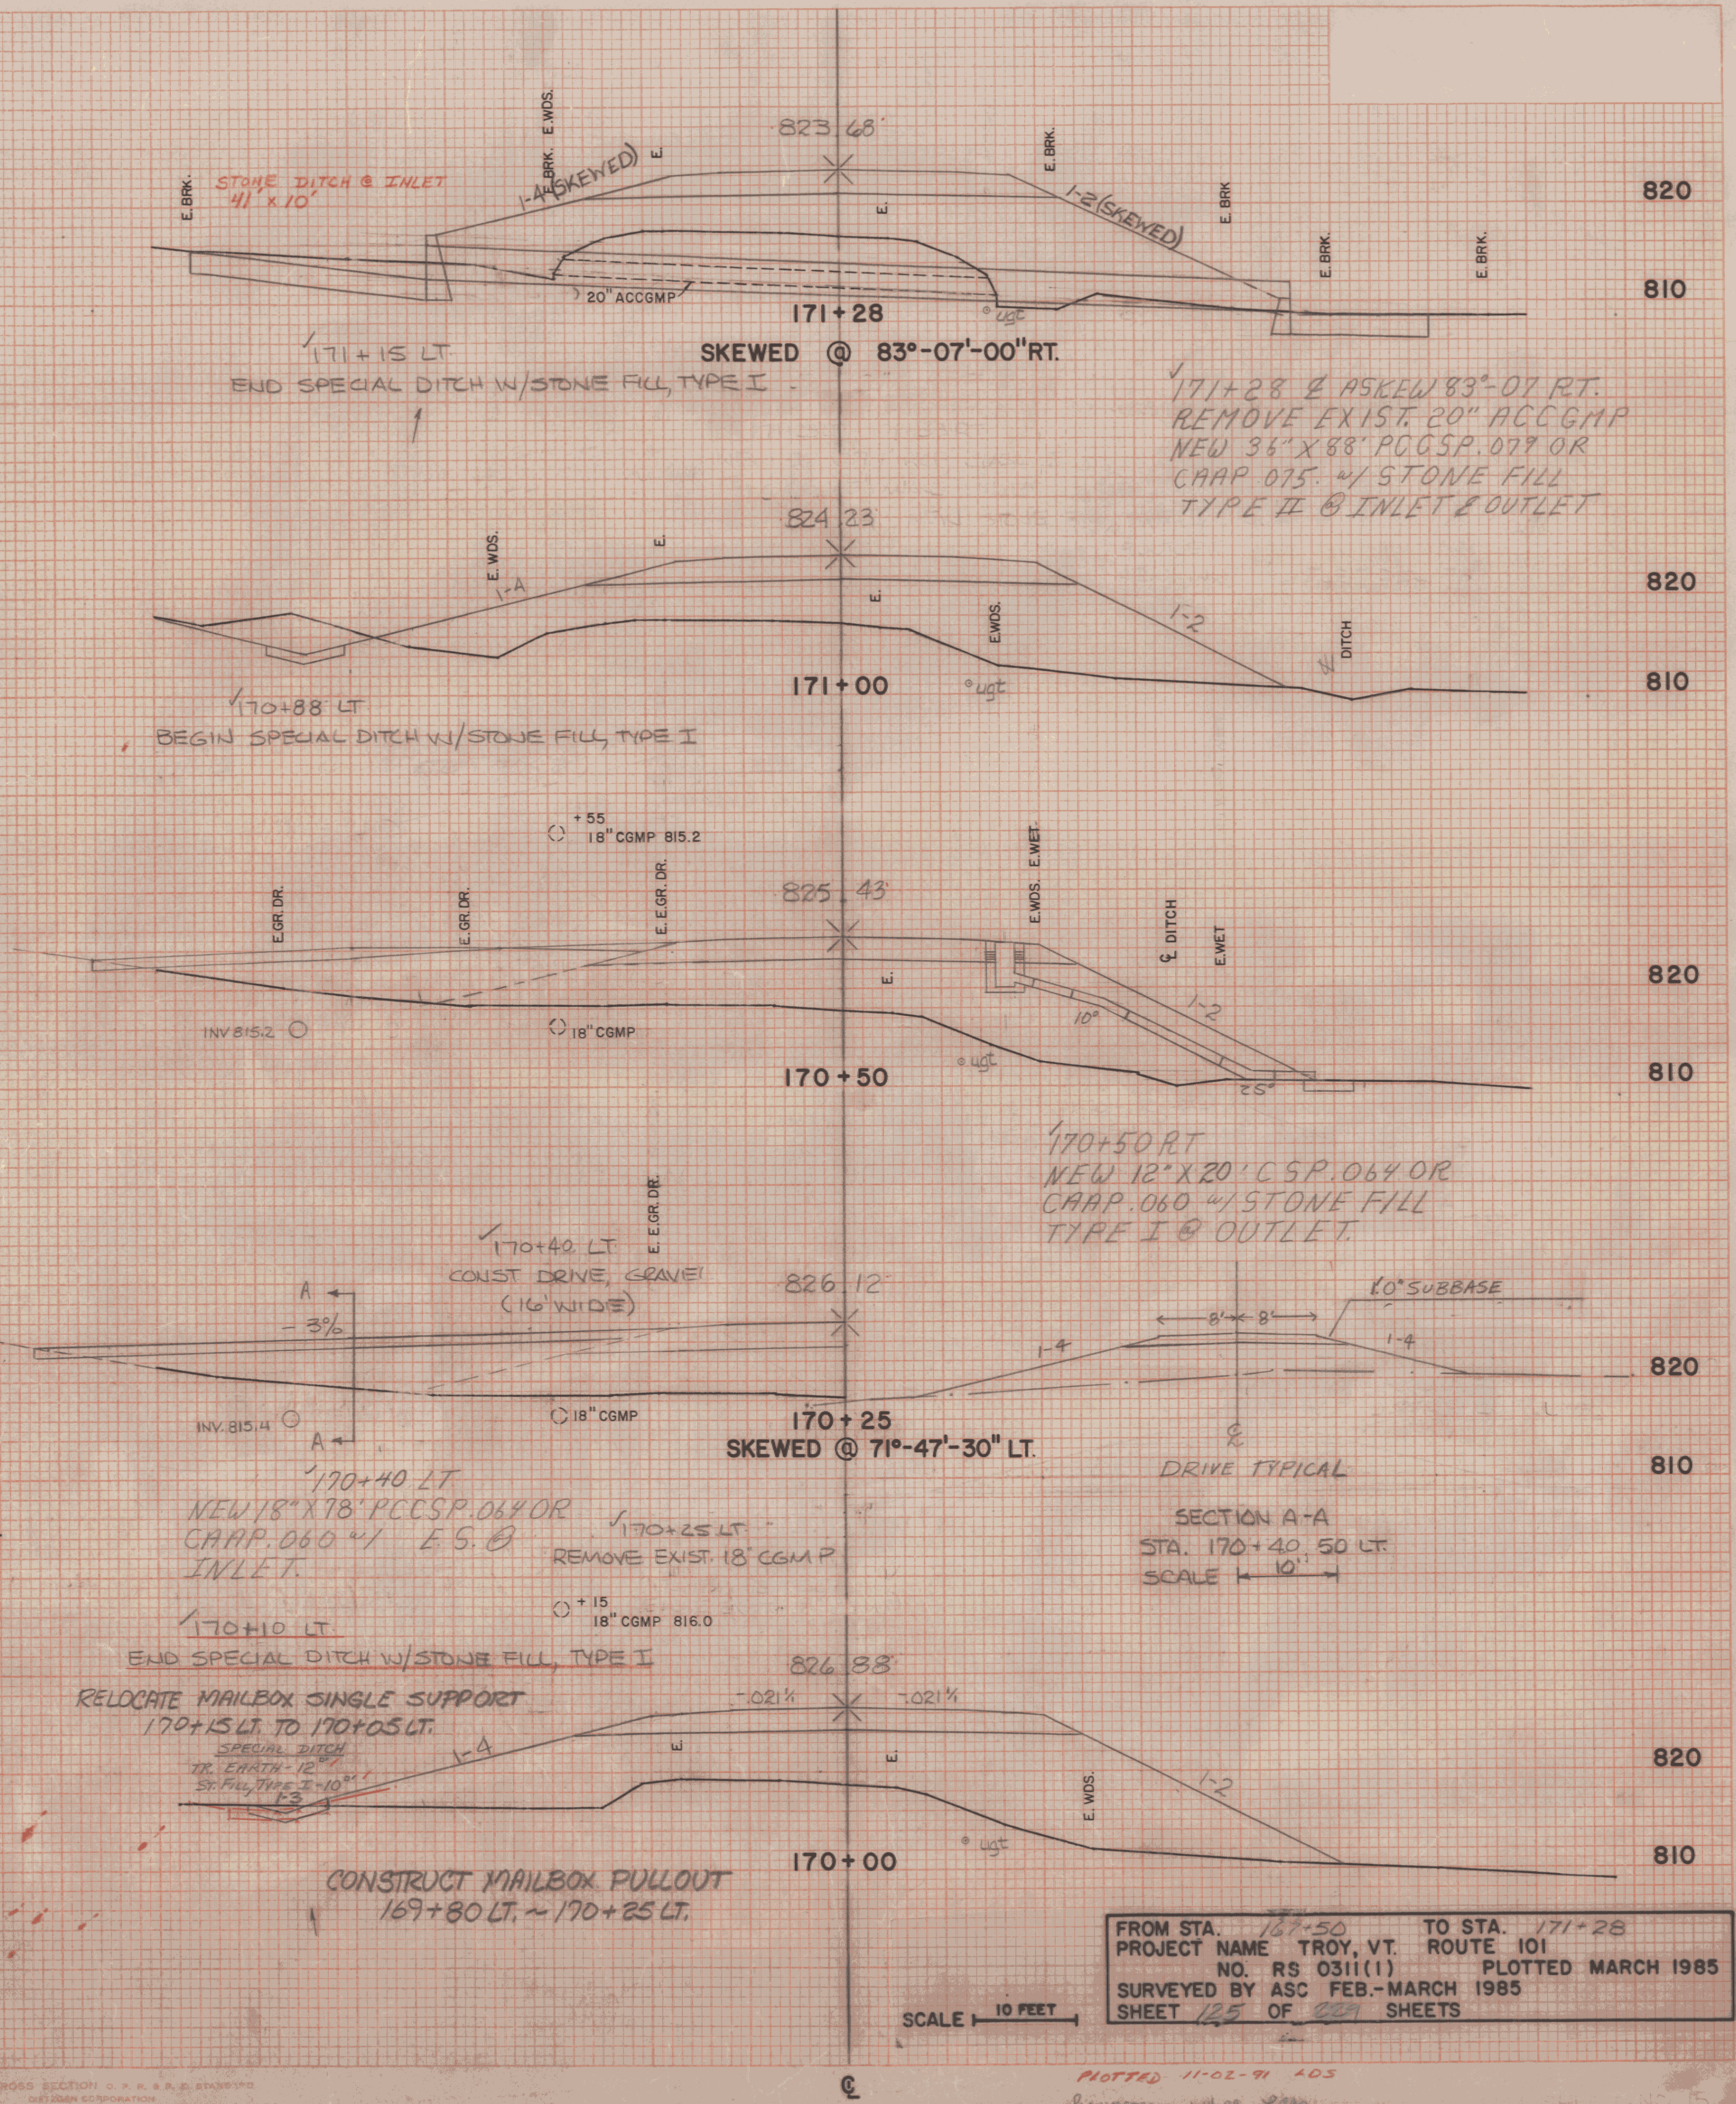

FROM STA. 167+50 TO STA. 171+28
PROJECT NAME TROY, VT. ROUTE 101
NO. RS 0311(1) PLOTTED MARCH 1985
SURVEYED BY ASC FEB. MARCH 1985
SHEET 125 OF 334 SHEETS

SCALE 10 FEET

PLOTTED 11-02-91 LOS

[Faint handwritten text at the bottom of the page]